153A

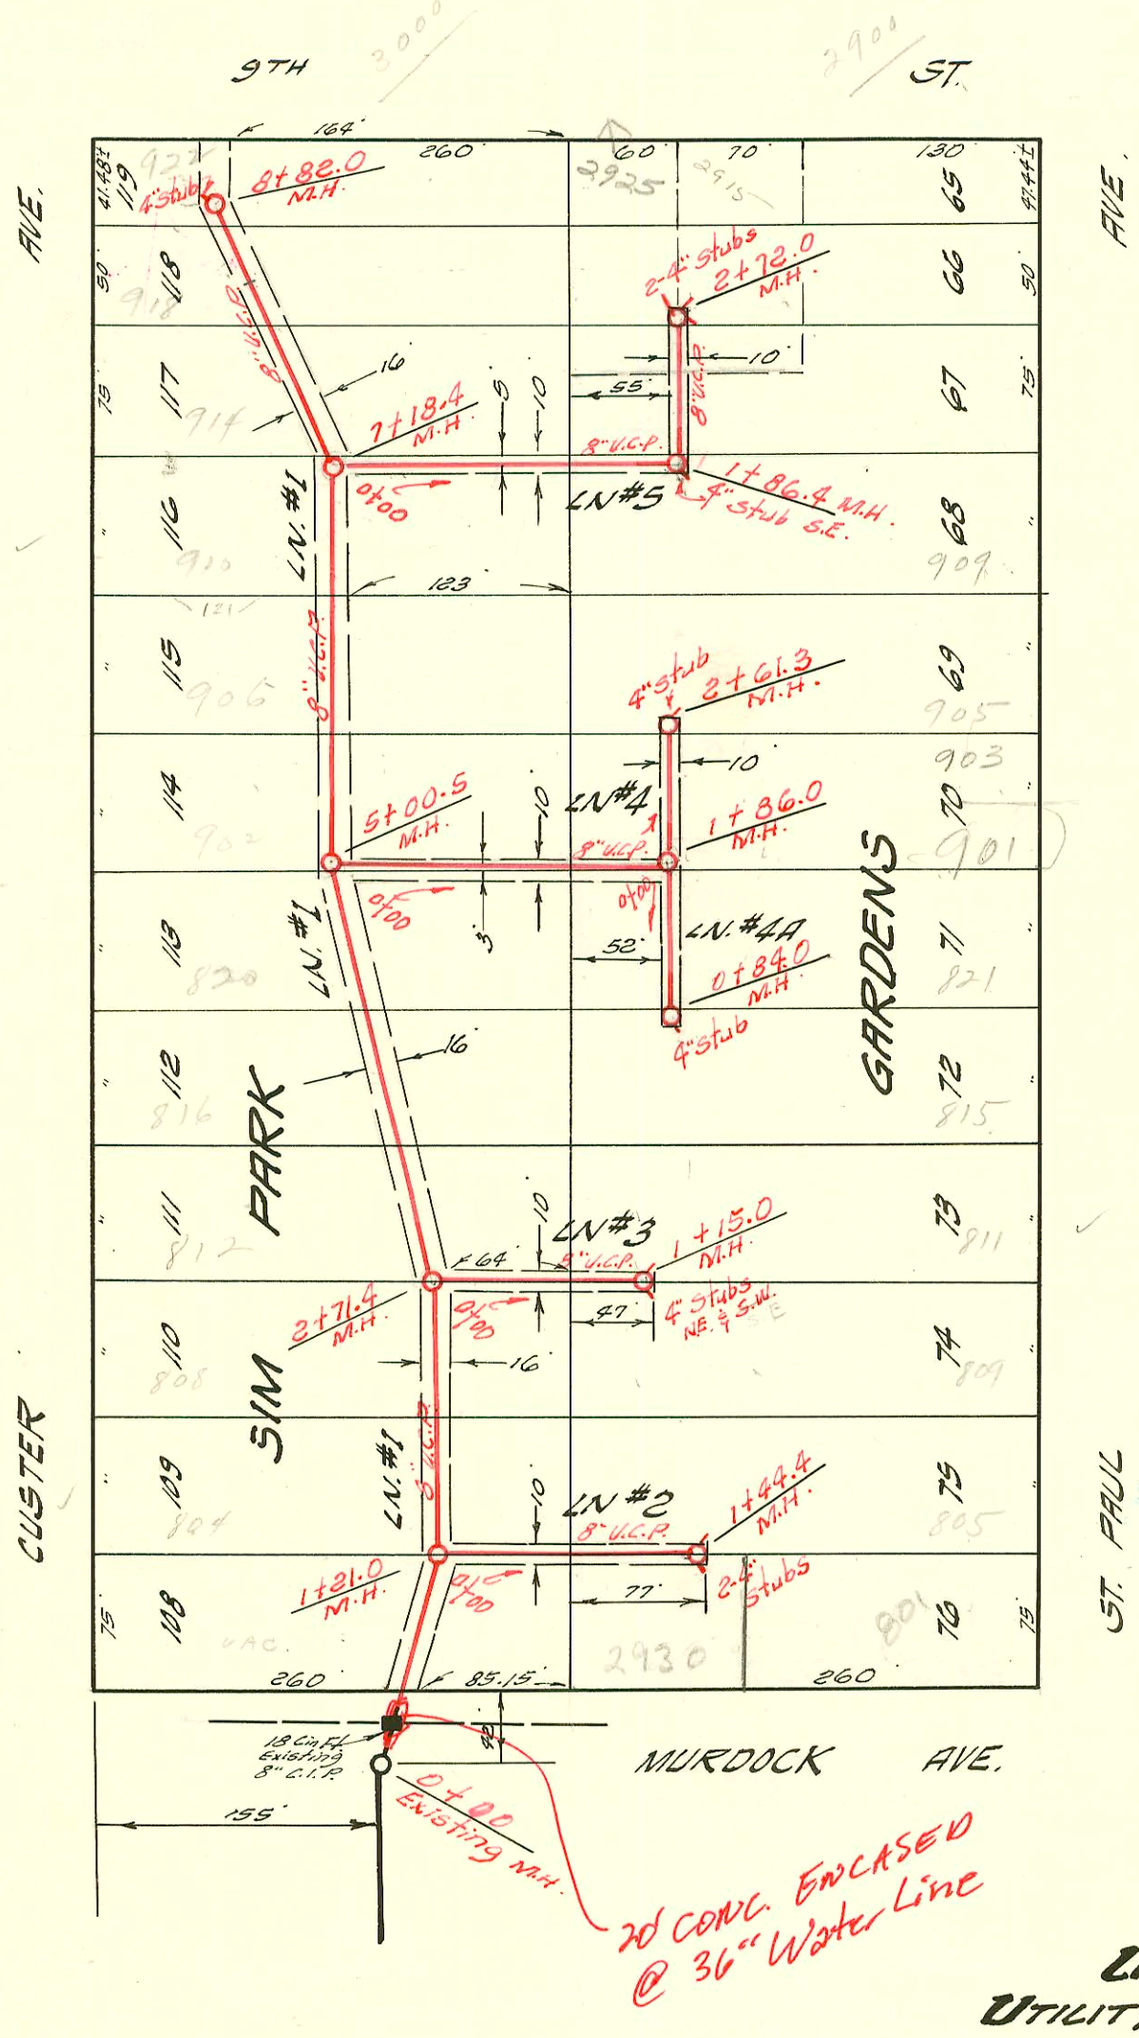

LATERAL 44 S.S. 22

UTILITY CONTRACTORS INC. 11-17-60

BK. NO. K-51 PROJ. NO. C27-30

153

Form 41-(54) 7-60

	CONSTRUCTION RECORD							SERVICE RECORD					
	STATION	ELEVATION Ground	ELEVATION Grade	Depth	MANHOLE	4-INCH "Y" BRANCHES ~~North~~ West	4-INCH "Y" BRANCHES ~~South~~ East	No. of Permit North West	No. of Permit South East	House Number North West	House Number South East	DATE OF PERMITS North West	DATE OF PERMITS South East
LN #1	0+00	118.54	109.80	8.7	Existing MH.								
						+54.0							
	1+00	119.6	110.00	9.6									
		119.6	OUT 110.04 / IN 110.15	9.6 / 9.4	1+21.0								
						+44.0		13767		804 N. Custer		1-13-61	
	2+00	119.1	110.20	8.9									
						2+15.1 TAP ~~2+01.0~~		23066		808 N/C N Custer		5-2-89	
		118.7	110.34	8.4	2+71.4			97-21-21-67 / 96-10-51				12-1-90	
						2+98.0		13566		~~812~~ N. Custer		8-21-8 / 11-22-60	
	3+00	119.5	110.40	9.1									
						~~+58.5~~ ~~+64.0~~		B4210		816 N. Custer		9-28-65	
	4+00	119.2	110.60	8.6									
						+39.0	+37.0						
						~~+71.3~~ +69.3		C6958		820 N. Custer		2-20-68	
	5+00												
		119.2	OUT 110.80 / IN 110.90	8.4 / 8.3	5+00.5								
							+11.4						
						+54.0		13653		902 N. Custer		11-29-60	
						+87.0	+89.0	13567		906 N. Custer		11-22-60	
	6+00	119.5	111.25	8.2									
						6+72.4	6+70.4	13724	18140	910 N. Custer	910 N Rear Custer	1-3-61	4-17-87
	7+00	121.8	111.45	10.3									
		121.0	111.49	9.5	7+18.4								
						+52.0		#13481		914½ N. Custer		10-31-60	
						+85.0	+83.0	#13480		914 N. Custer		10-31-60	
	8+00	122.5	111.65	10.8									
							+19.3						
						8+35.0		#13482		918 N. Custer		10-31-60	
							+55.0						
		121.6	111.82	9.8	8+82.0	4" stub N.W.		C17983		922 N. Custer		2-13-70	
LN #2	0+00	118.6	110.40	8.2	Existing MH.								
						+20.7	+22.7						
						+82.0							
	1+00	120.0	110.60	9.4									
							+18.5		13815		293 OW Murdock		1-30-61
		120.0	110.69	9.3	1+44.4	4" stub N.E. & S.E.		13645	13814	805 N. St. Paul	801 N. St. Paul	11-25-60	1-30-61
LN #3	0+00	119.5	110.70	8.8	Existing MH.								
						+22.0	+24.0						
						+91.0	+93.0						
	1+00	120.2	110.90	9.3									
		120.2	110.93	9.3	1+15.0	4" stub N.E. & S.E.		14618	13569	811 N. St. Paul	809 N. St. Paul	8-30-61	11-22-60
LN #4	0+00	119.4	111.15	8.2	Existing MH.								
						+31.5(N)	+33.5(S)						
	1+00	119.1	111.35	7.7									
		118.8	OUT 111.52 / IN 111.62	7.3 / 7.2	1+86.0								
							float c. out fence 1+99.5(E) to 2+47.3	#2597 C1072		901 N St. Paul		8/20/90 6-11-68	
	2+00	119.1	111.65	7.4				C2725		905 N. St. Paul		4-18-67	
		119.2	111.77	7.4	2+61.3	4" stub N.E.							
LN #4A	0+00	119.3	111.61	7.7	Existing MH.								
							+19.4	9616737 B4262		821 N St. Paul		2-13-96 9-30-65	
		119.4	111.79	7.6	0+84.0	4" stub S.E.		C18806		815 N. St. Paul		4-14-70	
LN #5	0+00	121.1	111.59	9.5	Existing MH.								
						+25.0(N)	+52.0(S)						
	1+00	119.1	111.79	7.3									
		119.2	OUT 111.96 / IN 112.06	7.2 / 7.1	1+86.4	4" stub S.E.		035722		909 N. St. Paul	(Church)	11-1-72	
							+96.4(E)	6310		909 N ST Paul		8-9-82	
	2+00	118.9	112.09	7.8									
							+26.0(W)	5792 C748		909 N St. Paul	(Church)	5-6-82 11-7-66	
							+52.0(E)						
		119.9	112.23	7.7	2+72.0	4" stub NE & N.W.	SO MT MH	#5609 B-457 3000-00943 C5267	2915 W 9th	2925 W 9th SO	4-13-82 11-26-63 4-26-95 11-3-95	stub N.E	

C 55018 - 805 N. St Paul - 10-5-76 - 4" tee on top - Sewer (16 ft. N of MH)