


Trap Area

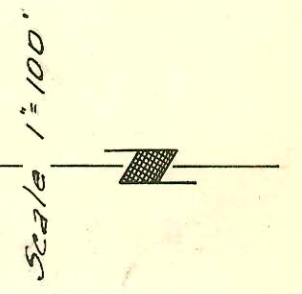

RELOCATION OF PARTS OF SAN. SEWER
 NO. 1 IN CONNECTION WITH THE IMPROVEMENT
 OF KELLOGG ST. FROM WICHITA TO ST. FRANCIS
 BOOK K-58 DEC. 1959
 W.B. CARTER CONST. CO.

