


Priv. S.S. Extension for 37th Rock Addition  
 468-76-245-80001-000-000-005  
 Built By Utility Contractors.  
 Booked 6-27-85 From DRH-19

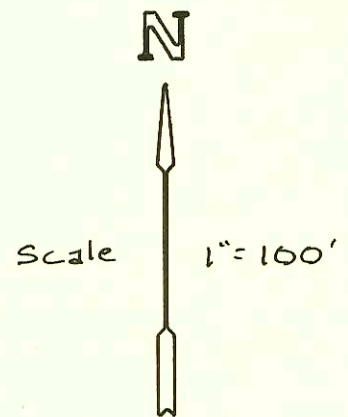

3741 N Rock Rd  
 7856  
 73643  
 (508 283)  
 RR 810

CONSTRUCTION RECORD						SERVICE RECORD						
STATION	ELEVATION		Depth	MANHOLE	4-INCH "Y" BRANCHES		No. of Permit		House Number		DATE OF PERMITS	
	Ground	Grade			North West	South East	North West	South East	North West	South East	North West	South East
Priv. S. S. Ext. for 37th Rock Addition												
LINE 1 0+00	182.42	170.60	11.8	0+00 EXIST.								
1+00	182.3	172.60	9.7	0+00 L-2								
	182.3	172.80 OUT 174.45 IN	9.5	1+10.2			1903 13852		7627 R # 27			1-22-92 5-24-85
2+00	182.7	175.31	7.4									
3+00	183.2	176.27	6.9									
	184.4	176.80 OUT 176.90 IN	7.6	3+55.1								
4+00	184.4	177.33	7.1									
5+00	185.4	178.29	7.1									
6+00	187.3	179.25 OUT 179.35 IN	8.1	6+00.5								
	187.6	179.15	8.5				13856		1727 E # 27			5-24-85
7+00	187.5	180.11 OUT 180.21 IN	7.4	7+89.7								
8+00	187.9	180.27	7.6									
9+00	188.5	180.87	7.6									
10+00	189.7	181.47	8.2									
11+00	190.5	182.07	8.4									
	191.6	182.55 OUT 182.65 IN	9.1	11+80.8								
12+00	191.5	182.89	8.6									
							12+01.8	13850	7627 # 37			5-24-85
13+00	193.9	184.09	9.8									
							13+05.1	13827	7627 E # 37			5-24-85
14+00	196.0	185.29	10.7									
	196.0	185.59	10.4	14+25.2								
LINE 2 0+00	182.3	172.90	9.4	0+00 1+10.2 L-1								
1+00	182.9	174.80	8.1									
							1+47.0	13853	7627 # 28			5-24-85
							1+69.0	13854	7627 # 29			5-24-85
2+00	184.0	176.71	7.3									
							2+02.5	13851	7627 # 26			5-24-85
3+00	185.7	178.61	7.1									
	188.9	179.50 OUT 179.60 IN	9.4	3+46.5			3+17.5	13857	7627 # 32			5-24-85
							3+65.5	13858	7627 # 33			5-24-85
4+00	187.0	180.37	6.6									
							5+14.5	13843	7627 # 19			5-24-85
							5+16.5	13840	7627 # 16			5-24-85
5+00	189.7	181.77	7.9									
	191.5	183.10 OUT 183.38 IN	8.4	5+96.8			5+18.9	13839	7627 # 15			5-24-85
6+00												
7+00												
LINE 4 0+00	191.3	183.80	7.5	7+00.5								
	182.85	173.74	9.1	0+00 EXIST.								
	185.4	174.92 OUT 175.03 IN	10.5	0+58.5								
1+00	183.6	175.56	8.0									
	185.5	175.95 OUT 176.05 IN	9.6	1+30.0								
2+00	184.5	176.96	7.5									
3+00	186.5	178.26	8.2									
	187.8	179.23 OUT 179.33 IN	8.6	3+75.9								
4+00	187.6	179.44	8.2									
5+00	188.5	179.84	8.7									
6+00	188.5	180.24	8.3									
	188.4	180.34 OUT 180.44 IN	8.1	0+00 L-5 6+29.5								
7+00	189.5	181.61	7.9									
8+00	191.9	183.25	8.7									
9+00												
	192.7	185.04 OUT 185.14 IN	7.7	9+09.2								
10+00	193.4	185.50	7.9									
11+00	192.8	185.90	6.9	11+44.2								
	193.5	186.08 OUT 186.18 IN	7.4									