J-231 A

Priv. San. Sewer Extension for
Lot 1, Blk A, Chelsea Industrial Park
468-76-245-80001-000-000-049
Built By Mid-States Const.
Booked 4-11-86 From "As Built Plan"

11-85

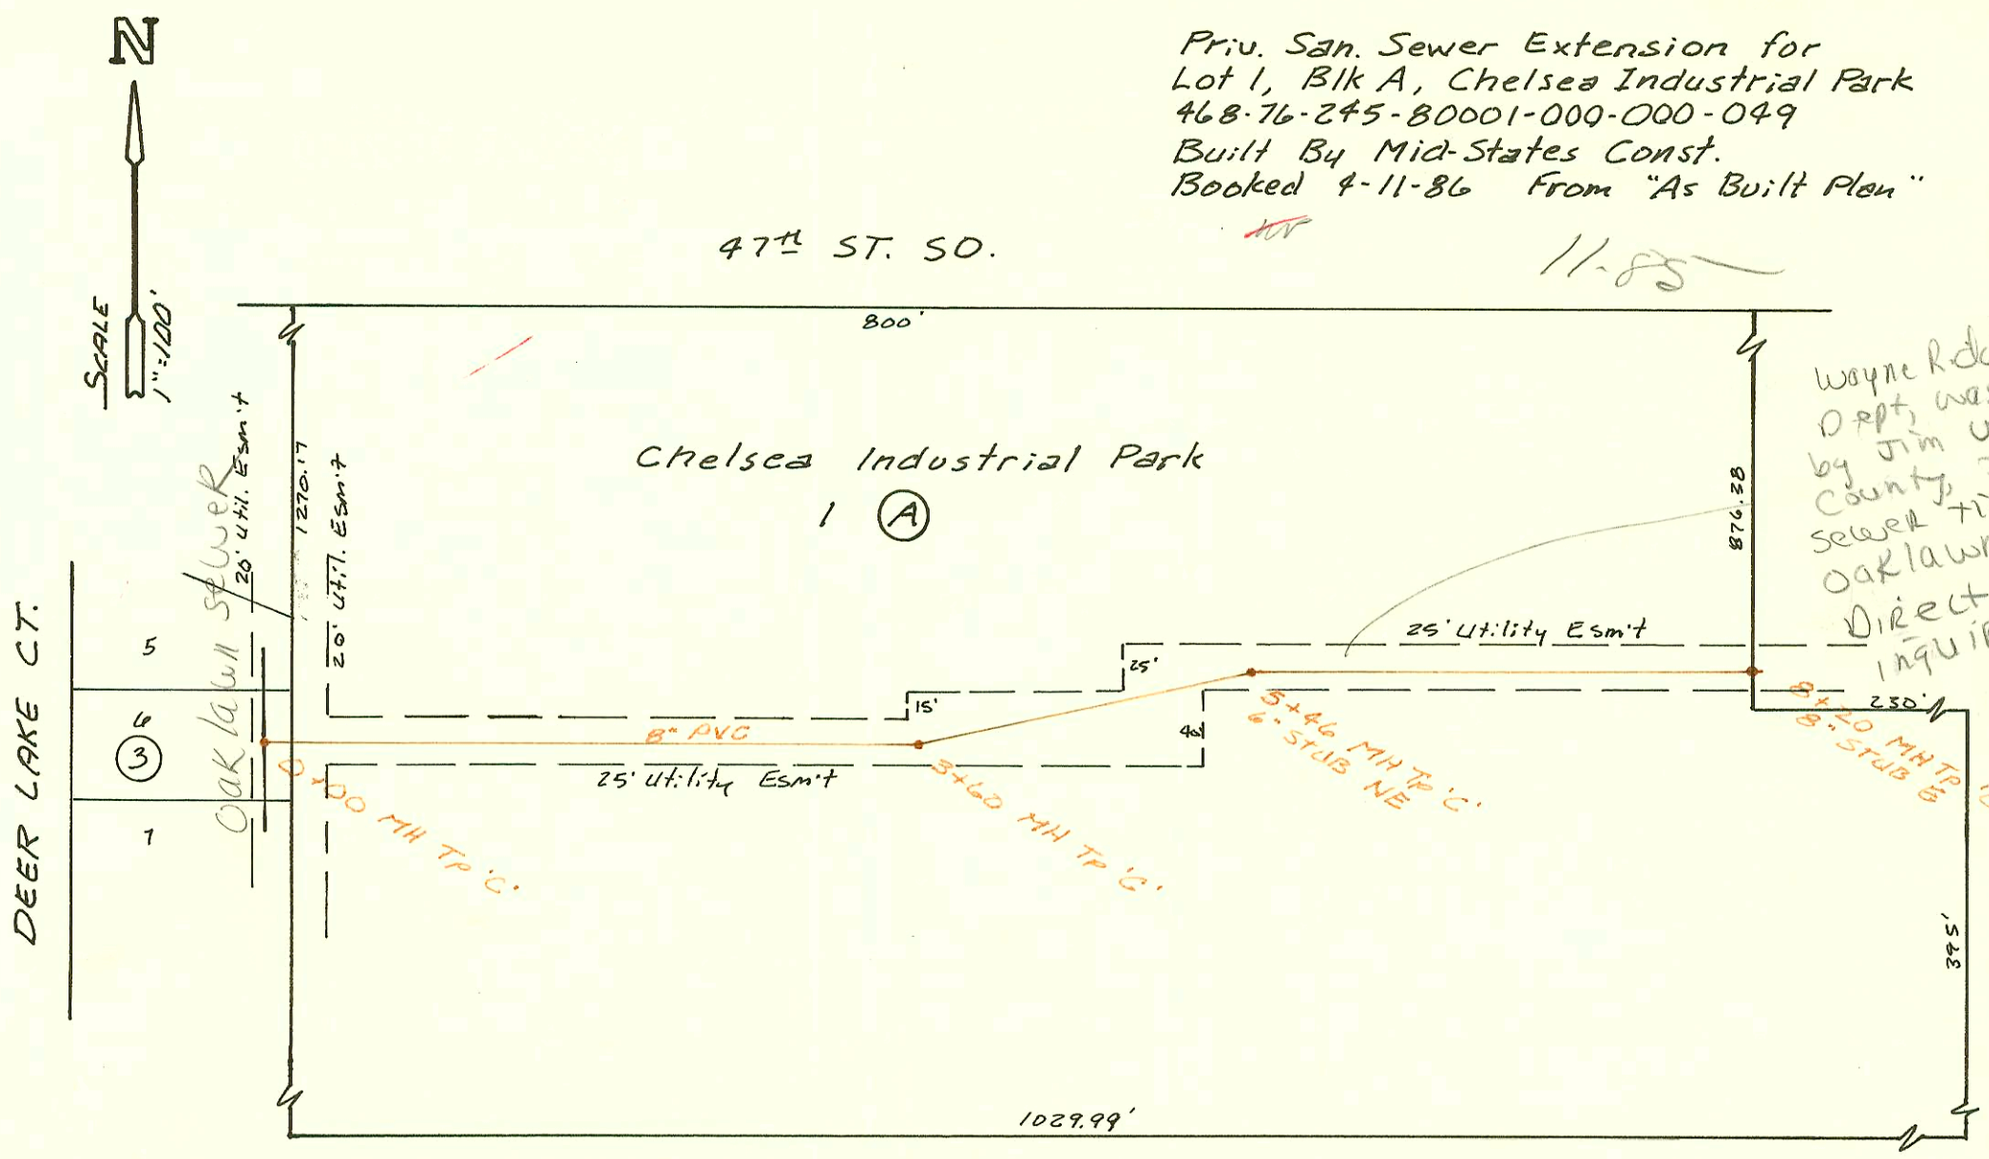

Wayne Riddle, Water Dept, was advised by Jim Webber, County, that this sewer ties into Oaklawn sewer. Direct any inquiries to County
BR 2-28-95

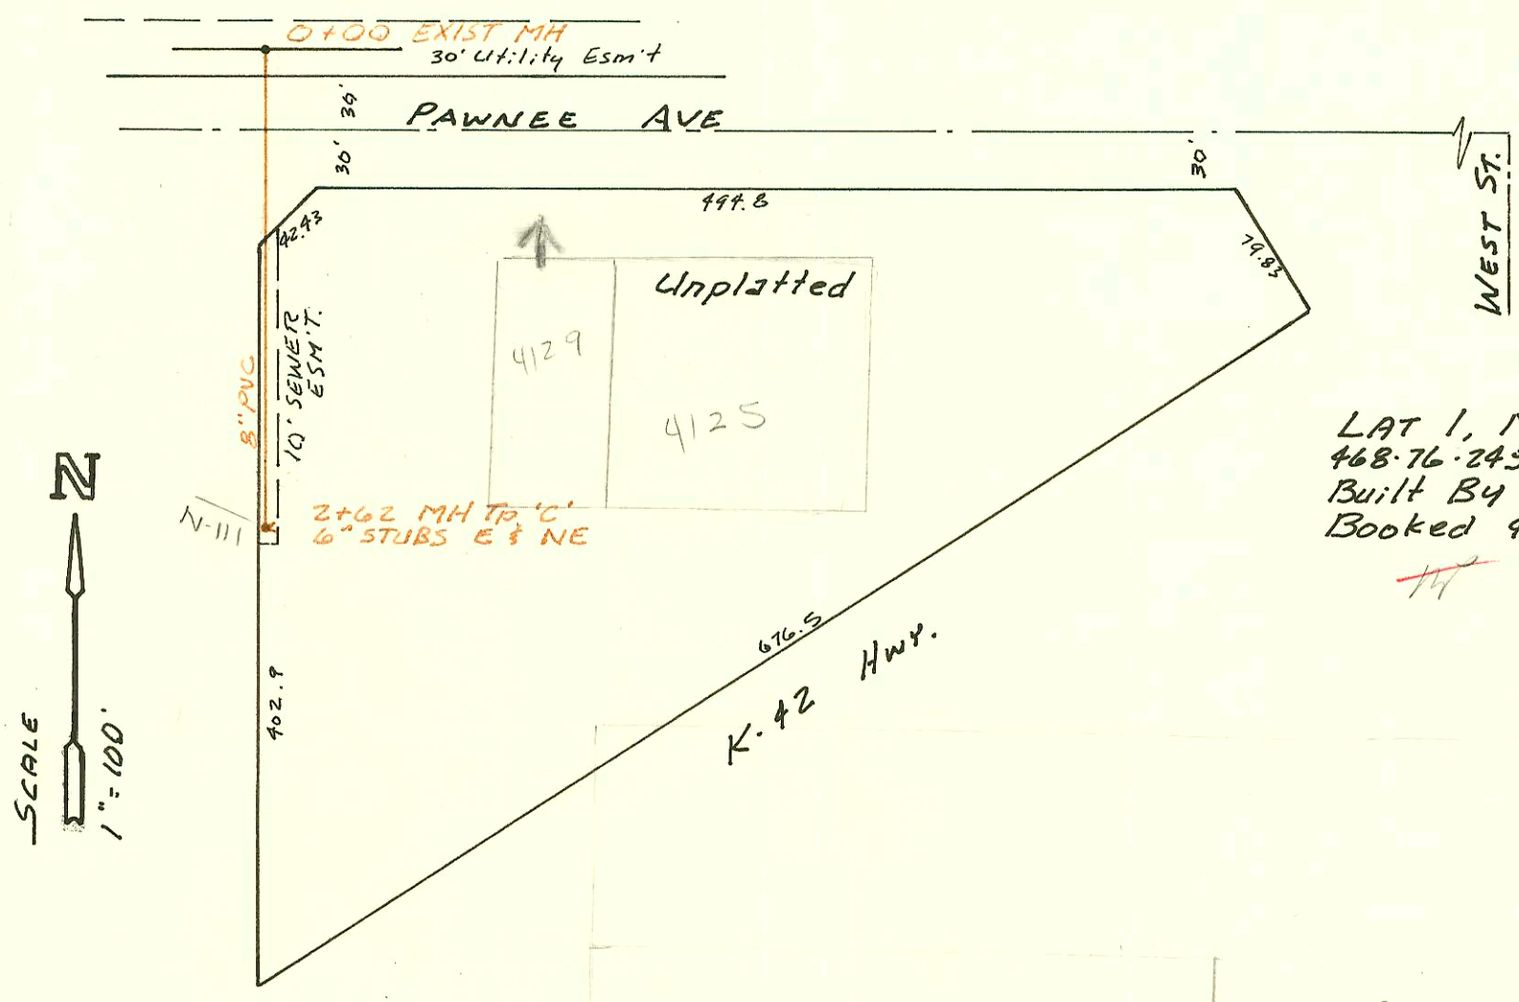

LAT 1, MAIN 14, SWI.
468-76-245-81502-000-000-001
Built By Stannard Const.
Booked 4-17-86 From CG 16A

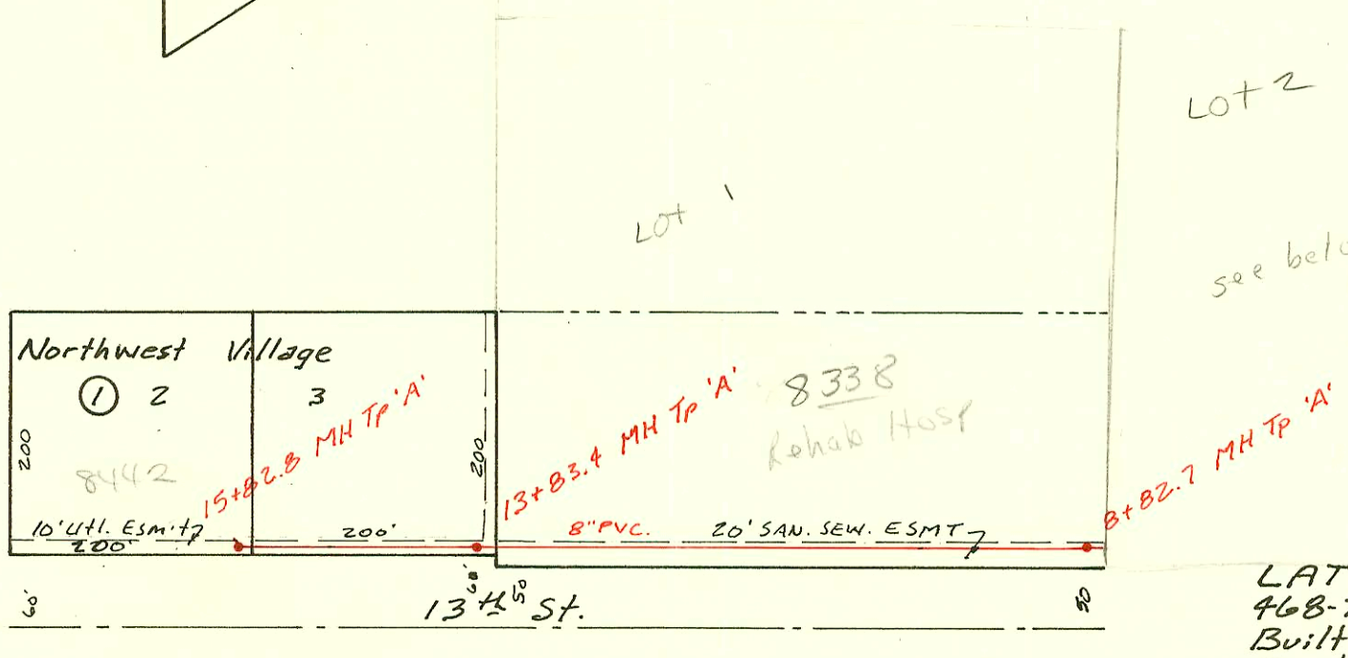

LAT 161, SW INTERCEPTOR
468-76-245-81042-000-000-001
Built By Utility Contractors Inc.
Booked 4-28-86 From DCD-266

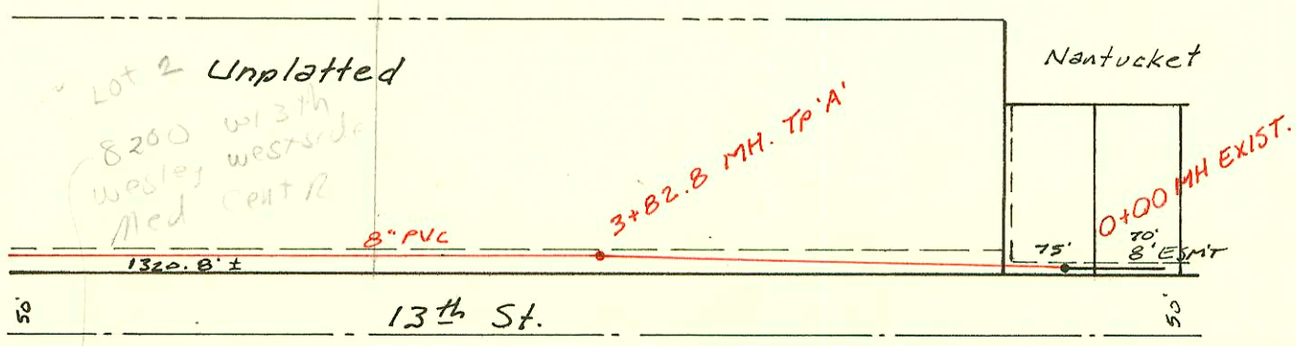

IN B/D - No further asses. fee
Rec'd per Gene Rath 5-23-95
BR

5-41
5-42

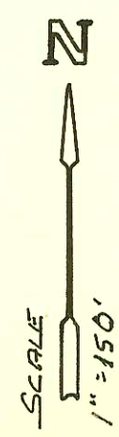

J-231

	CONSTRUCTION RECORD						SERVICE RECORD					
STATION	ELEVATION		Depth	MANHOLE	4-INCH "Y" BRANCHES		No. of Permit		House Number		DATE OF PERMITS	
	Ground	Grade			North West	South East	North West	South East	North West	South East	North West	South East
Priv. S.S. Ext. for Chelsea Industrial Park												
0+00	122.33	109.25	13.1	0+00								
1+00	124.1	109.55	14.6									
						1+47 6" RISER S						
2+00	123.4	109.85	13.6									
3+00	122.6	110.15	12.5									
	122.36	110.33	12.0	3+60								
4+00	122.2	110.47	11.7									
5+00	123.0	110.83	12.2									
	123.41	110.99	12.4	5+46	6" STUB NE							
6+00	123.3	111.17	12.1									
7+00	123.1	111.51	11.6									
8+00	122.9	111.85	11.1									
	123.15	111.92	11.2	8+20		8" STUB E						
LAT 1, MAIN 14, SWI												
0+00	107.39	93.85	13.5	EXIST 0+00								
1+00	107.00	95.58	11.4			4" SDR-35 1+88.5		94-16394		4124 Pawnee		10-6-94
2+00	106.5	97.32	9.2			Replace Appr 6' at Bldg		16414		4125 Pawnee		6-5-86
	106.58	98.39	8.2	2+62.0	6" STUB NE	4" 11.85 ok 6" STUB E		94-8488-1 16412		4105 Pawnee R		6-13-94 6-5-86
LAT 16, SWI												
0+00	156.54	150.08	6.5	0+00 EXIST								
1+00	157.3	150.37	6.9									
2+00	157.5	150.65	6.9									
3+00	158.2	150.94	7.3									
	159.33	151.18 OUT 151.21 IN	8.2	3+82.8								
4+00	159.1	151.26	7.8									
5+00	160.0	151.58	8.4									
6+00	160.5	151.90	8.6									
7+00	161.1	152.22	8.9									
8+00	161.5	152.54	9.0									
	162.32	152.80	9.5	8+82.7								
9+00	161.8	152.85	9.0									
10+00	162.7	153.15	9.6									
11+00	163.5	153.44	10.1									
12+00	164.1	153.74	10.4									
13+00	164.3	154.03	10.3									
	164.69	154.28	10.4	13+83.4								
14+00	163.4	154.33	9.1									
15+00	162.9	154.63	8.3									
	163.27	154.87	8.4	15+82.8	4" STUB NW ok		19460		8442 W 13th		10/30/87	

Form #192-020 (July, 1981)