J-234A

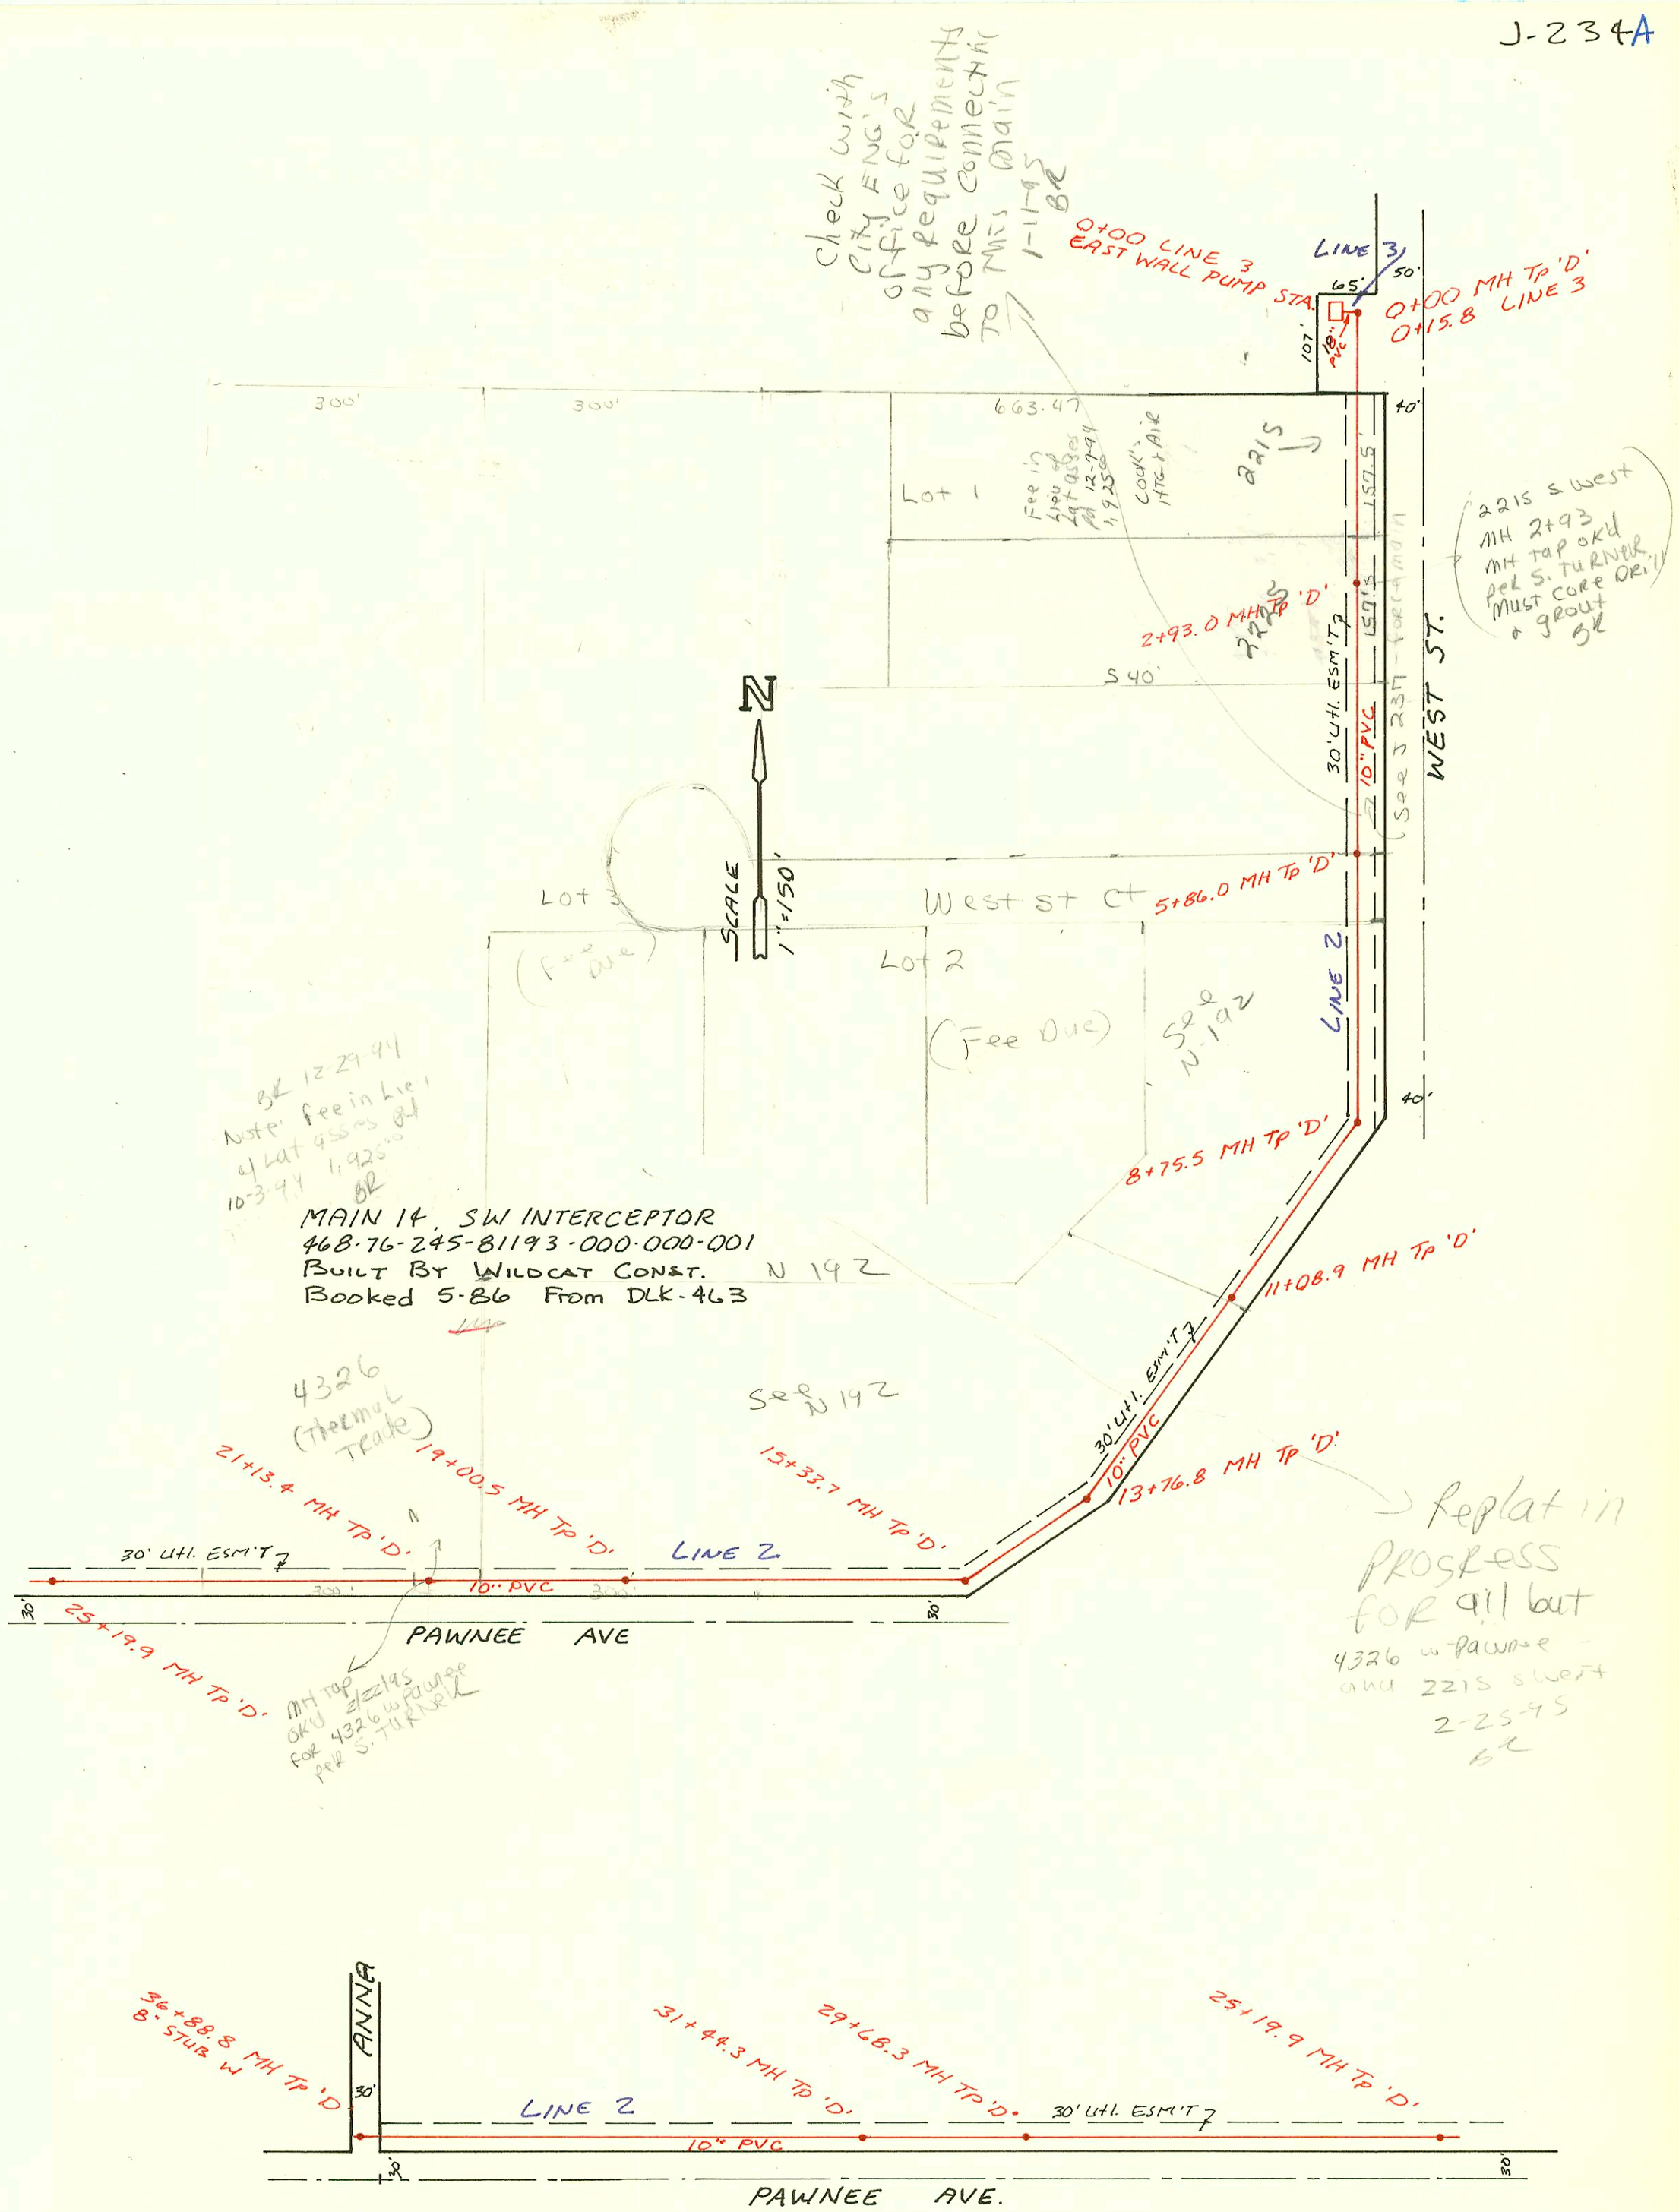
Check with City Eng's office for any requirements before connecting to Main
0+00 LINE 3 EAST WALL PUMP STA.
LINE 3
0+00 MH Tp 'D' 0+15.8 LINE 3
10" PVC
300'
300'
663.47
Lot 1
Fee in lieu of Lot assess 12-29-94 1,925.00
Cook's Tire + Air
221 S
40'
157.5'
2+93.0 MH Tp 'D'
221 S West MH 2+93 MH Tap OK'd per S. TURNER MUST CORE DRILL + grout BK
S 40'
30' Util. Esm't
10" PVC
See 7 R3F
WEST ST.
N
SCALE 1"=150'
Lot 3
West St Ct
5+86.0 MH Tp 'D'
(Fee Due)
Lot 2
(Fee Due)
See N 192
LINE 2
40'
BK 12-29-94 Note: fee in lieu of Lot assess 10-3-94 1,925.00 BR
8+75.5 MH Tp 'D'
MAIN 14, SW INTERCEPTOR
468-76-245-81193-000-000-001
BUILT BY WILDCAT CONST.
Booked 5-86 From DLK-463
N 192
11+08.9 MH Tp 'D'
4326 (Thermal Trade)
See N 192
30' Util. Esm't
10" PVC
21+13.4 MH Tp 'D'
19+00.5 MH Tp 'D'
15+33.7 MH Tp 'D'
13+76.8 MH Tp 'D'
Replat in progress for all but 4326 w Pawnee and 221 S West 2-25-95 BR
30' Util. Esm't
LINE 2
10" PVC
30'
30'
25+19.9 MH Tp 'D'
PAWNEE AVE
MH Tap OK'd 2/22/95 for 4326 w Pawnee per S. TURNER
36+88.8 MH Tp 'D' 8" STUB W
ANNA
30'
31+44.3 MH Tp 'D'
29+68.3 MH Tp 'D'
25+19.9 MH Tp 'D'
LINE 2
30' Util. Esm't
10" PVC
30'
30'
PAWNEE AVE.

J-234

	CONSTRUCTION RECORD						SERVICE RECORD					
	STATION	ELEVATION Ground	ELEVATION Grade	Depth	MANHOLE	4-INCH "Y" BRANCHES North West	4-INCH "Y" BRANCHES South East	No. of Permit North West	No. of Permit South East	House Number North West	House Number South East	DATE OF PERMITS North West	DATE OF PERMITS South East
MAIN 14, SWI													
LINE 2	0+00	108.14	85.91	22.2	0+00 L-2 8+00 L-4								
	1+00	107.4	86.13	21.3									
	2+00	107.0	86.35	20.7									
		107.07	86.56	20.5	2+93.0	4" R.B.S 40 4" M.H TAP NW		94-20340-7		2215 S West + N/C		1-17-95	
	3+00	106.4	86.57	19.8		3+31 TAP		95-19141-7		2225 S. West + See Below		11-17-95	
	4+00	106.1	86.76	19.3									
	5+00	106.0	86.95	19.1									
		108.25	87.11	21.1	5+86.0								
	6+00	107.0	87.15	19.9									
	7+00	106.1	87.42	18.7									
	8+00	105.8	87.69	18.1									
		106.19	87.89	18.3	8+75.5								
	9+00	106.1	87.98	18.1									
	10+00	106.0	88.33	17.7									
	11+00	105.8	88.68	17.1									
		105.43	88.71	16.7	11+08.9								
	12+00	106.5	88.91	17.6									
	13+00	106.6	89.12	17.5									
		107.85	89.29	18.6	13+76.8								
	14+00	107.3	89.36	17.9									
	15+00	106.8	89.65	17.2									
		108.52	89.75	18.8	15+33.7								
	16+00	107.2	89.93	17.3									
	17+00	108.2	90.21	18.0									
	18+00	108.3	90.48	17.8									
	19+00		90.76	←									
		108.55	90.76	17.8	19+00.5								
	20+00	107.0	91.01	16.0									
	21+00	106.2	91.26	14.9						see Below			
		107.39	91.29	16.1	21+13.4	4" S.D.R. 35 M.H. TAP		94-20686-7		4326 W Pawnee		12-29-94	
	22+00	107.1	91.45	15.7									
	23+00	107.1	91.64	15.5									
	24+00	107.5	91.83	15.7									
	25+00	107.3	92.02	15.3									
		107.65	92.06	15.6	25+19.9								
	26+00	107.5	92.26	15.2									
	27+00	107.5	92.50	15.0									
	28+00	107.3	92.75	14.6									
	29+00	107.2	92.99	14.2									
		106.54	93.16	13.4	29+68.3								
	30+00	106.9	93.23	13.7									
	31+00	107.0	93.46	13.5									
		106.77	93.56	13.2	31+44.3								
	32+00	106.0	93.66	12.3									
	33+00	105.9	93.85	12.1									
	34+00	106.0	94.04	12.0									
	35+00	106.1	94.23	11.9									
	36+00	106.2	94.41	11.8									
		105.80	94.58	11.2	36+88.8								
LINE 3	0+00	112.0	82.20	29.8	WET WELL 0+00								
		108.14	82.44	25.7	0+15.8								

96-28989 - 3-5-96 2225 S. West - Morris Ditching - (Capital sewer)

95-19141-7 11-17-95 2225 S. West. Dondlinger Tapped Main at 38' S of MH 2+93 and ran 6' of 4" sch40 up from Main at 45 degree angle & capped

#95-2358-7-12-22-95 - 4326 W. Pawnee: 4" M.H. Tap Done By W.B. Carter For Morris Ditching - 4" S.D.R. 35

Form #192-020 (July, 1981)

(10/4/94 Thermal Trade (Lot 4) fee in Lieu of Lateral asses. pd 10-4-94) This fee applies to one Bldg - one conn. only - any future Bldgs must pay current asses rate)