


LAT 188, SW Interceptor
 468-76-245-81382-000-000-001
 Built By Stannard Const.
 Booked 11-20-86 From DRH-20

CLEAR 9.88

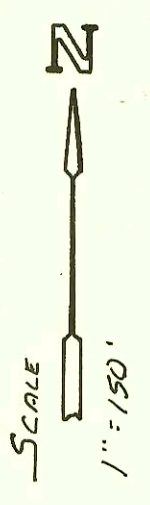

CONSTRUCTION RECORD							SERVICE RECORD					
STATION	ELEVATION		Depth	MANHOLE	4-INCH "Y" BRANCHES		No. of Permit		House Number		DATE OF PERMITS	
	Ground	Grade			North West	South East	North West	South East	North West	South East	North West	South East
LAT 81 LINE 3 WIS 0+00	185.47	177.28	8.2	0+00 11+66.7 L-2								
1+00	185.9	177.74	8.2		1+10.0 TAP 1+91.7 TAP		18250 18465		1849 N Talleyrand 1248 N Talleyrand		4-30-87 6-9-87	
2+00	187.0 187.85	178.21 178.44	8.8 9.4	2+50.7	2+62.7 TAP		17704		1250 N Talleyrand		1-24-87	
3+00	187.6	178.66	8.9		3+65.6 TAP		17537		1304 N Talleyrand		12-22-86	
4+00	188.1 188.81	179.11 179.49	9.0 9.3	4+85.6	4+67.6 TAP		17577		1308 N Talleyrand		1-6-87	
5+00	188.5	179.58	8.9		5+89.0 TAP		17556		1318 N Talleyrand		12-31-86	
6+00	189.1 189.49	180.23 180.27	8.9 9.2	6+07.0	6+60.0 TAP		17555		1316 N Talleyrand		12-31-86	
7+00	189.7 190.28	180.70 180.79	9.0 9.5	7+20.2	7+14.2 TAP		17552		1320 N Talleyrand		12-31-86	
8+00	190.2 191.05	181.55 182.23	8.7 8.8	8+71.4	8+42.4 TAP 4" Stub NW		17536 19448		1324 N Talleyrand 1328 Talleyrand		12-29-86 4-1-91	
LINE 4 0+00	189.96	177.84	12.1	0+00 7+19.5 L-2								
1+00	190.3	178.24	12.1									
2+00	190.6 191.36	178.64 178.90	12.0 12.5	2+66.3	2+49.7 TAP		17702		1240 Rutland CR		3-19-87	
3+00	191.0	179.03	12.0				17574		1241 N Talleyrand		1-6-87	
4+00	191.5	179.42	12.1		3+82.5 TAP W 180.52 E 180.39 N 180.66 S 180.92 4" Stub NE	3+45.5 TAP E 180.39 W 180.52 S 180.72 4" Stub SW	17652 17576 17534		1304 N Rutland 1245 N Talleyrand 1308 N Rutland		1-20-87 1-6-87 5-12-87	
5+00	192.1 192.98	179.80 180.11	12.3 12.9	5+79.5	5+99.9 TAP W 181.60 E 181.47 N 181.34 S 181.51 4" Stub SW	5+15.5 TAP E 181.06 W 181.23 S 181.40 4" Stub SW	18184 17553		1312 Rutland 1307 Talleyrand		4-22-87 10-31-86	
6+00	192.6	180.32	12.3		5+99.9 TAP W 181.60 E 181.47 N 181.34 S 181.51 4" Stub SW	6+15.5 TAP E 181.47 W 181.60 S 181.51 4" Stub SW	17557		1311 N Talleyrand		10-31-86	
7+00	193.3 194.30	181.35 182.29	12.0 12.0	7+91.9	7+22.9 TAP		17769		1316 Rutland CR 1320 Rutland		3-19-87 3-19-87	
8+00	193.8 194.63	182.39 182.91	11.4 11.7	8+40.5	8+05.9 TAP		17534		1324 N Rutland CL		6-22-87	
LINE 5 0+00	190.76	180.64	10.1	0+00								
LAT 188 LINE 1 0+00	189.98	180.96	9.0	0+43.3					1323 Talleyrand		10-01-91	
1+00	82.5	72.83	9.7	0+00					1321 Rutland		8-2-89	
2+00	82.5	72.88	9.4		0+64.2 TAP		22597		599 Rutland		2-21-89	
3+00	82.5 83.59	72.93 72.96 OUT 73.22 IN	9.6 10.4	2+58.2 0+00 L-2			25007		210 W Maywood		3-28-90	
4+00	83.2	73.52	9.7		4" SDR 35 3+40.2	3+22.2 TAP	83-33897-7 92-31862-7		309 W Lockwood 5405 Rutland 303 W Lockwood		9-2-93 7-31-89 10-28-92	
4+92	83.3	73.71	9.6	Plugged 0+00								
LINE 2 0+00	83.59	73.40	10.2	2+58.2 L-1					284 Maywood		12-5-90	
1+00	83.3	73.73	9.6						254 Maywood 312 Maywood		8-17-90 12-23-88	
2+00	82.8 83.35	74.06 74.35	8.7 9.0	2+88.1			41741-7 24364		315 W Lockwood 318 Maywood		11-12-92 11-28-89	
3+00	82.6	74.39	8.2		4" SDR 35 3+42.1 TAP 4" SDR 35 3+84.1 TAP	3+30.1 TAP 2+94.1 TAP	94-14366-7 94-14295-7		319 W Lockwood 403 W Lockwood	324 Maywood 322 Maywood	9-2-94 2-7-89	4-29-89 2-7-89
4+00	82.8	74.71	8.1						407 W Lockwood 411 W Lockwood	404 Maywood 412 Maywood	3-2-92 7-3-93	4-10-89 7-28-89
5+00	83.2	75.03	8.2		4" SDR 35 4+87.0 TAP 4" SDR 35 5+44.1 TAP	4+87.0 TAP 5+50.5 TAP	2001 83-18148-7		415 W Lockwood 411 W Lockwood	412 Maywood	7-1-94	1-26-88
6+00	83.2 84.45	75.36 75.58	7.8 8.9	6+69.0	4" SDR 35 6+06.4	6+27.0 TAP	84-11347		415 W Lockwood	420 W Maywood	7-1-94	1-26-88
7+00	83.4	75.67	7.7				2003-02517		603 W Lockwood	428 Maywood	9-29-03	9-14-90
8+00	83.0	75.96	7.0				95-20467-7		507 W Lockwood	506 Maywood	12-11-95	9-14-90
9+00	83.0 84.10	76.24 76.45	6.8 7.7	9+72.0	4" SDR 35 9+20	8+59.0 TAP 4" Stub NW	94-65517-7 83-455-7		511 W Lockwood 515 W Lockwood	512 W Maywood 520 W Maywood	4-29-94 1-4-93	11-27-89 6-22-90 1-26-88