


WAR INDUSTRIES SEWER EXTENSION
 ALONG GYPSUM CREEK From Kellogg to Central
 46B-76-245-81478-000-000-001
 BUILT BY Utility Contr.
 Booked 1-12-87 From BR 77

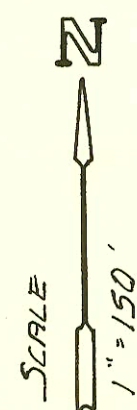

13-52

| CONSTRUCTION RECORD | | | | | | SERVICE RECORD | | | | | | |
|---------------------|------------------------------------|-------------------------|-------|---------|---------------------|----------------|---------------|------------|--------------|------------|-----------------|------------|
| STATION | ELEVATION | | Depth | MANHOLE | 4-INCH "Y" BRANCHES | | No. of Permit | | House Number | | DATE OF PERMITS | |
| | Ground | Grade | | | North West | South East | North West | South East | North West | South East | North West | South East |
| WAR INDUSTRIES | SEWER EXTENSION along GYPSUM CREEK | | | | | | | | | | | |
| 0+00 | 140.75 | 132.00 | 8.8 | EXIST | | | | | | | | |
| 1+00 | 146.4 | 132.27 | 14.1 | | | | | | | | | |
| 2+00 | 146.9 | 132.54 | 14.4 | | | | | | | | | |
| | 147.53 | 132.69 OUT 132.80 IN | 14.8 | 2+55.8 | | | | | | | | |
| 3+00 | 147.3 | 132.89 | 14.4 | | | | | | | | | |
| 4+00 | 147.6 | 133.09 | 14.5 | | | | | | | | | |
| 5+00 | 149.0 | 133.28 | 15.7 | | | | | | | | | |
| | 149.52 | 133.38 OUT 133.51 IN | 16.1 | 5+48.0 | | | | | | | | |
| 6+00 | 149.8 | 133.64 | 16.2 | | | | | | | | | |
| 7+00 | 151.0 | 133.88 | 17.1 | | | | | | | | | |
| 8+00 | 152.0 | 134.12 | 17.9 | | | | | | | | | |
| | 151.85 | 134.13 OUT 134.21 IN | 17.7 | 8+04.0 | | | | | | | | |
| 9+00 | 153.0 | 134.43 | 18.6 | | | | | | | | | |
| 10+00 | 154.0 | 134.65 | 19.4 | | | | | | | | | |
| | 154.10 | 134.67 OUT 134.84 IN | 19.4 | 10+09.1 | | | | | | | | |
| 11+00 | 149.5 | 135.05 | 14.5 | | | | | | | | | |
| 12+00 | 145.6 | 135.27 | 10.3 | | | | | | | | | |
| 13+00 | 147.0 | 135.50 | 11.5 | | | | | | | | | |
| 14+00 | 148.5 | 135.73 | 12.8 | | | | | | | | | |
| 15+00 | 150.5 | 135.96 | 14.5 | | | | | | | | | |
| | 147.35 | 136.11 OUT 136.23 IN | 11.2 | 15+67.9 | | | | | | | | |
| 16+00 | 146.5 | 136.36 | 10.1 | | | | | | | | | |
| 17+00 | 146.4 | 136.78 | 9.6 | | | | | | | | | |
| 18+00 | 145.2 | 137.20 | 8.0 | | | | | | | | | |
| 19+00 | 144.5 | 137.62 | 6.9 | | | | | | | | | |
| | 147.82 | 137.86 OUT 137.89 IN | 10.0 | 19+57.7 | | | | | | | | |
| 20+00 | 148.2 | 138.13 | 10.1 | | | | | | | | | |
| | 148.97 | 138.32 OUT 138.34 IN | 10.7 | 20+33.8 | | | | | | | | |
| 21+00 | 148.7 | 138.52 | 10.2 | | | | | | | | | |
| 22+00 | 148.5 | 138.80 | 9.7 | | | | | | | | | |
| | 147.97 | 138.95 OUT 139.01 IN | 9.0 | 22+54.6 | | | | | | | | |
| 23+00 | 145.8 | 139.11 | 6.7 | | | | | | | | | |
| 24+00 | 147.9 | 139.32 | 8.6 | | | | | | | | | |
| | 148.33 | 139.37 OUT 139.40 IN | 9.0 | 24+23.2 | | | | | | | | |
| 25+00 | 148.2 | 139.61 | 8.6 | | | | | | | | | |
| 26+00 | 149.5 | 139.89 | 9.6 | | | | | | | | | |
| 27+00 | 149.5 | 140.16 | 9.3 | | | | | | | | | |
| | 151.22 | 140.26 OUT 140.27 IN | 11.0 | 27+36.7 | | | | | | | | |
| 28+00 | 150.4 | 140.41 | 10.0 | | | | | | | | | |
| 29+00 | 153.0 | 140.64 | 12.4 | | | | | | | | | |
| | 153.38 | 140.77 OUT 140.81 IN | 12.6 | 29+59.3 | | | | | | | | |
| 30+00 | 152.0 | 141.04 | 11.0 | | | | | | | | | |
| 31+00 | 153.8 | 141.26 | 12.5 | | | | | | | | | |
| 32+00 | 153.9 | 141.49 | 12.4 | | | | | | | | | |
| 33+00 | 155.0 | 141.71 | 13.3 | | | | | | | | | |
| 34+00 | 155.5 | 141.94 | 13.6 | | | | | | | | | |
| 35+00 | 155.7 | 142.17 | 13.5 | | | | | | | | | |
| | 156.18 | 142.24 OUT 142.26 IN | 13.9 | 35+32.2 | | | | | | | | |
| 36+00 | 157.2 | 142.44 | 14.8 | | | | | | | | | |
| 37+00 | 157.3 | 142.70 | 14.6 | | | | | | | | | |
| | 157.56 | 142.84 OUT 142.90 IN | 14.7 | 37+74.8 | | | | | | | | |
| 38+00 | 157.4 | 142.97 | 14.4 | | | | | | | | | |
| 39+00 | 157.0 | 143.24 | 13.8 | | | | | | | | | |
| 40+00 | 156.6 | 143.52 | 13.1 | | | | | | | | | |
| 41+00 | 156.6 | 143.80 | 12.8 | | | | | | | | | |
| | 157.20 | 143.91 OUT 144.00 IN | 13.3 | 41+41.7 | 21" stub NE | | | | | | | |