


Refer to K-240

Replat 4-37

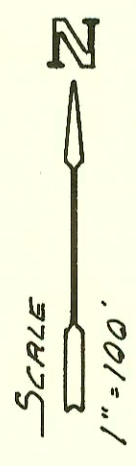

LAT 20, MAIN 12, SW INTERCEPTOR  
 468-76-245-B1541-000-000-001  
 Built By Stannard Const.  
 Booked 4-30-87 From AR-9-S.S.

1170

CONSTRUCTION RECORD						SERVICE RECORD						
STATION	ELEVATION		Depth	MANHOLE	4-INCH "Y" BRANCHES		No. of Permit		House Number		DATE OF PERMITS	
	Ground	Grade			North West	South East	North West	South East	North West	South East	North West	South East
LAT 20												
LINE 1												
0+00	161.75	152.51	9.2									
1+00	160.8	152.79	8.0									
	160.97	153.03 OUT 153.25 IN	7.9	1+87.9		8" stub S						
2+00	160.6	153.29	7.3		2+13.9 TAP 4" SDR 21 3+73.9 TAP	2+09.9 TAP 4" SDR 35 2+99.9 TAP	25504	25159	2023 PARKRIDGE CT	2023 PARKRIDGE CT	6-8-90	4-7-90
3+00	161.6	153.59	8.0		3+33.9 TAP	3+45.9 TAP	25022	27255	2024 PARKRIDGE CT	2024 PARKRIDGE CT	6-25-91	3-19-91
4+00	162.7	153.89	8.8		4" SCH 40 PVC 4+43.9 TAP	4+16.9 TAP	92-1992-7	26421	2021 PARKRIDGE CT	2017 PARKRIDGE CT	2-11-92	10-30-90
5+00	163.7	154.19	9.5		4+51.0 TAP	4+65.9 TAP	24432	26290	2023 PARKRIDGE CT	2015 PARKRIDGE CT	12-5-89	10-8-90
6+00	164.8	154.50	10.3									
	165.93	154.56 OUT 154.71 IN	11.4	0+00 L-2, L-3 6+21.0								
7+00	165.8	155.07	10.7									
8+00	166.2	155.53	10.7			8+31.7 TAP		18419	2024 N. PINE GROVE CT	2024 N. PINE GROVE CT	6-1-87	6-1-87
					8+67.7 TAP	8+95.8 TAP	18681	18416	2024 N. PINE GROVE CT	2024 N. PINE GROVE CT	7-13-87	7-13-87
9+00	166.8	155.98	10.8		9+01.3	9+85.3 TAP	18416	18420	2025 N. PINE GROVE CT	2025 N. PINE GROVE CT	6-1-87	6-1-87
	167.67	156.15 OUT 156.38 IN	11.5	9+36.3	9+59.3 TAP	9+85.3 TAP	19816	18750	2025 N. PINE GROVE CT	2025 N. PINE GROVE CT	12/04/87	7-22-87
10+00	167.4	156.70	10.7		10+09.2 TAP	10+45.3 TAP	18415	18421	2025 N. PINE GROVE CT	2025 N. PINE GROVE CT	6-1-87	6-1-87
					10+79.2 TAP	10+45.3 TAP	18414	18750	2025 N. PINE GROVE CT	2025 N. PINE GROVE CT	6-1-87	7-22-87
11+00	168.0	157.19	10.8		11+09.2 TAP	11+62.2 TAP	18413	20296	2025 N. PINE GROVE CT	2025 N. PINE GROVE CT	6-1-87	3-21-88
12+00	168.6	157.69	10.9		12+00.2 TAP	12+22.2	18786	11975 W 20th N	2014 W PINE GROVE CT	2014 W PINE GROVE CT	7-28-87	
	169.39	157.80 OUT 157.94 IN	11.6	12+22.2								
13+00	168.6	158.21	10.4									
	169.11	158.28	10.8	13+19.1		4" stub SE		27051	2014 W PINE GROVE CT	2014 W PINE GROVE CT	10/02/87	2-11-91
0+00	165.93	154.73	11.2	0+00 L-1 6+21.0	0+49.0 TAP	0+76.0 TAP	19206	24037	2014 W PINE GROVE CT	2014 W PINE GROVE CT	10/02/87	10-5-89
1+00	165.6	155.04	10.6		1+37.0 TAP	1+37.0 TAP	19205	24037	2014 W PINE GROVE CT	2014 W PINE GROVE CT	10/02/87	
2+00	165.6	155.35	10.3		2+28.1 TAP	2+45.1 TAP	20297	26082	2018 PINE GROVE CT	2017 PARKRIDGE CT	3-21-88	8-23-90
3+00	165.1	155.66	9.4		4" SDR 35 3+45.1	4" SDR 35 4+40.2	94-19572-7	94-16837	2102 N PINE GROVE CT	11901 CORNELIUS	11-29-94	9-30-94
4+00	165.7	156.97	8.7		4" SDR 35 5+37.2	4+28.1 TAP	94-19572-7	19171	11905 CORNELIUS	11902 W 20th N	5-16-94	9-30-87
5+00	166.5	157.50	9.0		5+23.2 TAP	5+23.2 TAP	18682	11909	11905 CORNELIUS	11904 W 20th N	11-2-92	7-3-87
	167.75	157.93	9.8	5+81.2	5+88.2 TAP	6+01.2 TAP	92-40787-1	18478	11909 CORNELIUS	11906 W 20th N	11-2-92	6-9-87
6+00	167.3	158.03	9.3		6+52.8 TAP	6+58.2 TAP	94-47867	18683	11913 W CORNELIUS	11906 W 20th N	3-29-94	7-13-87
7+00	168.1	158.53	9.6		7+02.2 TAP	7+72.6 TAP	94-17187	18684	11911 CORNELIUS	11910 W 20th N	5-16-94	7-13-87
8+00	168.9	159.04	9.9		8+23.2 TAP	8+23.2 TAP	92-37857-2	22507	11921 CORNELIUS	11912 W 20th N	11-3-92	8-25-87
	170.08	159.35	10.7	8+62.2	8+17.2 TAP	8+23.2 TAP	94-20487	18967	11925 CORNELIUS	11914 W 20th N	10-28-92	1-31-87
0+00	165.93	154.73	11.2	0+00 L-1 6+21.0	0+26.0 TAP	0+95.0 TAP	18412	24357	2012 W PINE GROVE CT	2013 PARKRIDGE CT	6-1-87	11-27-87
1+00	165.6	155.08	10.5		1+84.6 TAP	1+84.6 TAP	18417	24356	2012 W PINE GROVE CT	2008 PINE GROVE CT	6-1-87	10-9-89
2+00	166.3	155.44	10.9		2+45.6 TAP	2+45.6 TAP	23619	2006	2011 PARKRIDGE CT	2006 PINE GROVE CT	7-28-87	9-27-90
3+00	167.0	155.79	11.2		3+11.2	3+11.2	94-22667	11802	2006 PINE GROVE CT	11802 Bella Vista	9-27-90	2-16-94
	167.50	155.81 OUT 156.07 IN	11.7	3+04.6	4" PVC 40 3+11.2 TAP	4" SDR 35 3+54.6	91-27667	25382	11802 Bella Vista	11806 Bella Vista	7-22-91	5-23-90
4+00	166.3	156.49	9.8		4+97.2 TAP	5+15.2 TAP	18964	25382	2005 PINE GROVE CT	11802 Bella Vista	7-22-87	5-23-90
5+00	166.4	156.93	9.5		5+74.2 TAP	5+74.2 TAP	19988	25203	2007 PINE GROVE CT	11906 Bella Vista	1-25-88	4-20-90
	167.59	157.26	10.3	5+74.2	6+15.2 TAP	6+84.2 TAP	18966	25202	2007 PINE GROVE CT	11905 Bella Vista	8-31-87	4-20-90
6+00	167.0	157.36	9.6		6+70.8 TAP	6+84.2 TAP	18725	26106	2011 PINE GROVE CT	11910 Bella Vista	7-28-87	2-11-90
7+00	167.6	157.75	9.9		7+37.4 TAP	7+47.4 TAP	91-17487	25863	2011 PINE GROVE CT	11912 Bella Vista	3-18-91	7-26-90
8+00	168.4	158.14	10.3		8+47.4	8+47.4	19415	25864	2015 PINE GROVE CT	11914 Bella Vista	10/26/87	7-26-90
	169.34	158.32	11.0	8+47.4	4" stub N	4" stub S						

LINE 2

LINE 3

Form #192-020 (July, 1981)  
 Note: address changes as follows:  
 11913 = 11925 W CORNELIUS  
 11909 = 11921 " "  
 11829 = 11909 " "