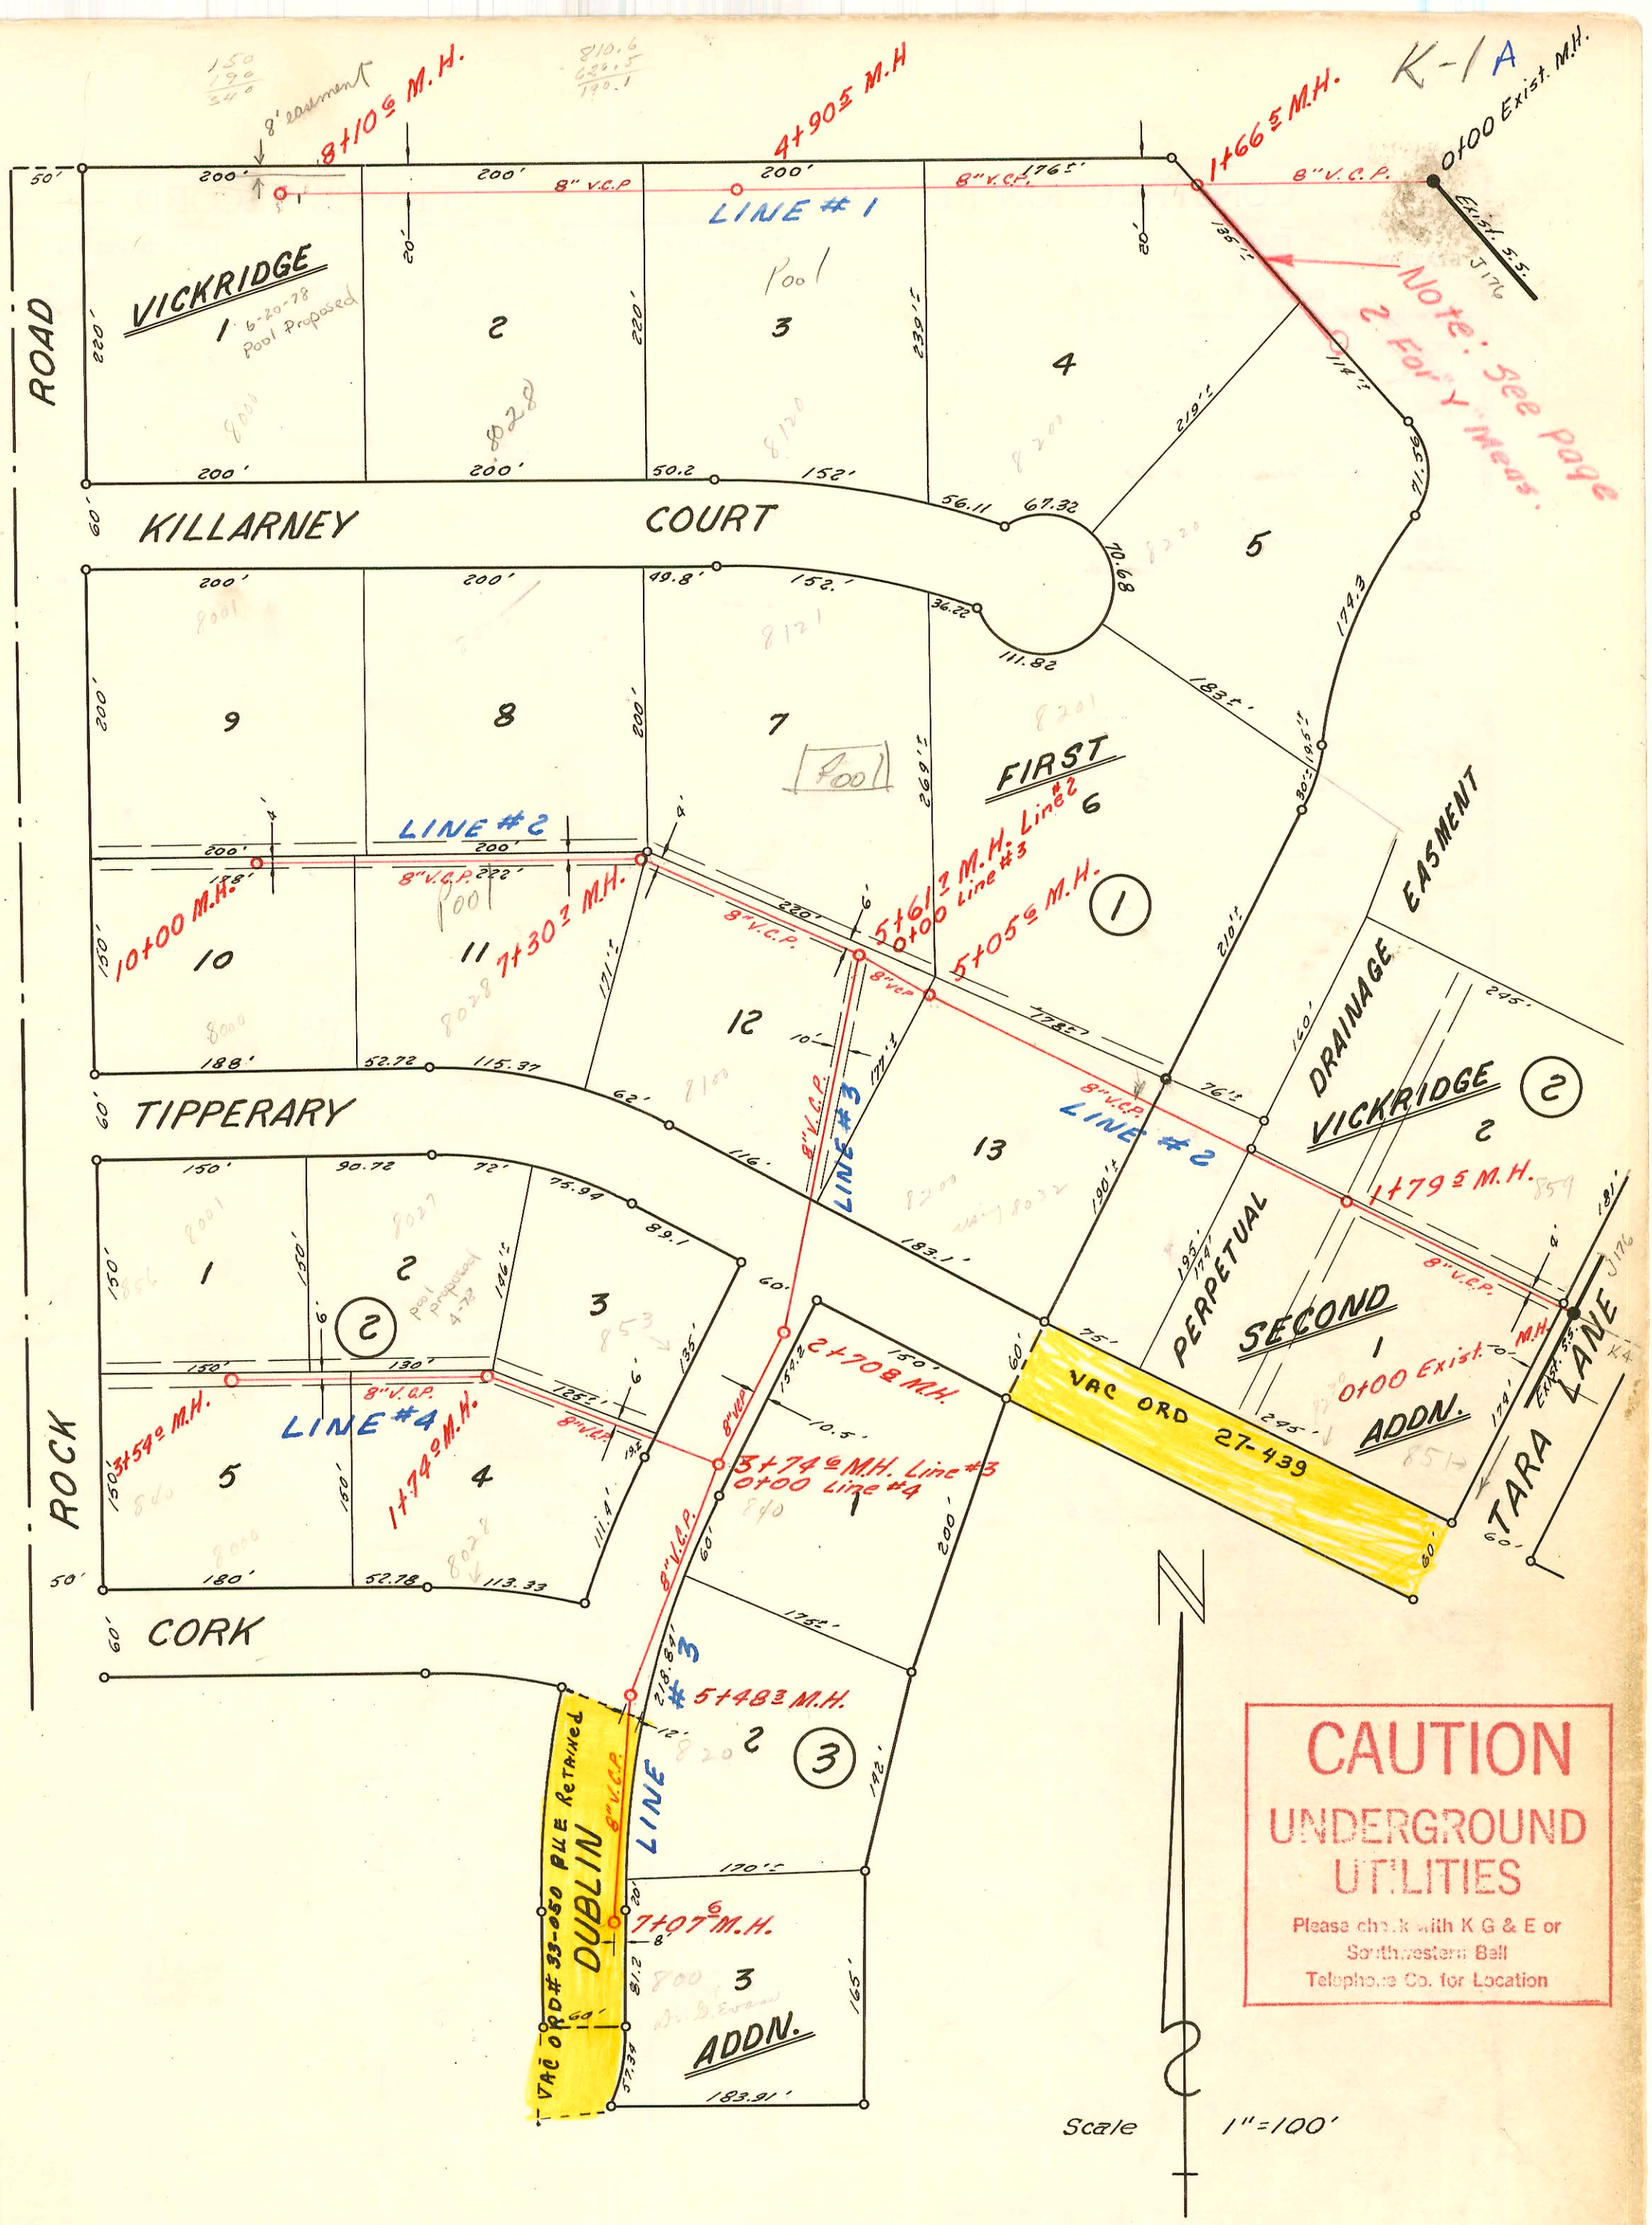

LAT. 2, SUB. 9 W/S LINE 1,2,3 & 4

W.B CARTER CONSTRUCTION CO. MARCH 15-62

BOOK-K71 PROJ. NO. C21-20 BOOKED 4-26-62

K-1

Form 41-(54) 7-60

CONSTRUCTION RECORD / SERVICE RECORD

STATION	ELEVATION Ground	ELEVATION Grade	Depth	MANHOLE	4-INCH "Y" BRANCHES North ~~West~~	4-INCH "Y" BRANCHES South ~~East~~	No. of Permit North West	No. of Permit South East	House Number North West	House Number South East	DATE OF PERMITS North West	DATE OF PERMITS South East
Line #1												
0+00	161.6	153.10	8.5	Exist'g M.H.								
1+00	157.4	153.64	3.8									
	161.3	154.00	7.3	1+66 S								
						Seal off 1+81 in 1+85 S		B339		8200 S/O Killarney	See page 1-2 for reconnect	11-1-63
2+00	162.8	154.50	8.3									
3+00	163.5	156.00	7.5			4" SCH 40 3+04.5 Predec		2501 01275		8200 Killarney	Petty Gas 500 above	5-23-01
						3+97 S						
4+00	166.2	157.50	8.7			4+36.5 to		16804		8100 Killarney		8-6-86
						4+54 S		#15473		8120 Killarney		4-13-62
						4+81 S						
	167.1	out 158.85 in 159.80	8.2 7.3	4+90 S								
5+00	167.0	160.10	6.9									
						5+~~79~~ 78 S		C35005		8028 Killarney Ct.		9-21-72
6+00	171.0	163.10	7.9									
					6+06 S							
					TAP 6+20.5	6+82 S	B1735		1000 Rock Rd (Wichita Country Club Restaurant)	8-5-64 SEC Fee 100 bd. Rec 51040		
7+00	177.1	166.10	11.0									
						7+98 S		C43255		8000 Killarney		1-30-74
8+00	177.4	169.10	8.3					C67375		8000 Killarney (Extension)		3-17-76
	177.3	169.40	7.9	8+10 S - M.H. Tap End 8" V.C.P.			C41230		10227 Rock Rd	9-14-73	Open fee 15.00 Rec 178927	9-14-73
Line #3												
0+06	163.6	153.26	10.3	Exist'g M.H.	West	East						
1+00	164.4	153.64	10.8									
						1+20 S						
2+00	162.6	154.04	8.6									
	163.0	out 154.32 in 154.42	8.7 8.6	2+70 S								
3+00	163.1	154.54	8.6									
						3+63 S		#15539		840 Dublin		4-25-62
	162.9	out 154.84 in 154.94	8.1 8.0	3+74 S								
4+00	162.9	155.00	7.9									
5+00	163.0	155.20	7.7									
						5+23 S		#15478		820 Dublin		4-10-62
	163.0	out 155.30 in 155.40	7.7 7.6	5+48 S								
						5+65 S		#15481		820 Dublin		4-10-62
6+00	163.8	155.50	8.3									
						6+79 S		B5387		800 Dublin		4-1-66
7+00	163.0	155.70	7.3									
	163.0	155.72	7.3	7+07.6	End 8" V.C.P.							
Line #4												
0+00	163.0	155.70	7.3	Exist'g M.H.	North	South						
1+00	165.9	157.50	8.4									
					1+03 Z	Tap (1+08.0)	15963	C45090	853 Dublin	8028 Cork	4-9-62	5-31-74
						1+15 S	SO	C45056 15927		8028 Cork		5-29-74 April-5-62
					1+42 S		#15468	C45	8101 Tipperary		4-9-62	
	166 S	out 158.74 in 158.84	8.1 8.0	1+74 S								
					1+96 S							
2+00	167.1	159.30	7.8									
					2+53 S	TAP 2+44 6	21018 C94194	C2282	8027 R Tipperary	8028 Cork (Addn.)	7-5-62 3/29/74	3-17-67
						2+89 S						
3+00	167.9	161.00	6.9									
					3+12 S		C2153		8001 Tipperary		3-7-67	
						3+43 S						
	168.8	161.91	6.9	3+54 S	End 8" V.C.P.							
Line #2												
0+00	167.9	149.80	18.1	Exist'g M.H.	North	South						
					0+23 Z	0+25 Z						
1+00	165.4	150.20	15.2									
					1+03 Z	1+05 Z						
	162.8	150.52	12.3	1+79 S								
2+00	162.1	150.60	11.5									
					2+91 S	2+93 S						
3+00	158.7	151.00	7.7		3+43 Z		C9474		8201 Killarney		7-8-68	
					3+46 S	3+48 S						
4+00	157.3	151.40	5.9									
5+00	160.8	151.82	9.0									
	160.8	151.82		5+05 S								
					5+34 S							
	164.0	out 152.05 in 155.50	12.0 8.5	5+61 Z	6" MH stub	MH tap	15411	202 3200 14825	3100 Tipperary	8121 R Killarney	4-3-62	8-7-02 10-8-85
6+00	165.3	156.25	9.1									
					6+34 S	6+36 S						
7+00	166.8	158.25	8.6									
	167.9	out 158.85 in 159.85	9.1 8.1	7+30 Z								
					7+51 S							
8+00	168.6	161.25	7.4									
					8+34.5							
						8+38 S		#15412		8028 Tipperary		4-3-62
9+00	170.0	163.25	6.8		Tap 10+4.4	8+62.7		6190		8028 Cork Tipperary		7-20-82
					~~9+51~~ S		C43645		8001 Killarney		2-26-74	
						9+73.5		#16524		8000 Tipperary		10-29-64
[illegible]	170.7	165.[illegible]	5.5	10+00	End 8" V.C.P.							