K 9A

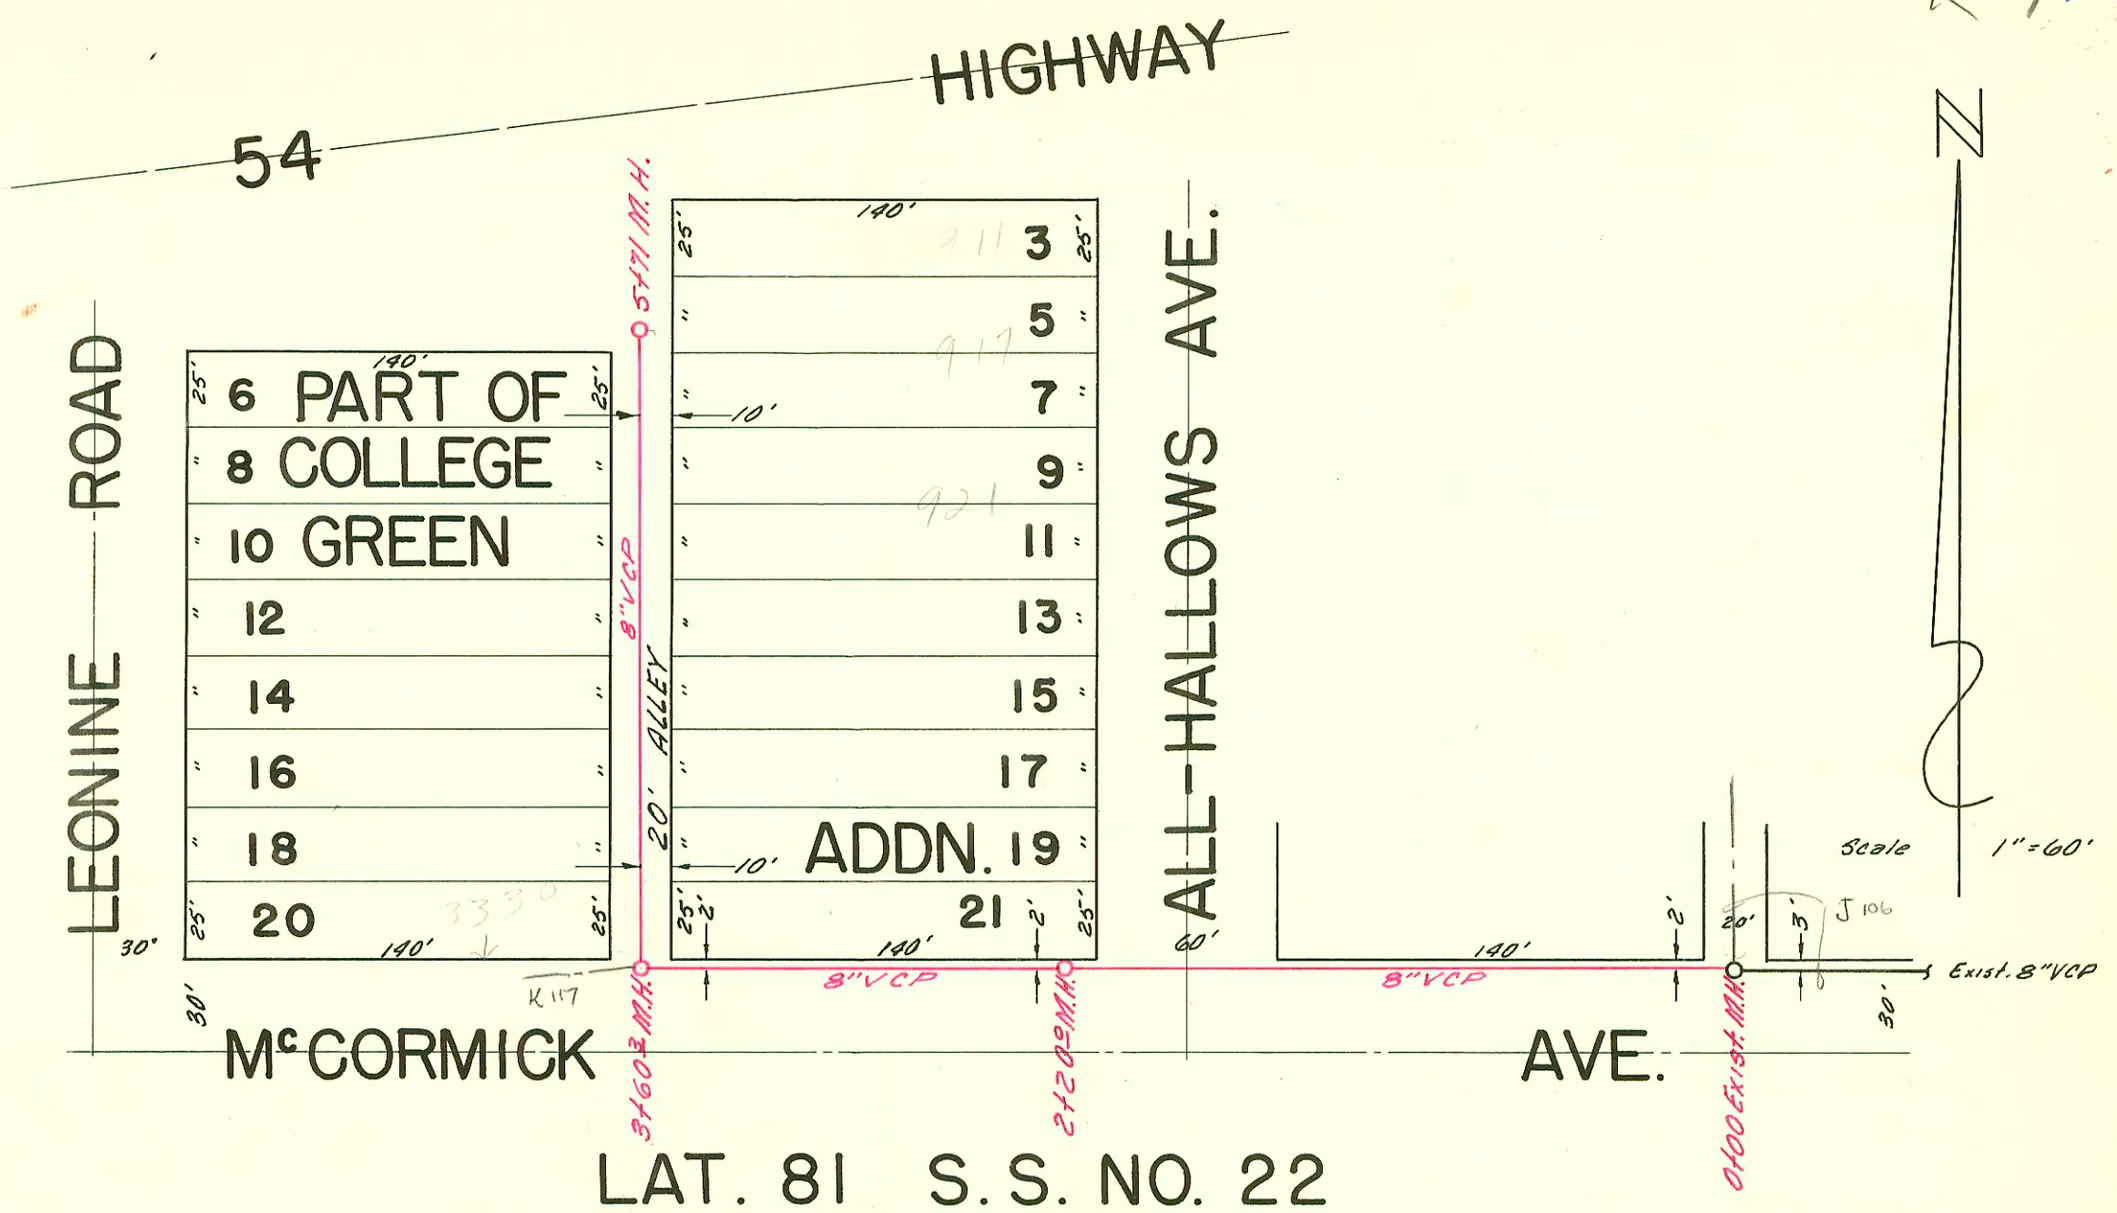

LAT. 81 S.S. NO. 22

MID-STATES CONSTRUCTION CO. INC. 7-20-62

BK. K-71 PROJ. NO. C22-14 BOOKED 8-3-62

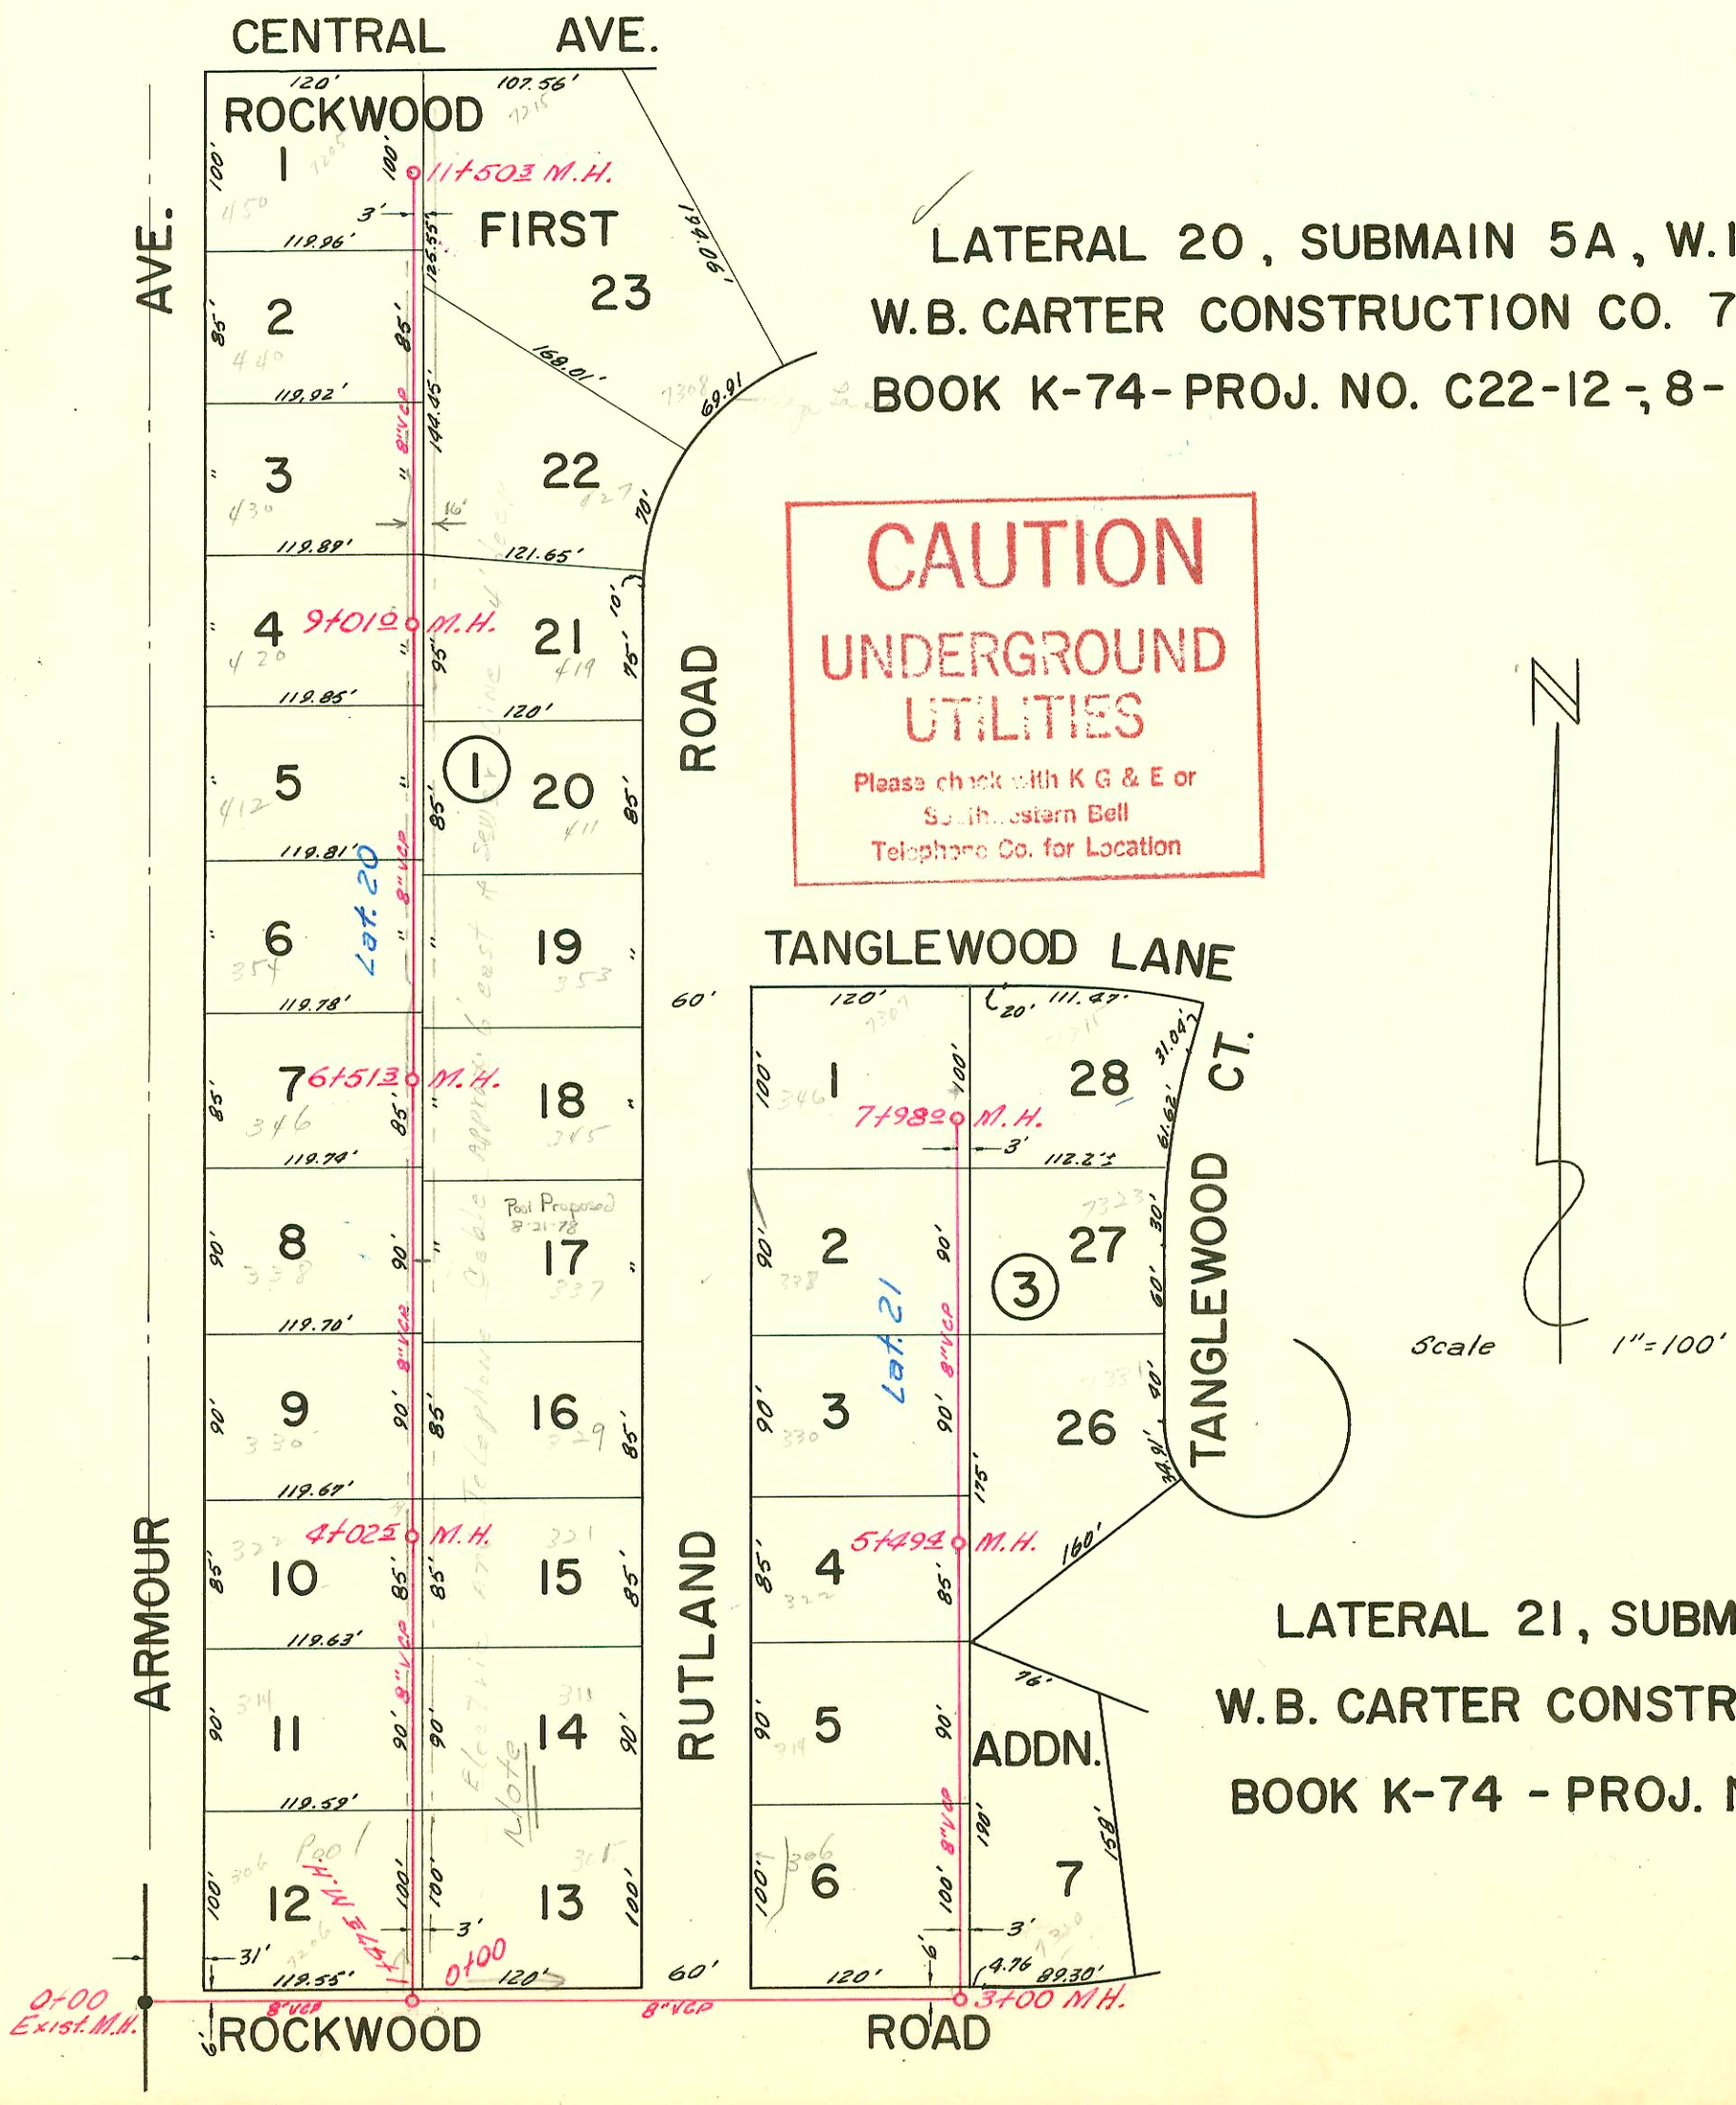

CAUTION
UNDERGROUND UTILITIES
Please check with K G & E or Southwestern Bell Telephone Co. for Location

LATERAL 20, SUBMAIN 5A, W.I.S.

W.B. CARTER CONSTRUCTION CO. 7-17-62

BOOK K-74-PROJ. NO. C22-12 -, 8-7-62

LATERAL 21, SUBMAIN 5A, W.I.S.

W.B. CARTER CONSTRUCTION CO. 7-17-62

BOOK K-74 - PROJ. NO. C22-13 8-7-62

Form 41-(54) 7-60

CONSTRUCTION RECORD							SERVICE RECORD					
STATION	ELEVATION		Depth	MANHOLE	4-INCH "Y" BRANCHES		No. of Permit		House Number		DATE OF PERMITS	
	Ground	Grade			North West	South East	North West	South East	North West	South East	North West	South East
Lat. 81 - 55.22												
0+00	112.2	106.25	6.0	Exist. 0+00								
1+00	112.9	106.45	6.5									
2+00	112.0	106.65	5.4									
	114.2	106.69	7.5	2+20 O								
3+00	114.6	106.85	7.6									
	114.6	Out 106.97 In 107.05	7.6 7.5	3+60 S								
					3+90 S	3+88 S	Seal # 12 25 15972		3330 McCormick		12-15-66 8-3-62	
4+00	116.2	107.23	9.0									
						4+43 S						
					4+97 O	4+95 O						
5+00	116.0	107.63	8.4									
						5+63 S		1741 B1674		917 all S.O. Nallown		12-24-91 7-30-64
	116.4	107.91	8.5	5+71 O								
Lat 20												
0+00	175.6	164.17	11.4	Exist. 0+00								
1+00	176.2	164.57	11.6									
	176.0	Out 164.76 In 164.83	11.2 11.1	1+47 S								
					1+85 O	1+83 O	# 16243 16832 16244	16077	306 N. Armour	301 Rutland	5-8-86 3-25-63	8-28-62
2+00	176.2	165.13	11.1						306 Armour		5-8-86	
					2+78 O	2+76 O		17104		311 Rutland		5-13-63
3+00	177.1	165.63	11.5									
					3+47 O	3+45 O	16096	16331	322 N. Armour	321 Rutland	9-5-62	11-8-62
4+00	178.0	166.13	11.9									
	178.0	166.13	11.9	4+02 S								
					Riser 4+56 O	4+54 O	# 16006	# 17006	330 N. Armour	327 Rutland	8-10-62	4-24-63
5+00	179.2	166.63	12.6									
					~~5+39 O~~ 5+46.3	5+39 O	# 16050		338 N. Armour		8-22-62	
6+00	179.1	167.13	12.0									
					6+23 O	6+21 O	15994		346 N. Armour		8-8-62	
	180.2	167.38	12.8	6+51 S								
7+00	179.6	167.63	12.0									
					7+14 O	7+12 O	# 16435	17255	354 N. Armour	353 Rutland	12-3-62	6-12-63
					7+98 O	7+96 O	16287		410 N. Armour		10-25-62	
8+00	180.2	168.13	12.1									
						8+78 O						
					8+88 O		# 16065		420 N. Armour		8-22-62	
9+00	179.5	168.63	10.9									
	179.5	168.63	10.9	9+01 O								
					9+60 O	9+58 O	16226	# B756	430 N. Armour	427 Rutland	10-8-62	1-29-64
10+00	179.5	169.13	10.4									
					10+53 O		16082		440 N. Armour		8-30-62	
11+00	179.6	169.63	10.0									
						11+01 S						
					11+30 S		B3864		450 N Armour		7-27-65	
	179.4	169.88	9.5	11+50 S								
								C70691		7308 R Plaza Dr		3-16-79
Lat. 21												
0+00	176.0	164.85	11.2	Exist. 0+00 O								
1+00	175.8	165.25	10.6									
2+00	175.8	165.65	10.2									
3+00	175.1	Out 166.05 In 166.13	9.1 9.0	3+00 O								
						3+33 O		B1294		7320 Rockwood		5-25-64
					3+75 O							
4+00	175.2	166.55	8.7									
					4+49 S	4+47 S	# 17059		314 Rutland		5-6-63	
5+00	175.3	166.95	8.4									
					5+30 S	5+28 S	16209		332 Rutland		10-4-62	
	175.5	167.15	8.4	5+49 S								
6+00	175.3	167.35	80									
					6+07 O	6+05 O		B207		7331 Sanglewood Ct		9-30-63
					6+95 S	6+93 S	B489	# B839	338 Rutland	7323 Sanglewood Ct	12-3-63	2-11-64
7+00	175.3	167.75	7.6									
					7+84 S	7+82 S	# 16282	B2180	346 Rutland	7315 Sanglewood	10-23-62	10-22-64
	175.6	168.08	7.5	7+98 O								

16330 - 7308 Plaza Dr. - 11-15-62 - top (11+14.3) D.A. Smith Alby.
16625 - 314 N. Armour - 2-12-63 - top (2+71.5) Ken Leppold
16632 - 345 Rutland - 3-7-63 - top (6+20.3) Kennedy Alby
16803 - 411 Rutland - 3-25-63 - top - (7+88) Kennedy Alby.
16806 - 337 Rutland - 3-25-63 - top (5+52.3) Kennedy Alby
17005 - 338 N. Armour - 4-24-63 top (5+98.3) Kennedy Alby. (Pool house)
B-144 - 330 Rutland - 9-18-63 - top (6+67.4) Kennedy Alby