K 11.A

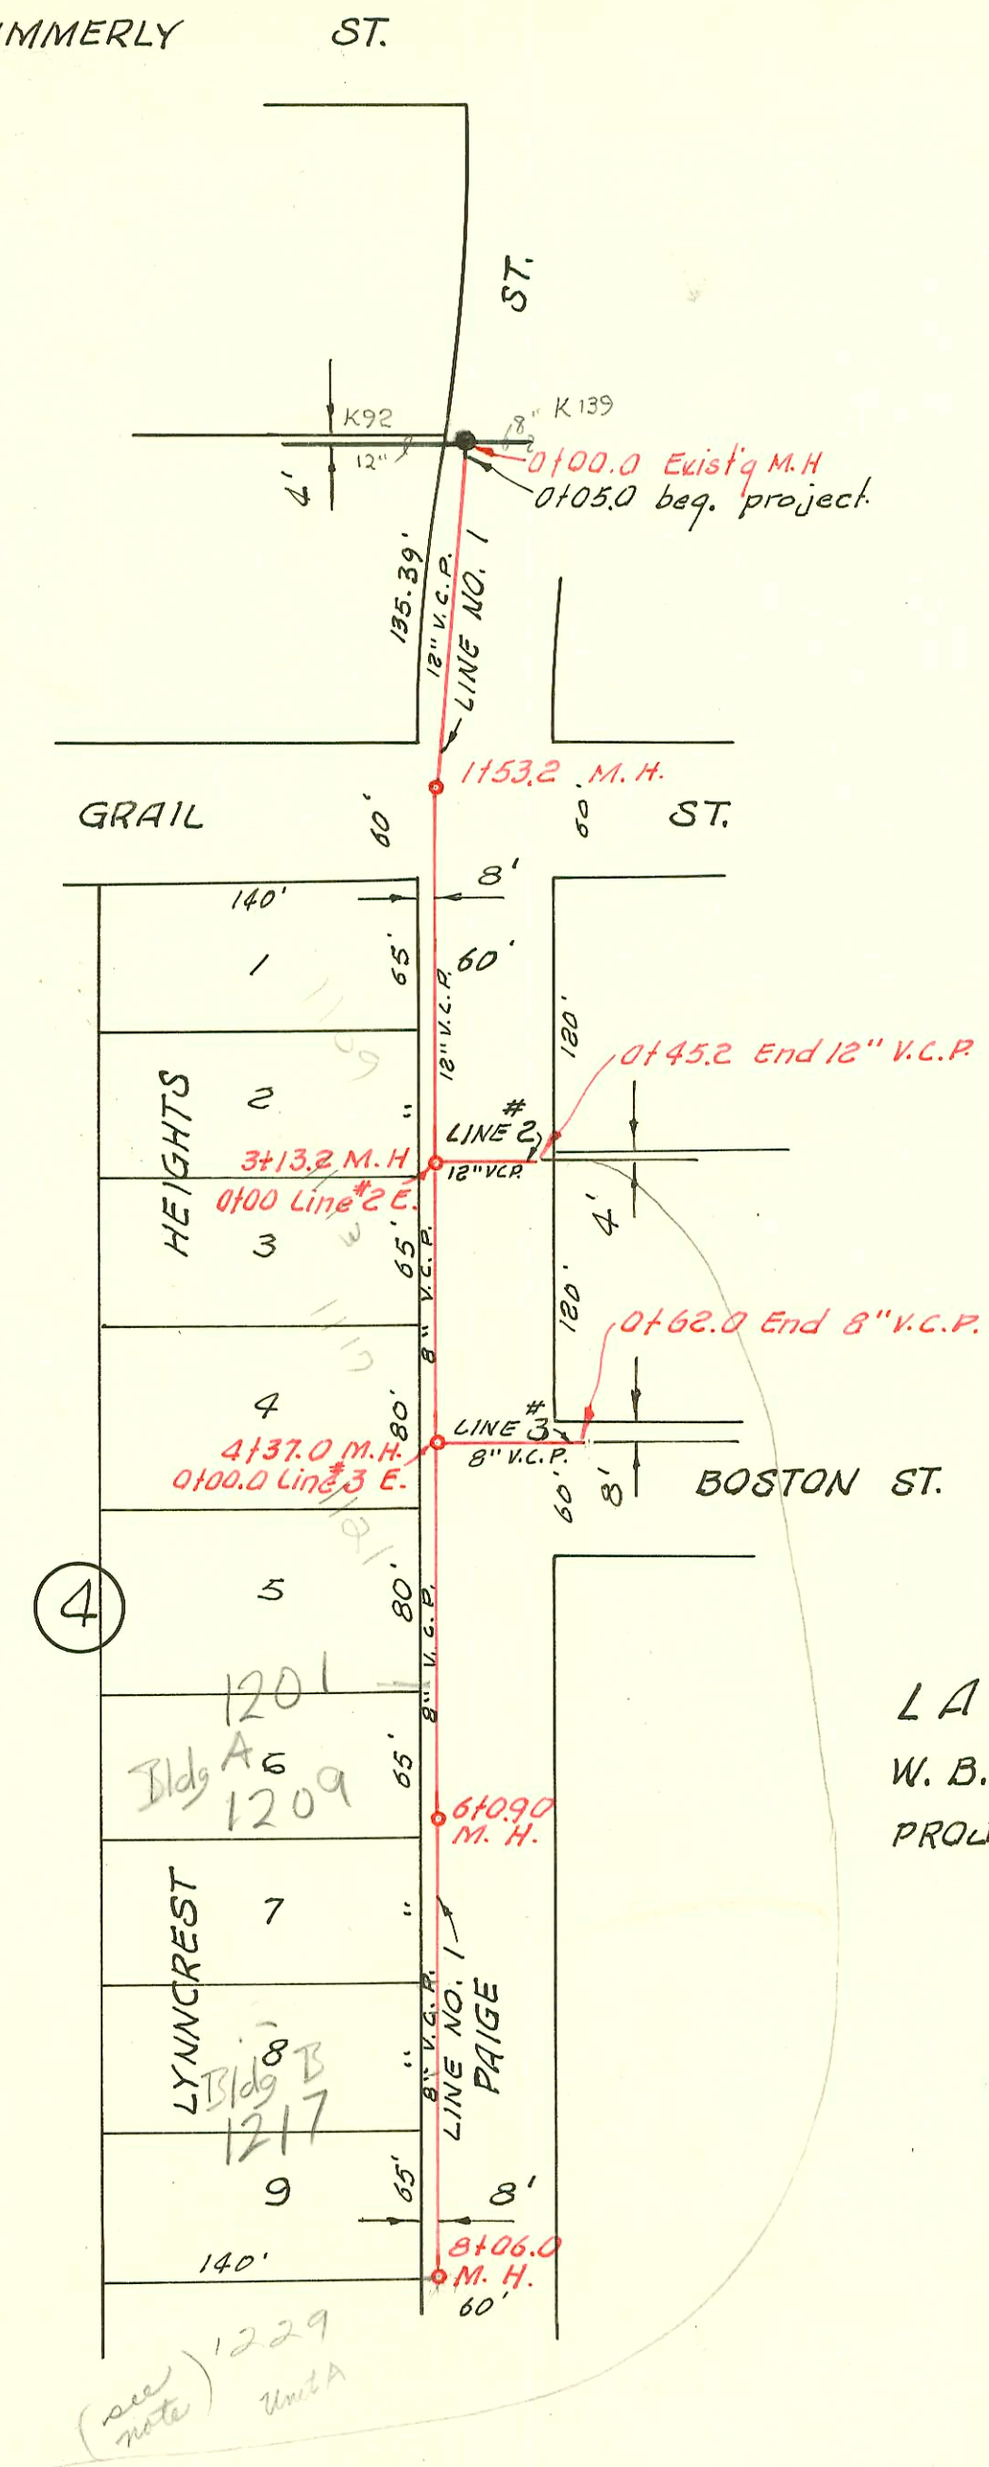

N

1" = 80'

LAT. 3, SUB. 11, W. I. S.
W. B. CARTER CONST. CO. INC. 10-65
PROJ. NO. C25-7, BK. NO. K-73
10-18-65

1" = 100'

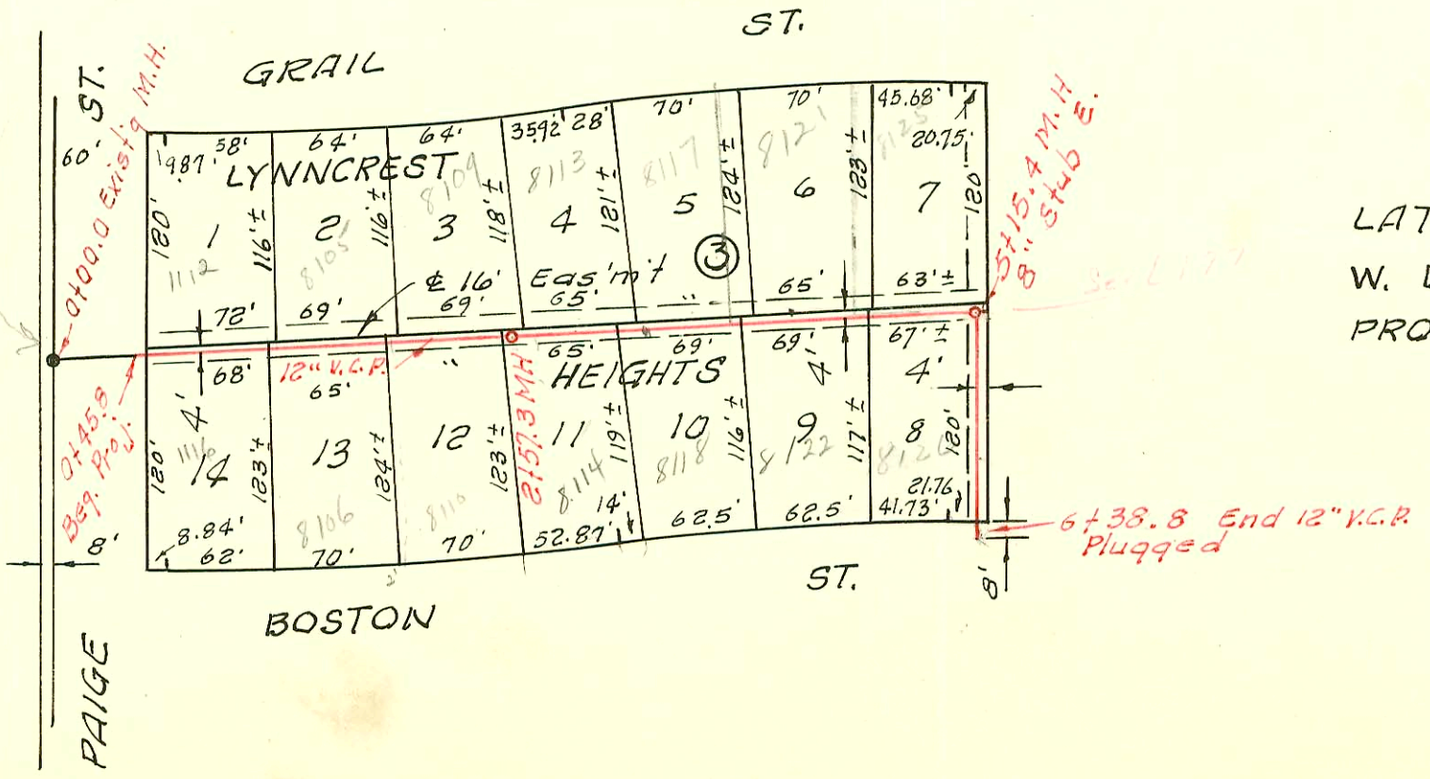

LAT. 4, SUB. 11, W. I. S.
W. B. CARTER CONST. CO. INC.
PROJ. NO. C25-40, BK. NO. K-72
4-28-66

K-11.

Form 41-(54) 7-60

CONSTRUCTION RECORD / SERVICE RECORD

	STATION	ELEVATION Ground	ELEVATION Grade	Depth	MANHOLE	4-INCH "Y" BRANCHES North West	4-INCH "Y" BRANCHES South East	No. of Permit North West	No. of Permit South East	House Number North West	House Number South East	DATE OF PERMITS North West	DATE OF PERMITS South East
LINE NO. 1	0+00	145.4	131.90	13.5	0+00.0 Existg M.H.								
	1+00	145.6	132.60	13.0									
		145.4	132.97	13.4	1+53 ℄								
	2+00	145.2	133.30	11.9									
						2+47 ℄		B4564		1109 S. Paige		11-18-65	
						2+93 ℄		B4565		1113 S. Paige		11-18-65	
	3+00	145.0	134.00	11.0									
		145.0	134.09	10.9	3+13 ℄								
						3+67 ℄		B4566		1117 S. Paige		11-18-65	
	4+00	143.6	134.90	9.7									
						4+13 ℄		B4567		1121 S. Paige		11-18-65	
		143.1	135.05	8.0	4+37 ℄								
	5+00	142.7	135.30	7.4									
						5+27 4							
						5+68 5							
	6+00	142.7	135.70	7.0	6" Tap			C7068		1201-09 So Paige		2-27-68	
		142.7	135.74	7.0	6+09 ℄								
						6+50 5							
						6+86 ℄							
	7+00	142.5	136.10	6.4	TAP	7+17 7/6		23764 C7069		1217 S. R Paige		8-16-89 2-27-68	
						7+52 6							
	8+00	142.8	136.50	6.3									
		142.5	136.52	6.0	8+06 ℄	M.H. Inp		C29007		1229 S. Paige		11-15-71	
LINE NO. 2	0+00	145.5	134.17	11.3	0+00 ℄ Line #2 = 3+13 ℄ Line #1								
	0+45.2	146.2	134.45	11.7	End 12" V.C.P.								
LINE NO. 3	0+00	144.2	135.12	9.1	0+00 ℄ Line #3 = 4+37 ℄ Line #1								
	0+62 ℄	144.9	135.38	9.5	End 8" V.C.P.								
LAT. 4.	SUB. 11, W. I. S.												
	0+00	146.2	132.85	13.3	0+00 ℄ Existg MH.								
	0+45.8	Beg. proj.											
	0+45.8	147.2	134.45	12.7									
						0+67 3	0+64 3	#C4248	#C4249	1112 Paige	1116 Paige	8-4-67	8-4-67
	1+00	150.2	136.35	13.8									
						1+40 8	1+37 8	#C8167	C17060	8105 E. Grail	8106 E. Boston	5-6-68	11-24-69
	2+00	153.2	139.85	13.3									
						4" PVC40 2+04.3 Wye 2+07 8	2+04 8	93-269714-7 #C3295		8109 E. Grail		10-18-93 R 5-25-67	
		153.7	141.86	11.8	2+57 3		2+43 3		C18242		8110 E. Boston		3-4-70
						2+69 8	2+66 8	#C2918	C24728	8113 E. Grail	8114 E. Boston	5-1-67	6-3-71
	3+00	154.4	142.15	13.3									
						3+35 8	3+32 8	C9776	C29451	8117 E. Grail	8118 E. Boston	7-24-68	12-14-71
	4+00	155.7	142.85	12.8									
						4+12.7 4+09 6	4+06 6	96-170090-7 B5555	C30516	8121 B Grail	8122 E Boston	10-14-96 5-3-66	2-18-72
						4+68 8	4+65 8	26603 B5554	C30517	8125 B Grail	8126 E Boston	11-26-98 5-3-66	2-18-72
	5+00	157.8	143.55	14.2									
		158.2	143.66	14.5	5+15 4	8" Stub E.							
	6+00	156.3	144.00	12.3									
	6+38.8	155.5	144.16	11.3									
	6+38.8	End 12" V.C.P.											