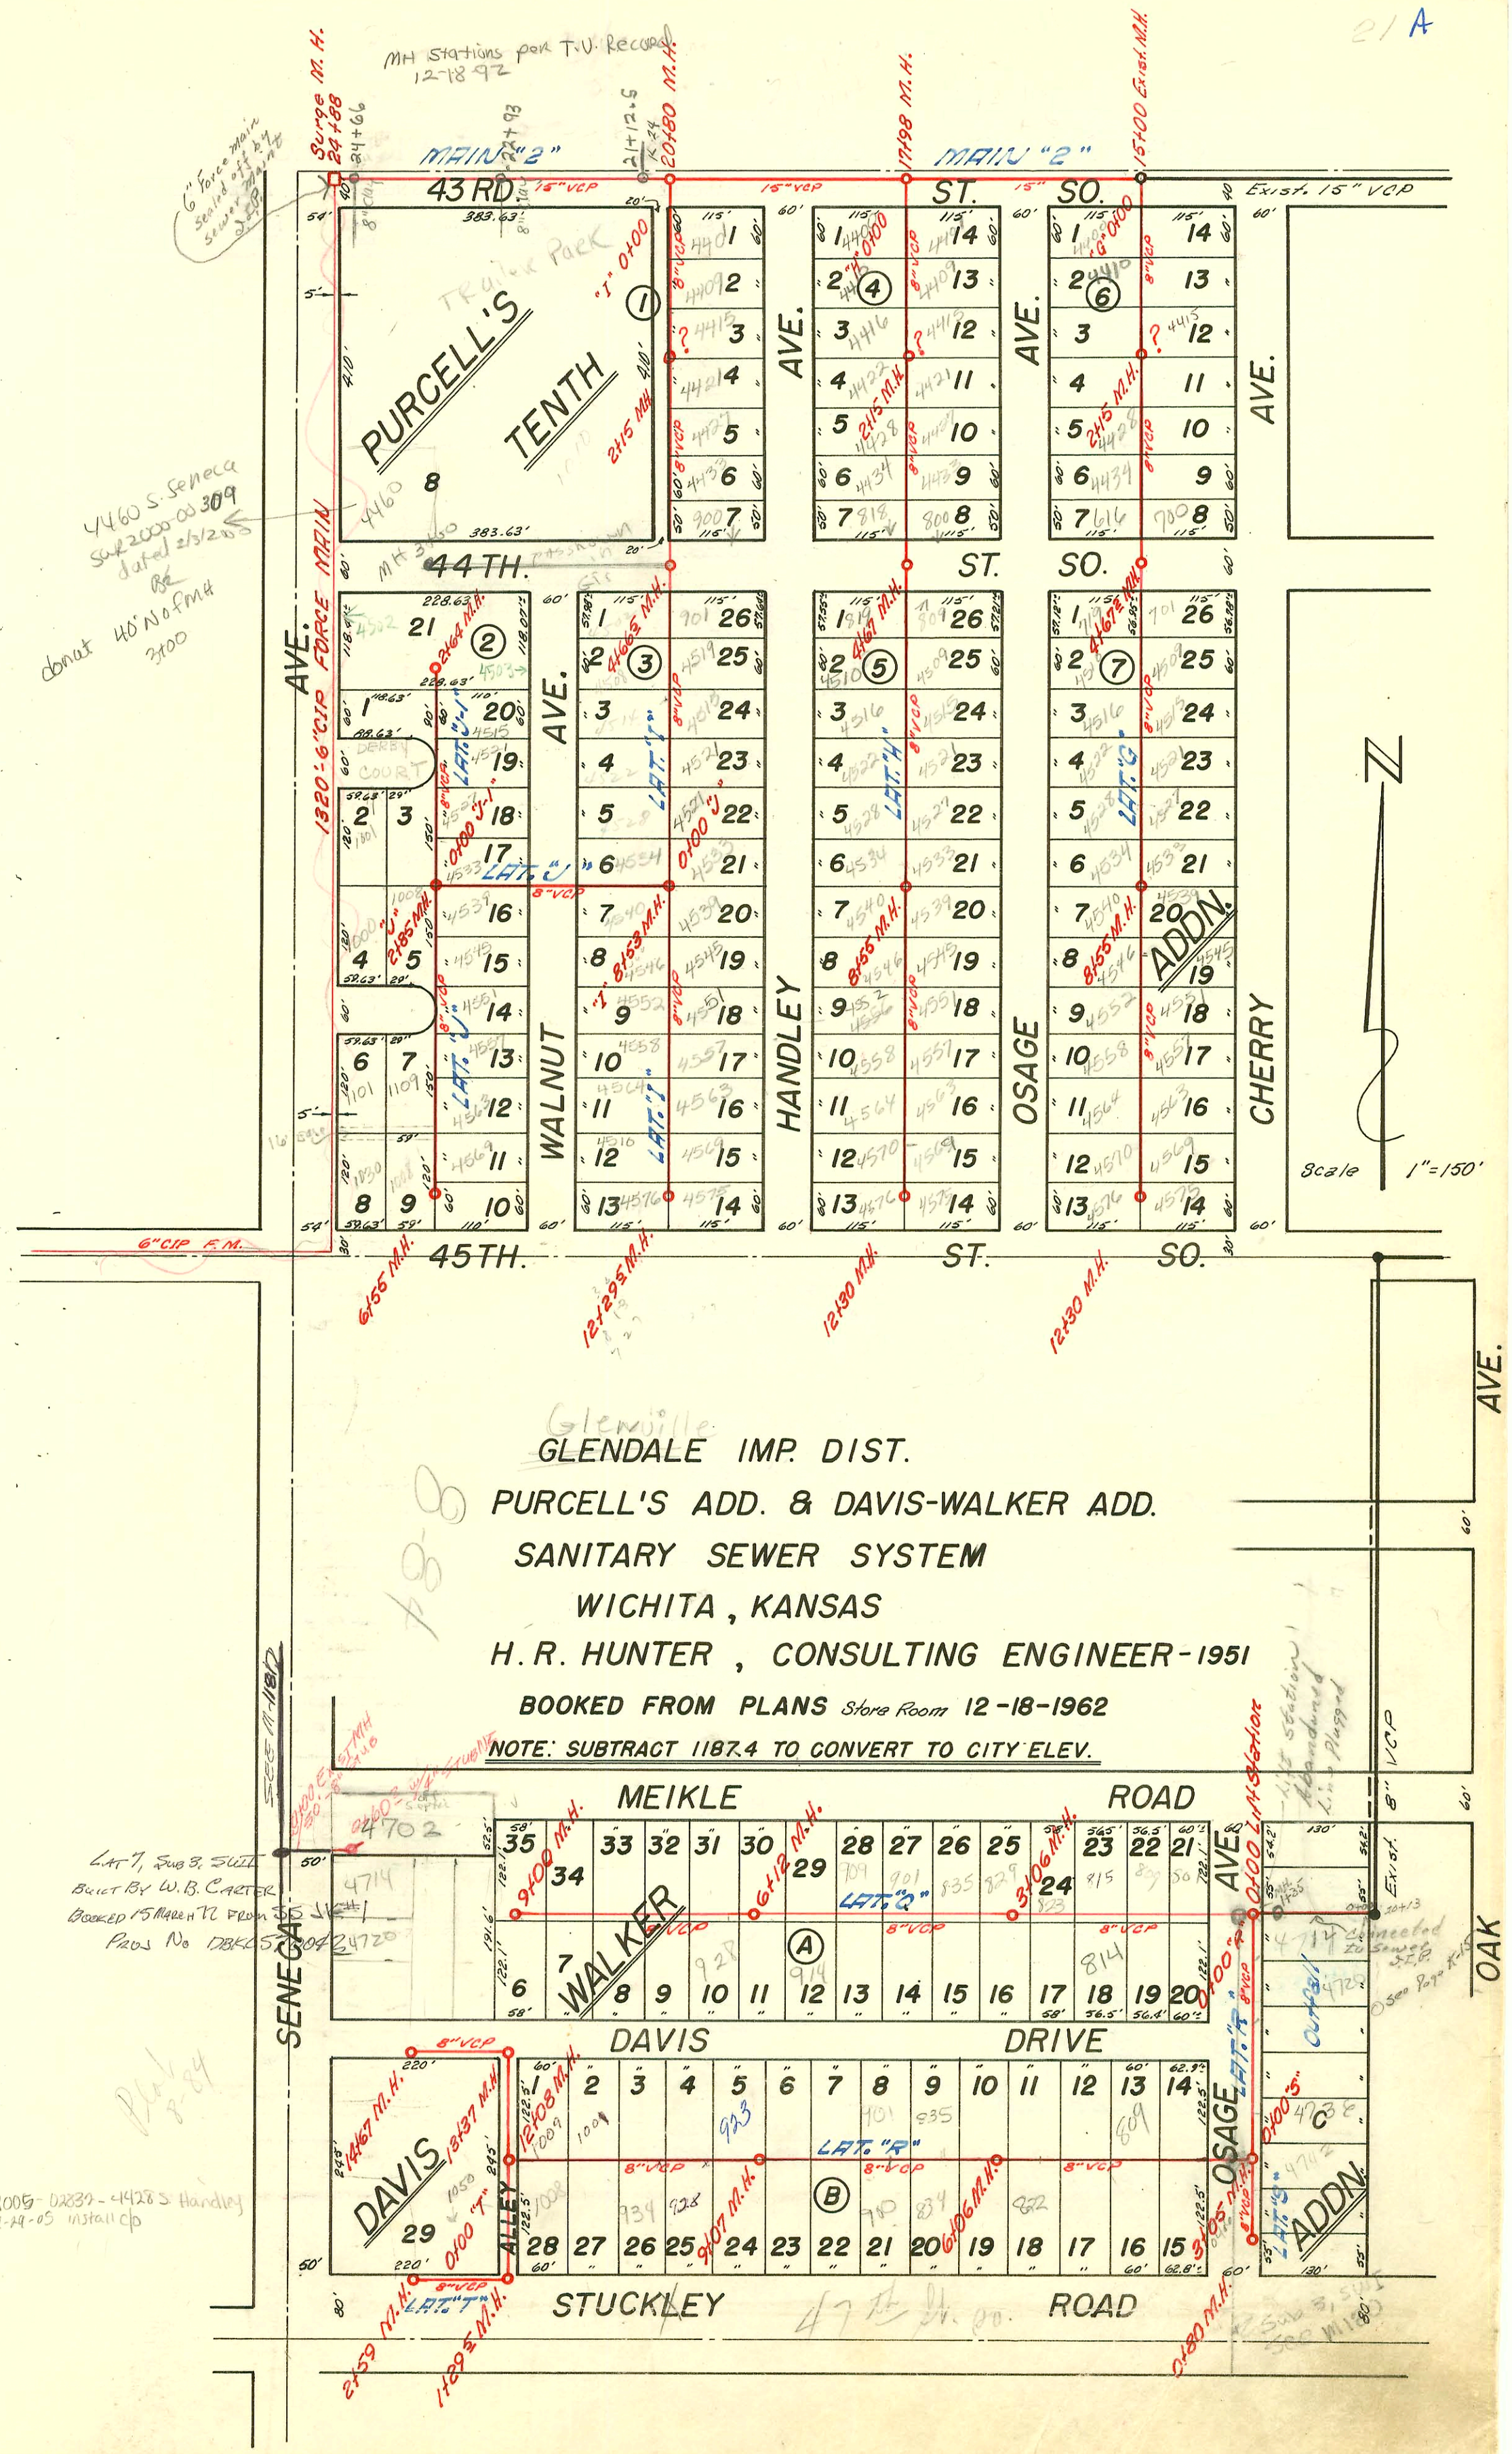
43RD. ST. SO.
44TH. ST. SO.
45TH. ST. SO.
MEIKLE ROAD
DAVIS DRIVE
STUCKLEY ROAD
SENECA AVE.
WALNUT AVE.
HANDLEY AVE.
OSAGE AVE.
CHERRY AVE.
OAK AVE.
PURCELL'S TENTH
WALKER ADDN.
DAVIS ADDN.
DERBY COURT
ALLEY
MAIN "2"
Surge M.H. 24+88
20+80 M.H.
17+98 M.H.
15+00 Exist. M.H.
Exist. 15" VCP
1320'-6" CIP FORCE MAIN
6" CIP F.M.
Scale 1"=150'
GLENDALE IMP. DIST.
PURCELL'S ADD. & DAVIS-WALKER ADD.
SANITARY SEWER SYSTEM
WICHITA, KANSAS
H. R. HUNTER, CONSULTING ENGINEER-1951
BOOKED FROM PLANS Store Room 12-18-1962
NOTE: SUBTRACT 1187.4 TO CONVERT TO CITY ELEV.

K-21

Form 41-(54) 7-60

CONSTRUCTION RECORD							SERVICE RECORD					
STATION	ELEVATION		Depth	MANHOLE	4-INCH "Y" BRANCHES		No. of Permit		House Number		DATE OF PERMITS	
	Ground (Note: Sea Level Elev's)	Grade			North West	South East	North West	South East	North West	South East	North West	South East
MAIN 2 CONTINUED FROM PAGE K-15												
15+00	76.8	69.30	7.5	Exist. 15+00º								
16+00	77.0	69.40	7.6									
17+00	77.5	69.50	8.0									
	77.5	69.59	7.9	17+89º								
18+00	77.0	69.60	7.4									
19+00	77.0	69.70	7.3									
20+00	77.0	69.80	7.2									
		69.88	7.1	20+80º								
Note: Main "2" Continued on Page K-24												
LAT. "G"												
0+00	76.8	out 69.30 in 71.10	7.5 5.7	Exist. 0+00º								
					0+46º	0+43º						
1+00	76.0	71.30	4.7									
					1+08º	1+05º						
					1+73º	1+70º						
2+00	76.3	71.50	4.8									
Note: Not Shown on Profile Plan ← 2+15º?												
					2+28º	2+25º						
					2+93º	2+90º						
3+00	76.2	71.70	4.5									
					3+57º	3+54º						
					3+93º	3+90º						
4+00	76.1	71.90	4.2									
	76.0	72.04	4.0	4+67º								
5+00	75.8	72.10	3.7									
					5+34º	5+31º						
					5+88º	5+85º						
6+00	75.7	72.30	3.4									
					6+38º	6+35º						
					6+88º	6+85º	#01757		4521 S. Cherry R		11-6-80	
7+00	76.2	72.50	3.7									
					7+62º	7+59º			4528 S. Handley			
8+00	77.0	72.70	4.3									
					8+22º	8+19º	C37170	(repair)	4534 S. Handley		2-13-73	
	77.0	72.82	4.2	8+55º								
					8+80º	8+77º						
9+00	76.8	72.90	3.9									
					9+36º	9+33º						
					9+94º	9+91º						
10+00	76.7	73.10	3.6									
					10+60º	10+57º						
11+00	77.8	73.30	4.5									
					11+16º	11+08º	C47416	(rep)	4564 S. Handley		11-18-74	
					11+78º	11+75º						
12+00	78.8	73.50	5.3					14925		4569 Cherry R		10-30-85
					12+25º	12+22º						
	78.9	73.57	5.3	12+30								
Lat. 7, Sub 3, SWI. 0+00	87.7	82.60	5.1	0+00 Exist MH w/50'-8" Stub E								
	87.7	82.80	4.9	0+60º MH w/4" Stub NE				98-42487		4702 S. Seneca		3-20-95
LAT. "H"												
0+00	77.9	out 69.59 in 70.90	8.3 7.0	Exist. 0+00º								
					0+53º	0+50º						
1+00	76.2	71.10	5.1									
					1+11º	1+08º						
					1+65º	1+62º						
2+00	76.2	71.30	4.9									
Note: Not Shown on Profile Plan ← 2+15º?												
					2+33º	2+31º						
					2+87º	2+84º						
3+00º	75.9	71.50	4.4									
					3+51º	3+48º						
					3+91º	3+89º						
4+00	75.6	71.70	3.9									
	75.7	71.84	3.9	4+67º								
5+00	75.8	71.90	3.9		5+40º	5+37º						
					5+80º	5+77º						
6+00	76.0	72.10	3.9									
					6+43º	6+40º						
7+00	75.7	72.30	3.4		7+03	7+00						

Lat. 7, Sub 3, SWI.

Misilroy - Tapes #3107 - Plan Pg. 22

Taps - trailer at 1010 W. 44th St. So. - Darrell Williams 6-7-64. - Permit # B1332 (3+91.5)
" # B1333 (3+18.5)
" # B1334 (2+38.5)
" # B1335 (1+35.5)
" # B1336 (0+77.5)
" # B1337
" # B1338
" # B1339
" # B1340
" # B1341