


MONA KAY MATLOCK  
53 RD. ST. SO. AVE.

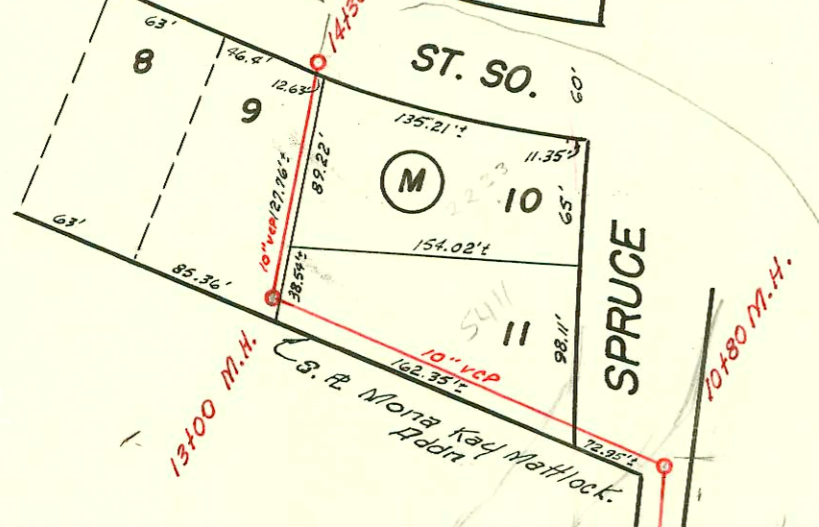

Common address of  
1904 to 5445



SPRUCE ST

5432  
5440  
5446  
5450  
5456  
5460

20' Impress Egress Rd.  
Wichita & Valley Center Riverside Levee  
West Right of Way

Line Not in Street  
in Rear

SCALE 1"=100'

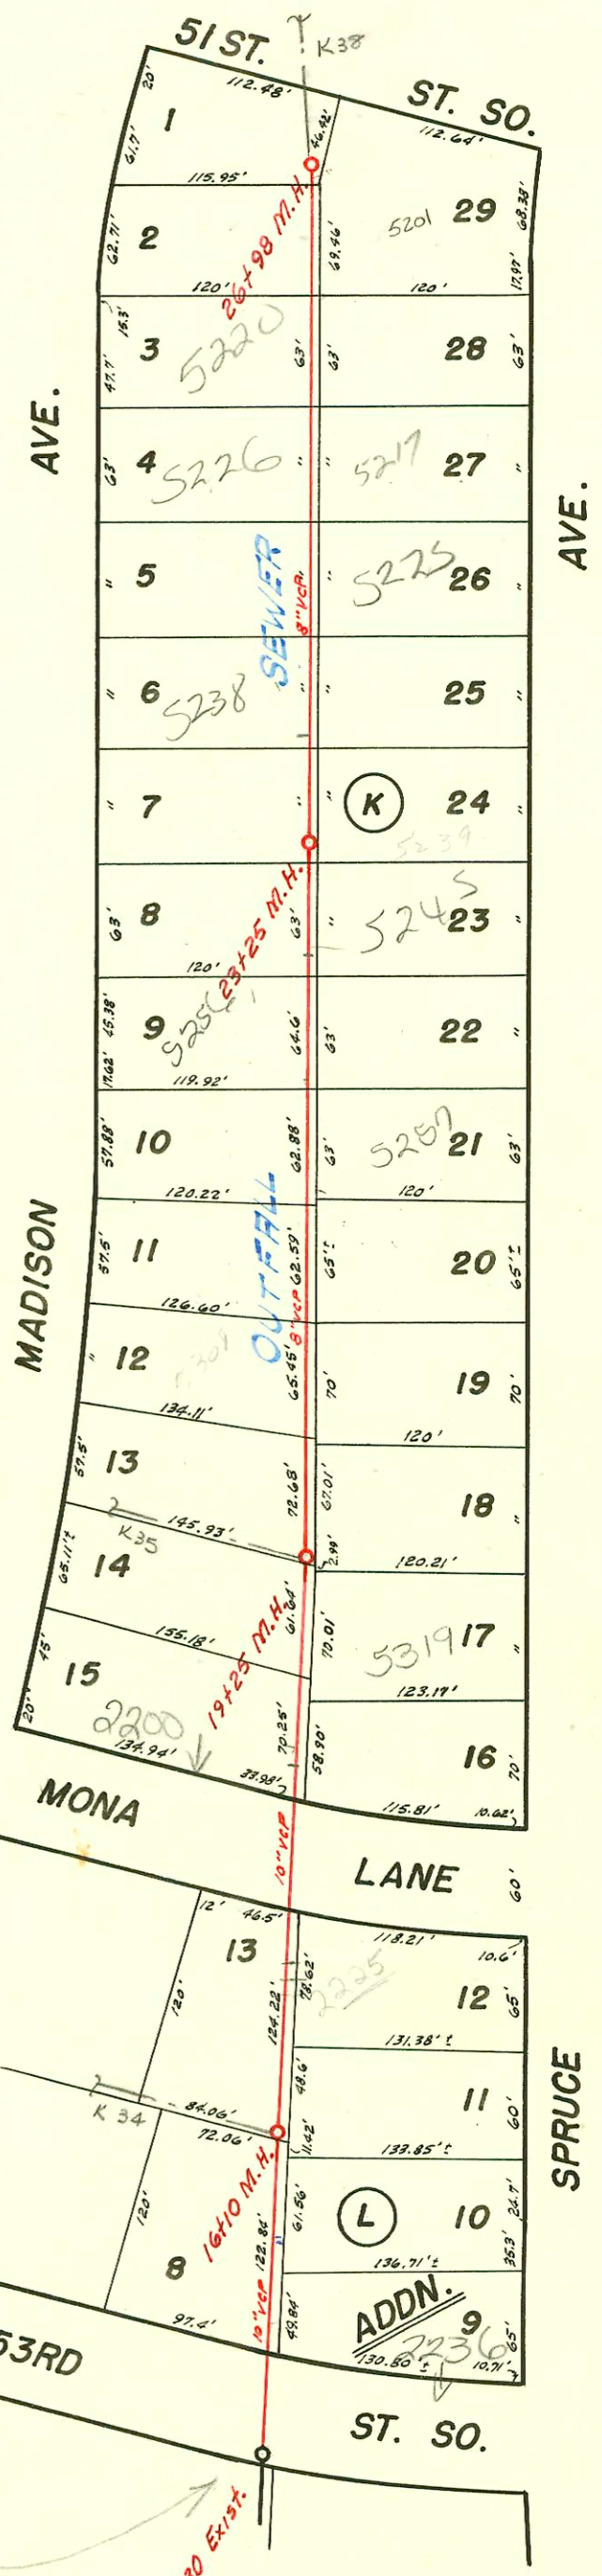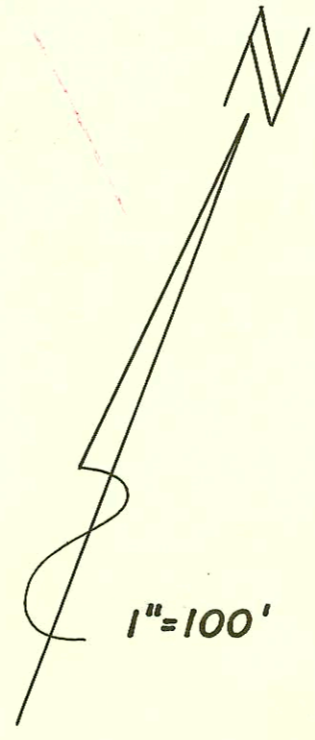

**SANITARY SEWER SYSTEM  
JAYHAWK IMPROVEMENT DISTRICT  
SEDGWICK COUNTY, KANSAS**

FLOYD B. DEVLIN: CONSULTING ENGINEER  
WICHITA, KANSAS 1955  
BOOKED FROM PLANS - JAN. 1963

