

HYDRAULIC

AVE.

PART OF JAYHAWK IMPROVEMENT DISTRICT

Start on lot 2
 only free
 (county containing
 for plat)
 304.47'

3000

22439.24 M.H.

23
 22
 21
 20
 19
 18
 17
 16
 15
 14
 13
 12
 11
 10
 9
 8
 7
 6
 5
 4
 3
 2
 1

F.A. BROWN

ST. SO.

FIFTIETH

MAIN A

SPRUCE

MADISON

ASH

MINNESOTA

KANSAS

AVE.

AVE.

AVE.

AVE.


ST.

SUNRISE

AVE.

ST. SO.

FIFTY FIRST

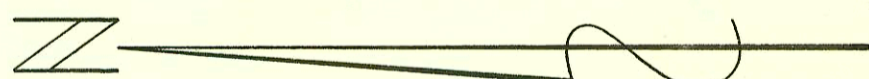

SCALE 1" = 100'

K33A

0100 East. M.H.

K32

CONSTRUCTION RECORD

SERVICE RECORD

STATION	ELEVATION		Depth	MANHOLE	4-INCH "Y" BRANCHES		No. of Permit		House Number		DATE OF PERMITS	
	Ground	Grade			North West	South East	North West	South East	North West	South East	North West	South East
MAIN "A"												
0+00	66.2	57.21	9.0	Exist. 0+00 ²								
1+00	66.2	57.41	8.8									
	66.2	57.42	8.8	1+05 ²								
2+00	66.2	57.61	8.6									
	66.2	57.66	8.6	2+25 ²								
3+00	66.1	57.81	8.3		2+50 ²	2+53 ²	C19567	C21870	5156 S. Madison	5153 S. Spruce	6-4-70	11-20-70
					3+18	3+21						
					3+21 ²	3+24 ²	C17129	C21429	5148 S. Madison	5147 S. Spruce	12-1-69	10-21-70
					3+90 ²	3+93 ²	C18466		5142 S. Madison		3-23-70	
4+00	66.0	58.01	8.0		3+87 ²	3+87 ²		C21650	5139 S. Spruce		11-5-70	
					4+80 ²	4+83 ²		C16415	5136 S. Madison	5133 S. Spruce	10-22-69	2-16-71
5+00	65.8	58.21	7.6									
	66.0	58.27	7.7	5+29 ²								
					5+48 ²	5+51 ²		9374	5130 Madison		10-5-83	
					6+44 ²	6+62 ²		C20626	5127 Madison	5125 S. Spruce		8-19-70
6+00	66.2	58.41	7.8		7+00 ²	7+03 ²	C21033	C21649	5119 S. Madison	5117 S. Spruce	7-12-71	11-5-70
7+00	66.2	58.61	7.6		7+78 ²	7+81 ²	C19298	C21428	5114 S. Madison	5113 S. Spruce	5-14-70	10-27-70
8+00	66.5	58.81	7.7									
	66.6	58.97	7.6	8+87 ²								
	66.6	59.07	7.5									
9+00	66.6	59.11	7.5									
10+00	66.5	59.31	7.2									
11+00	66.5	59.51	7.0									
	66.5	59.64	6.9	11+66 ⁵⁶								
12+00	66.6	59.71	6.9					26851	2116 R. E. 50th St.		1-8-91	
13+00	66.7	59.91	6.8									
14+00	66.8	60.11	6.7									
	67.0	60.27	6.7	14+81 ⁵⁶								
15+00	67.0	60.33	6.7									
16+00	67.0	60.63	6.4									
17+00	67.0	60.93	6.1									
18+00	67.0	61.23	5.8									
	67.0	61.40	5.6	18+58 ⁵⁶								
19+00	67.0	61.53	5.5									
20+00	67.0	61.83	5.2									
21+00	67.0	62.13	4.9									
22+00	66.8	62.43	4.4									
	66.8	62.54	4.3	22+39 ⁵⁶								
LAT. A-1												
0+00	66.0	57.76	8.2	Exist. 0+00 ²	221 E. E. Side of Driveway			C21772	221 E. E. 50th St.		3-5-81	
	66.0	58.04	8.0	0+70 ² LH								
LAT. A-2												
0+00	66.2	59.07	7.1	Exist. 0+00 ²								
	66.4	59.35	7.1	0+70 ²								

19894-5167 S Spruce - 12/22/87 - Rep (18' Section of line) (at house site)