

HYDRAULIC

AVE.

PART OF JAYHAWK IMPROVEMENT DISTRICT

Start on lot 2
 only free
 (county) for
 hydraulic
 3000

22-139-24 M.H.

FIFTIETH

MAIN ST.

ST. SO.

LAT. 1

KANSAS

AVE.

SUNRISE

MINNESOTA

AVE.

ASH

AVE.

MADISON

SPRUCE


AVE.

FIFTY FIRST

ST.

SO.

SCALE 1"=100'

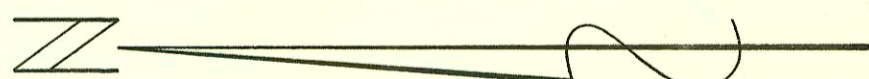

K33A

0100 East M.H.

112.64'

112.48'

112.64'

112.64'

112.64'

112.64'

112.64'

112.64'

112.64'

127.09'

127.09'

K

n