

HYDRAULIC

AVE.

PART OF JAYHAWK IMPROVEMENT DISTRICT

Start on lot 2
 only free
 (county) for
 hydraulic
 3000

22-139-24 M.H.

18-153-23 M.H.

14-81-26 M.H.

11-66-25 M.H.

0-170 L.H.
 5-87 M.H.

KANSAS

AVE.

SUNRISE

ST.

MINNESOTA

AVE.

FOURTH

FIFTY FIRST

ASH

AVE.

MADISON


SPRUCE

AVE.

ST.

SO.

SCALE 1"=100'

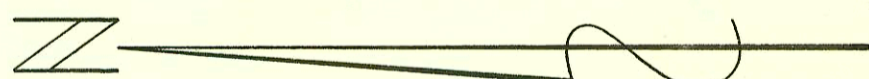

K33A

0-100 East M.H.
 K32

CONSTRUCTION RECORD						SERVICE RECORD						
STATION	ELEVATION		Depth	MANHOLE	4-INCH "Y" BRANCHES		No. of Permit		House Number		DATE OF PERMITS	
	Ground	Grade			North West	South East	North West	South East	North West	South East	North West	South East
LAT # 7 Continued												
11+00	66.3	62.91	3.4		10+74 ^o	10+72 ^o						
					11+38 ^o	11+36 ^o						
12+00	66.4	63.21	3.2	12+00 ^o	11+92 ^o	11+90 ^o	B2590	#6925	5100 S. Kansas	5120 S. Kansas	1-4-65	2-16-68
LAT. #7-A												
0+00	66.4	61.04	5.4	EXIST. 0+00 ^o	0+16 ^o	0+18 ^o						
					0+73 ^o	0+75 ^o	4239		5121 S. Ash		10-5-81	
	66.6	61.34	5.3	0+75 ^o L.H.								

C68297-Repair-2016 Sunrise-9-12-78-Granston (0+16)

