
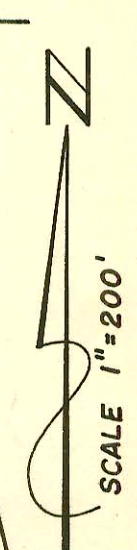


Western 9th Addition  
Block 10  
Lots 2, 3, 4, 5, 6, 7 & 8  
Spec. Fee + Sub. Fee paid \$1750.00  
M + B Construction Co.  
Forward Manager  
Rev. #27097

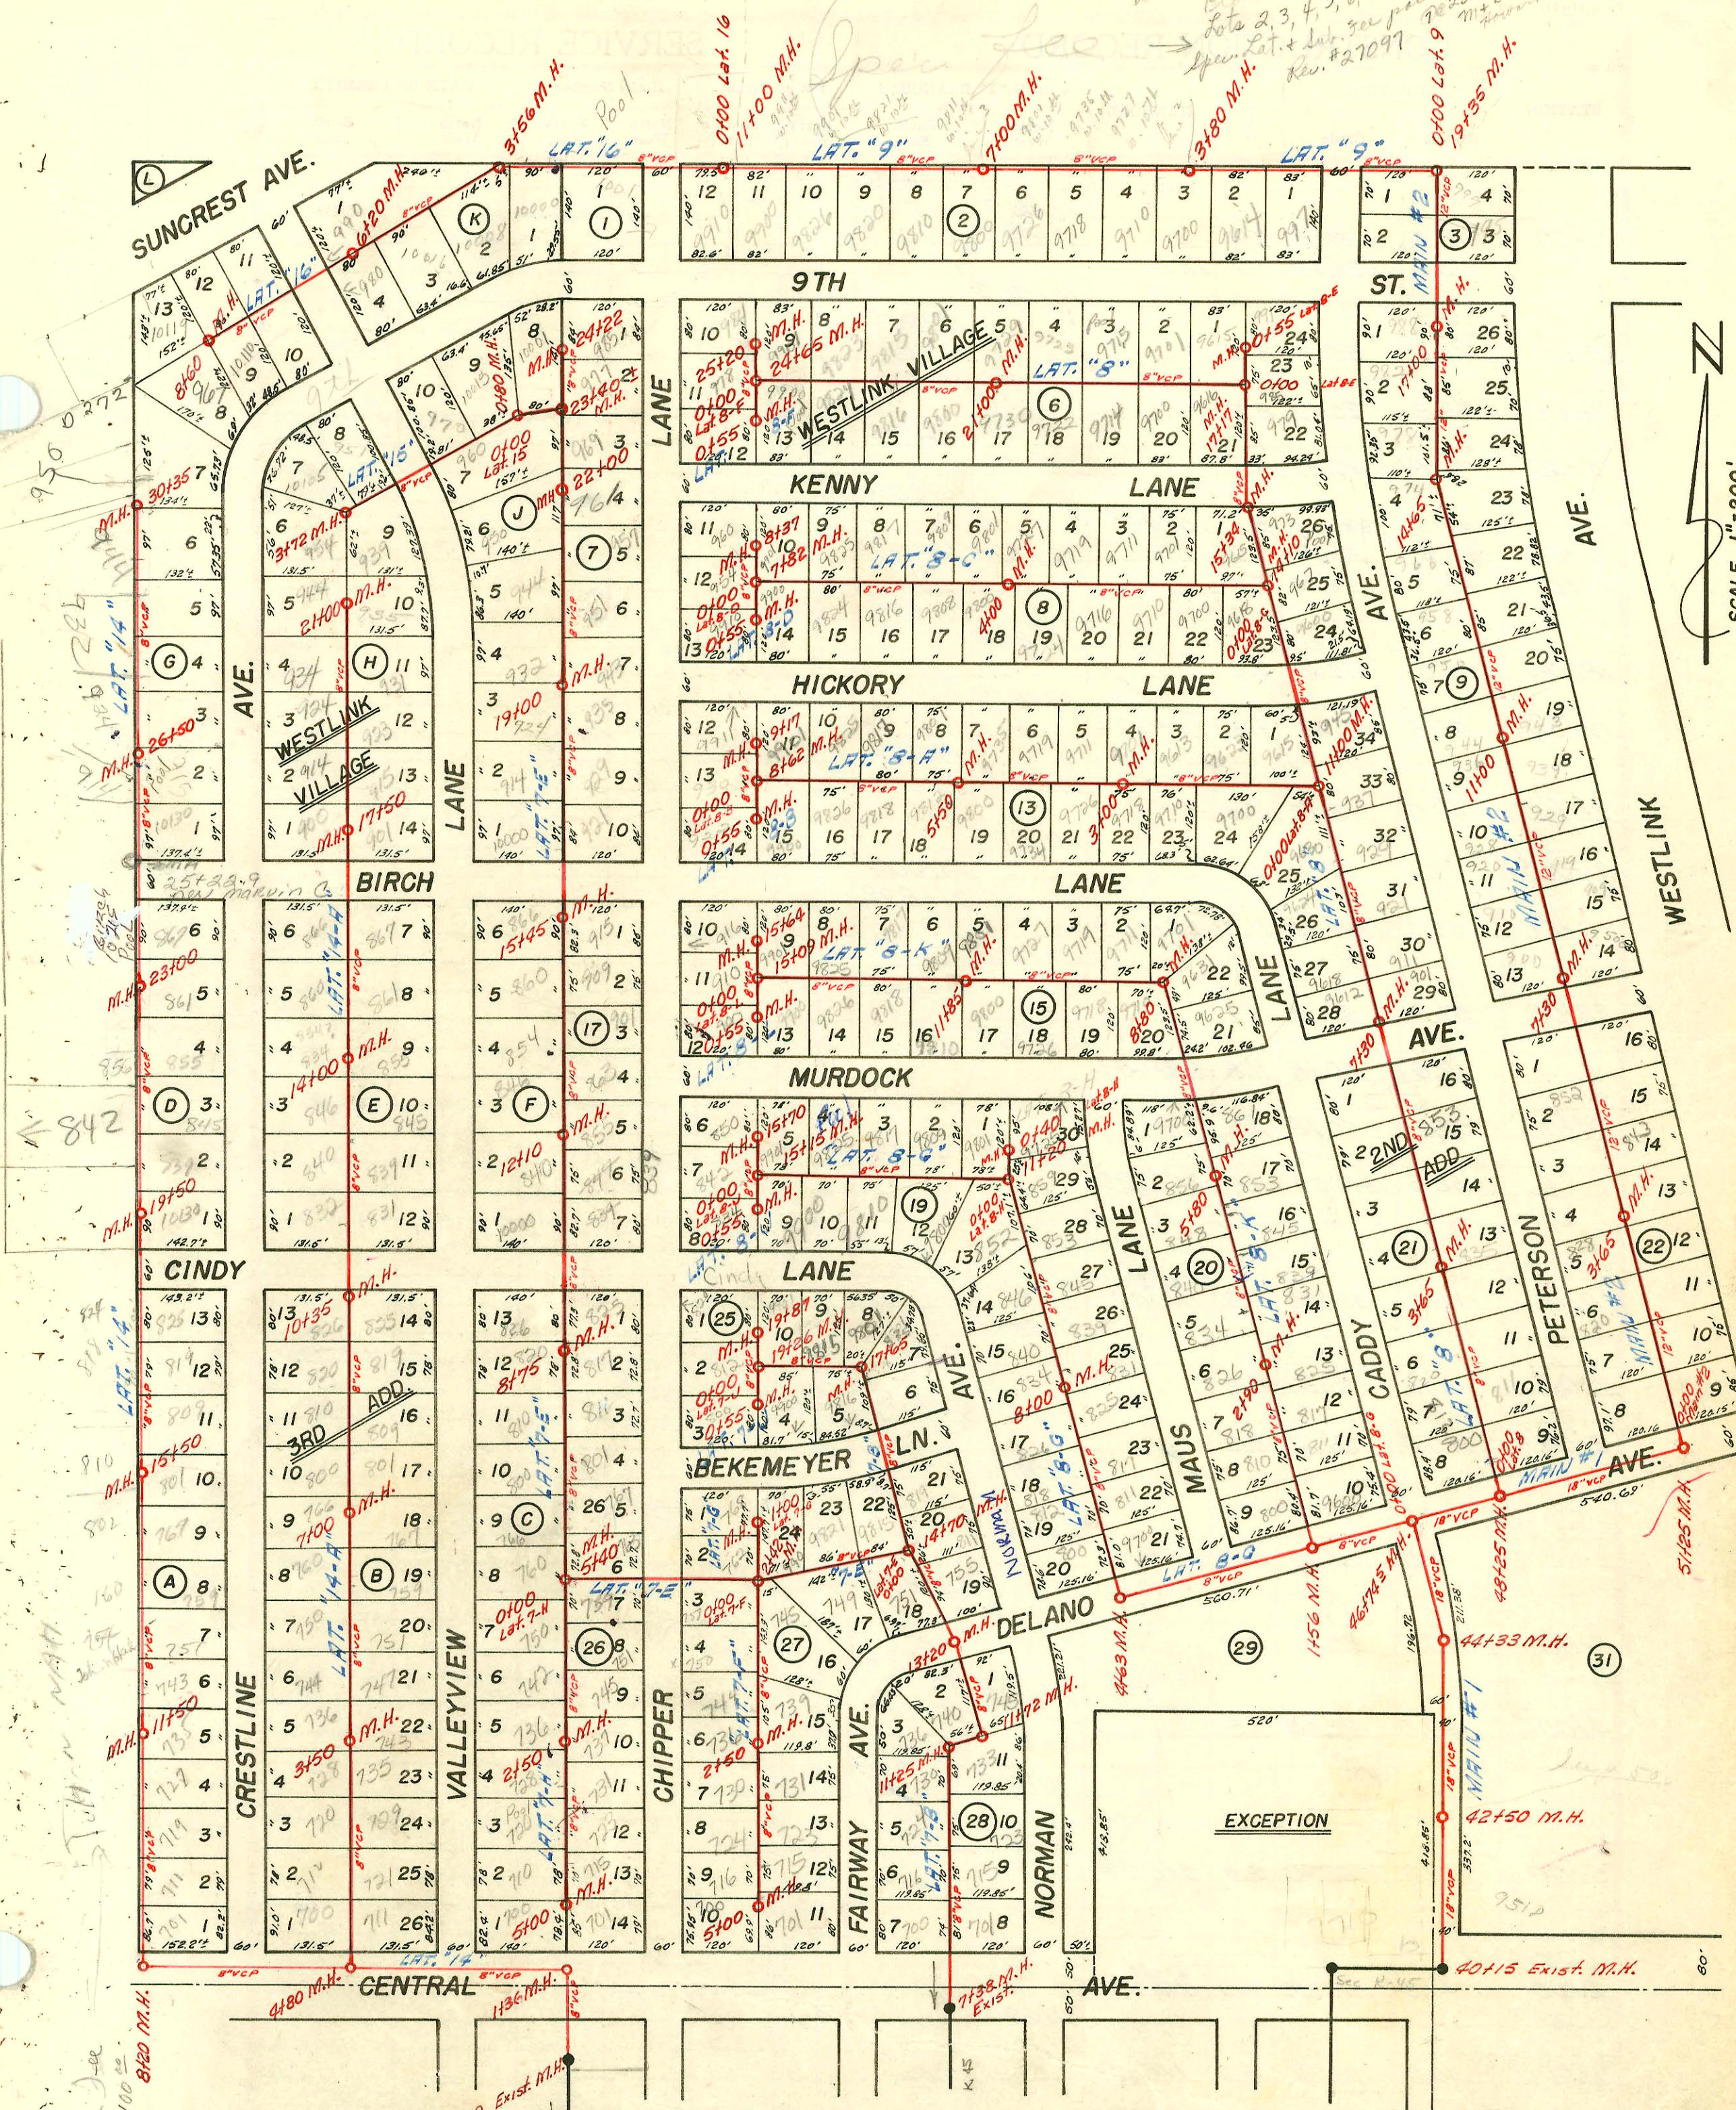

Special Fee  
for East side  
of Tah-n-hah

**SANITARY SEWER SYSTEM  
WESTLINK VILLAGE  
SEDGWICK COUNTY, KANSAS**

H. R. HUNTER CONSULTING ENGINEER  
WICHITA, KANSAS DATE: 3-7-55 (NOTE: SEA LEVEL ELEVATIONS)  
(BOOKED FROM PLANS JAN. 1963)

# 210159 424/9 90 in only - 17+72.0 top 4" SDK 35



