K 63A

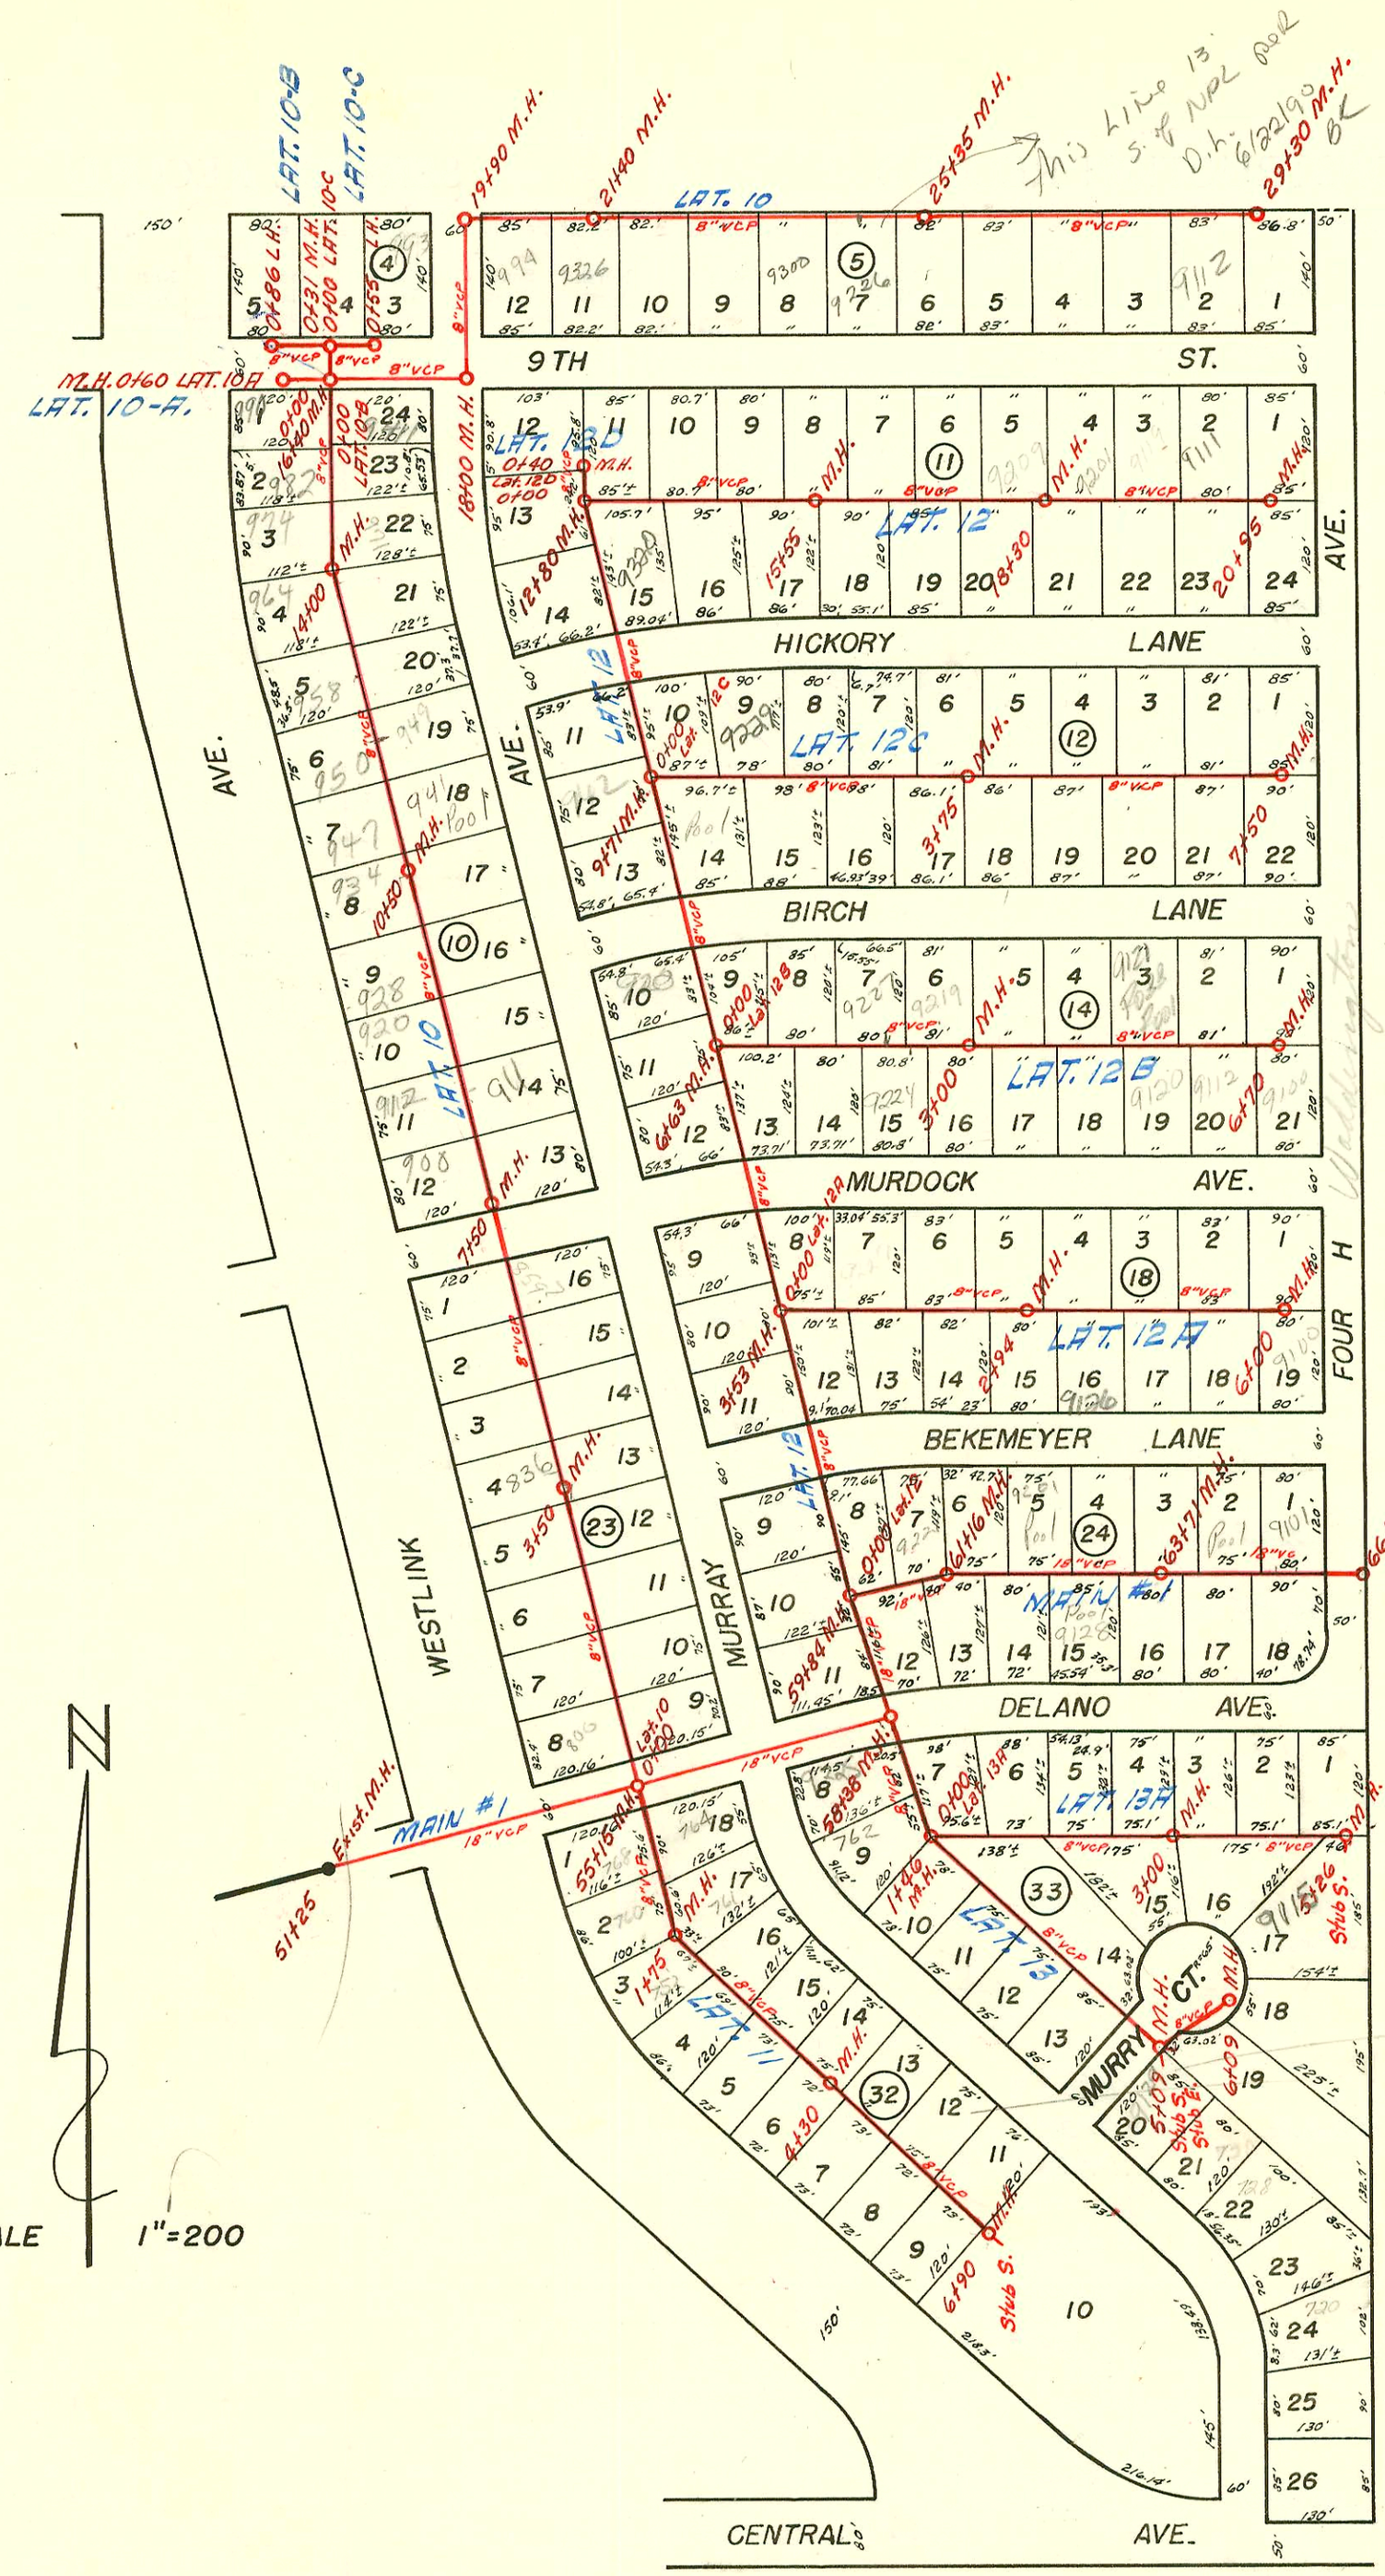

SANITARY SEWER SYSTEM
WESTLINK VILLAGE
SEDGWICK COUNTY, KANSAS

H. R. HUNTER CONSULTING ENGINEER

WICHITA, KANSAS DATE: 3-7-55 (NOTE: SEA LEVEL ELEVATIONS)

(BOOKED FROM PLANS JAN. 1963

65

Form 41-(54) 7-60

CONSTRUCTION RECORD							SERVICE RECORD					
STATION	ELEVATION		Depth	MANHOLE	4-INCH "Y" BRANCHES		No. of Permit		House Number		DATE OF PERMITS	
	Ground	Grade			North West	South East	North West	South East	North West	South East	North West	South East
	30.1	1322.16	7.9	4+30 ℄								
					4+98 ⅝	4+95 ⅝						
5+00	30.4	22.44	8.0									
					5+71 ⅝	5+68 ⅝						
6+00	30.8	22.84	8.0									
					6+42 ⅝	6+39 ⅝						
	30.8	1323.20	7.6	6+90 ℄		Stub 8.						
LAT. 12												
0+00	1331.3	1321.00	10.3	Exist. 0+00 ℄								
					0+28 ℄							
					0+98 ℄							
1+00	31.5	21.40	10.1									
2+00	31.5	21.80	9.7									
					2+49 ℄							
3+00	31.7	22.20	9.5									
					3+31 ℄							
	31.5	1322.41	9.1	3+53 ℄								
4+00	31.5	22.60	8.9									
					4+13 ℄							
5+00	32.0	23.00	9.0									
					5+76 ℄							
6+00	32.0	23.40	8.6									
					6+46 ℄							
	32.0	1323.65	8.4	6+63 ℄								
7+00	32.0	23.80	8.2									
					7+31 ℄				960 N. Murray	R		
8+00	32.7	24.20	8.5									
					8+67 ℄							
9+00	33.0	24.60	8.4									
					9+49 ℄							
	33.0	1324.88	8.1	9+71 ℄								
10+00	33.0	25.00	8.0									
					10+27 ℄							
11+00	33.0	25.40	7.6									
					11+68 ℄							
12+00	33.5	25.80	7.7									
					12+73 ℄							
	33.0	1326.12	6.9	12+80 ℄								
13+00	33.0	26.20	6.8									
						13+11 ℄						
					13+25 ℄							
					13+92 ℄							
14+00	34.3	26.60	7.7									
						14+26 ℄						
					14+65 ℄							
15+00	34.0	27.00	7.0									
						15+15 ℄						
	34.0	1327.22	6.8	15+55 ℄								
					15+65 ℄							
16+00	34.0	27.40	6.6									
						16+11 ℄						
					16+41 ℄							
						16+88 ℄						
17+00	33.2	27.80	5.4									
					17+15 ℄							
						17+86 ℄						
18+00	33.2	28.20	5.0		18+00 ℄	Repair	3805		9209 W. 9th		7-3-65	
	33.2	1328.32	4.9	18+30 ℄								
						18+59 ℄						
					18+78 ℄		B 3158		920 W. 9th		3-26-63	
19+00	33.5	28.60	4.9									
					19+51.0 wye	19+52 ℄	11712		9119 W. 9th		8-9-84	
					19+63 ℄							
20+00	34.0	29.00	5.0									
						20+30 ℄						
					20+40 ℄							
						20+83 ℄						
					20+99 ℄							
	34.5	1329.38	5.1	20+95 ℄								

65A