


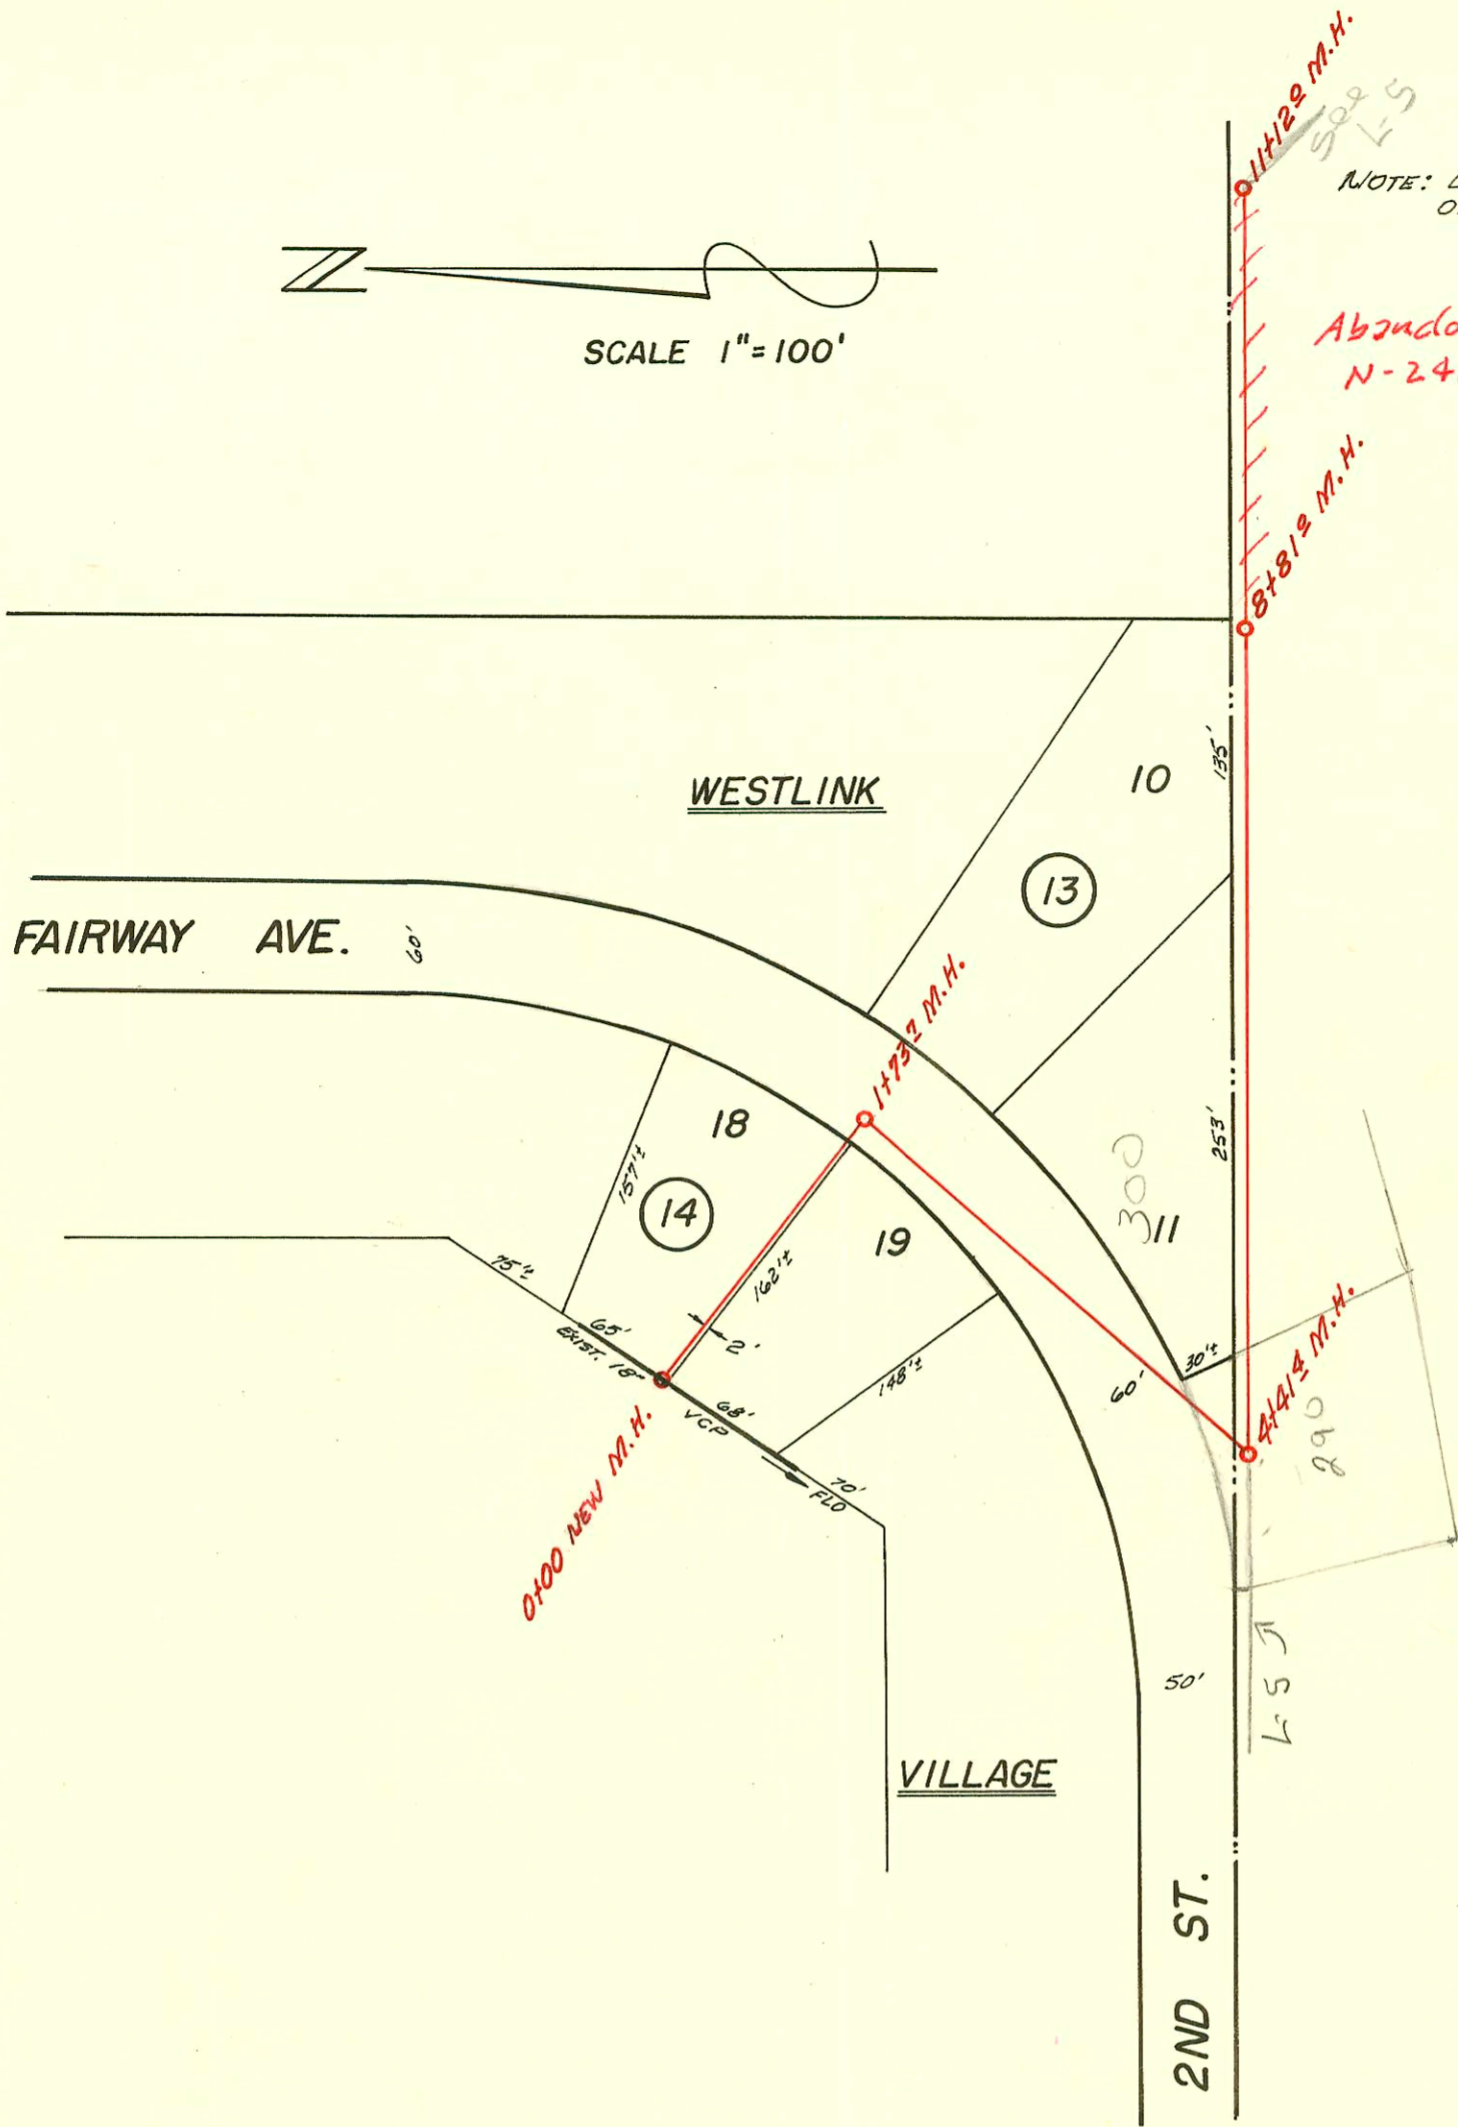

SCALE 1"=100'

NOTE: LINE SERVES PRO SHOP ON GOLF COURSE

Abandoned  
N-248



PART OF WESTLINK VILLAGE IMP. DIST.  
SAN. SEWER SYSTEM

