



E - Right
W - Left
N. Right
S. - Left

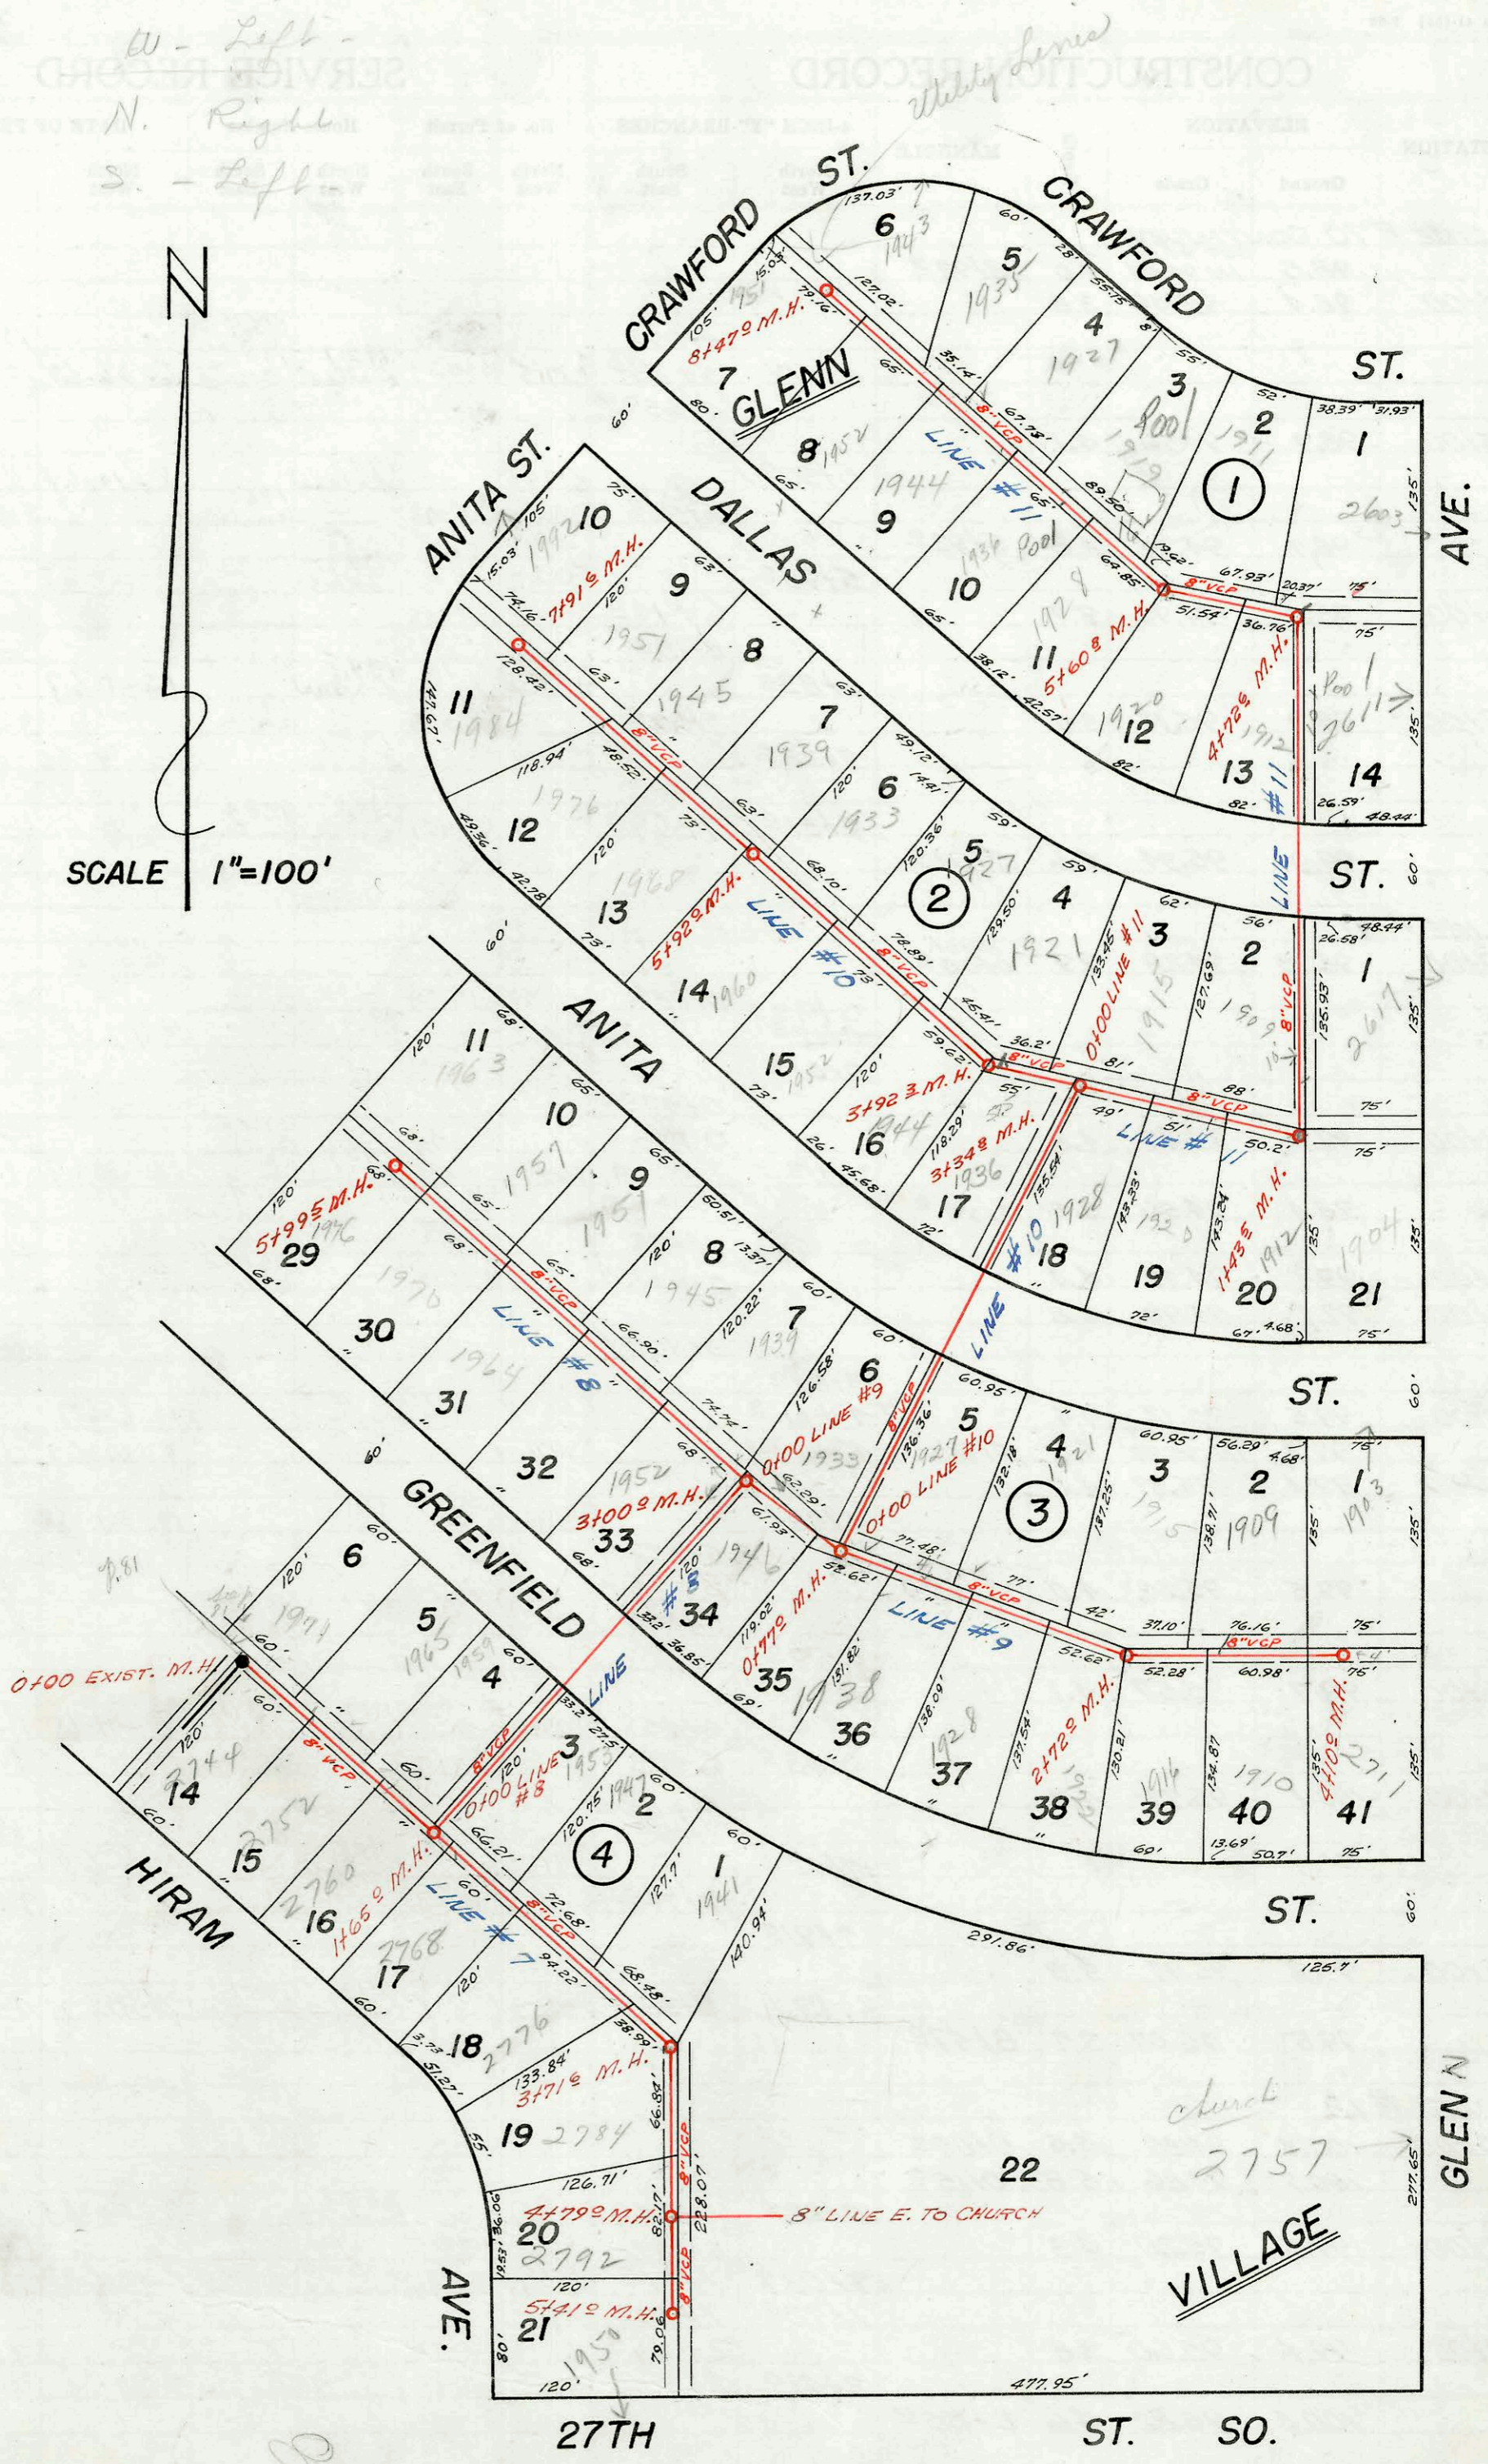

PART OF GLENN VILLAGE SANITARY SEWERS

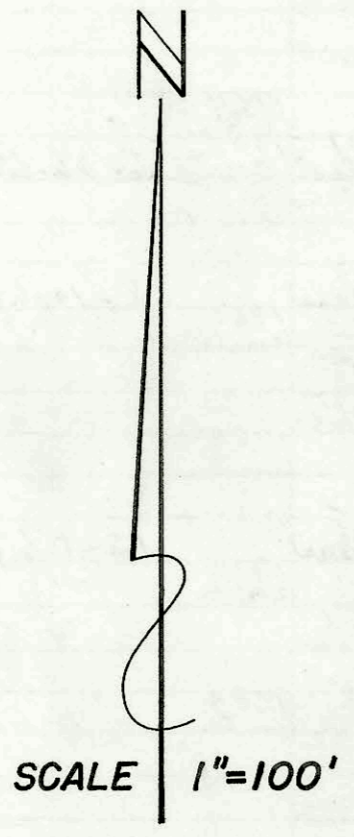