K-96A

Ext. St Jude S.S
Private Contract
Booked 9-11-64

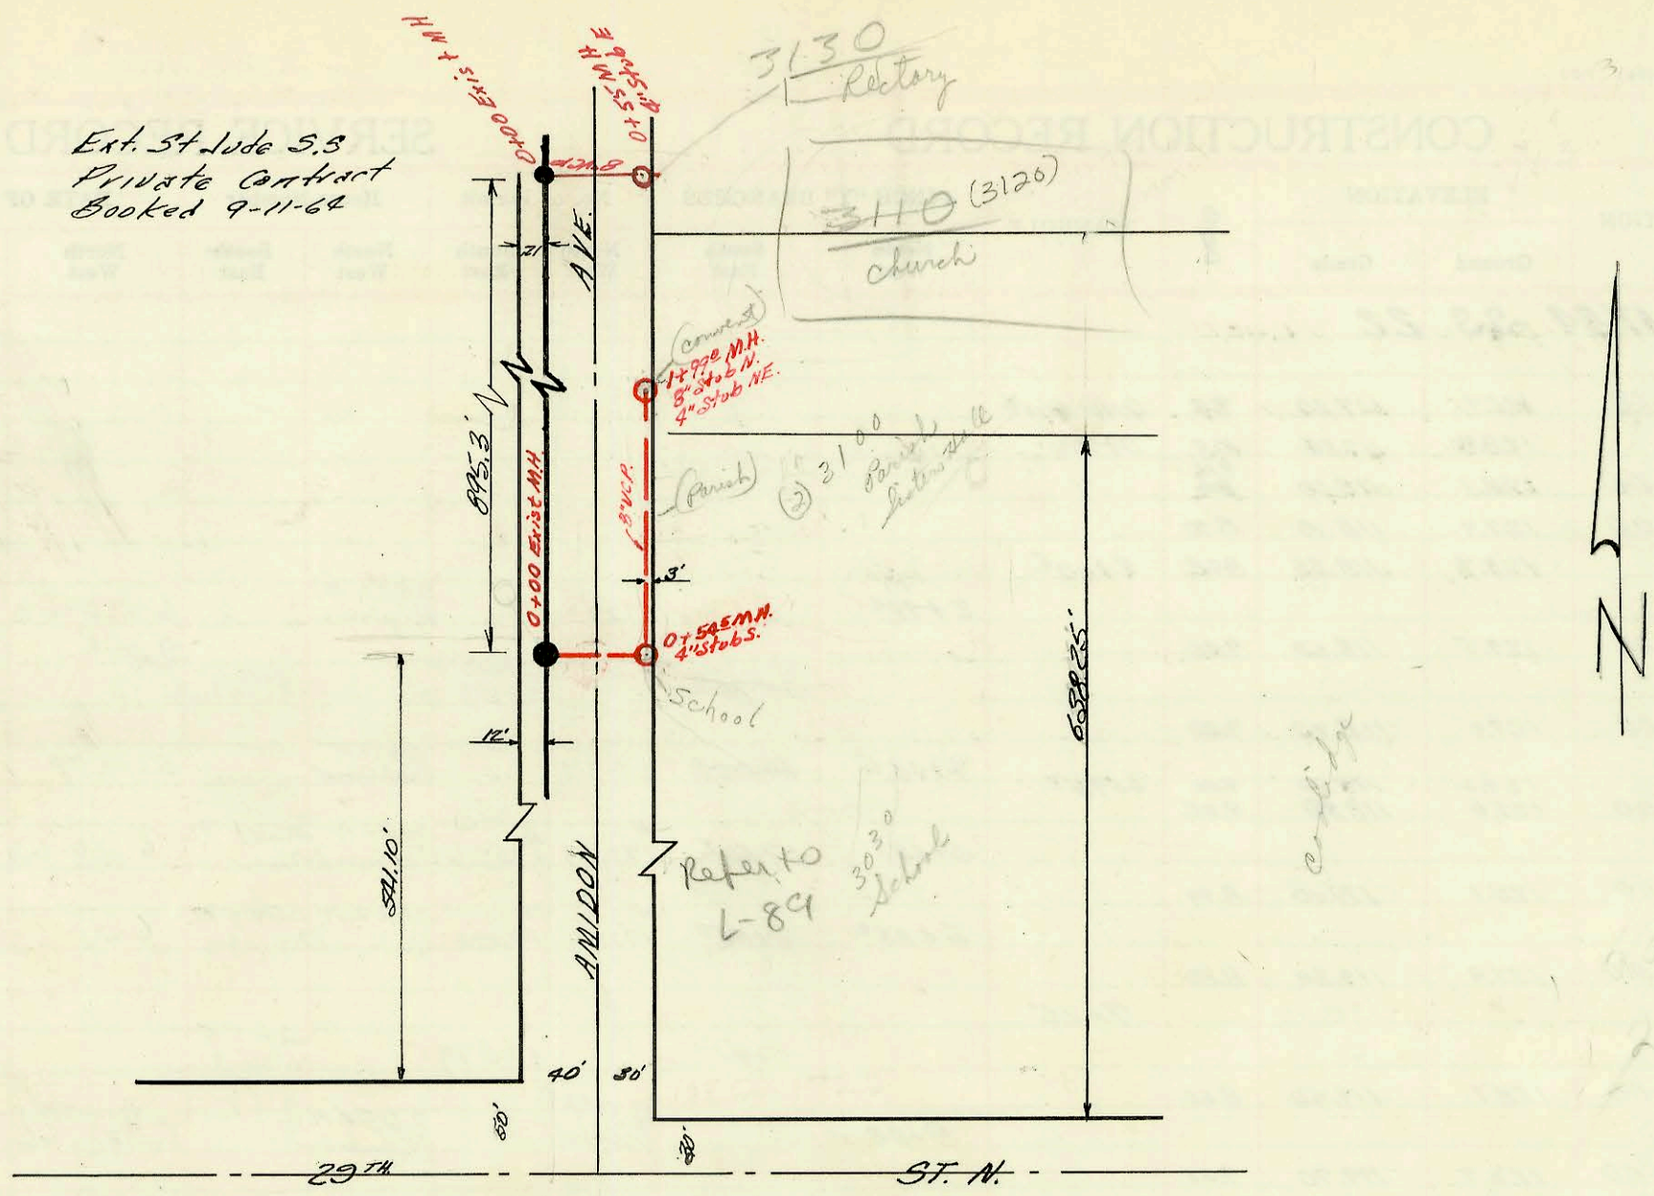

ST. JUDE SAN. SEWER
W.B. Carter Constr. Co. Inc.
Private Contract K-80 Booked 6-11-63

1963

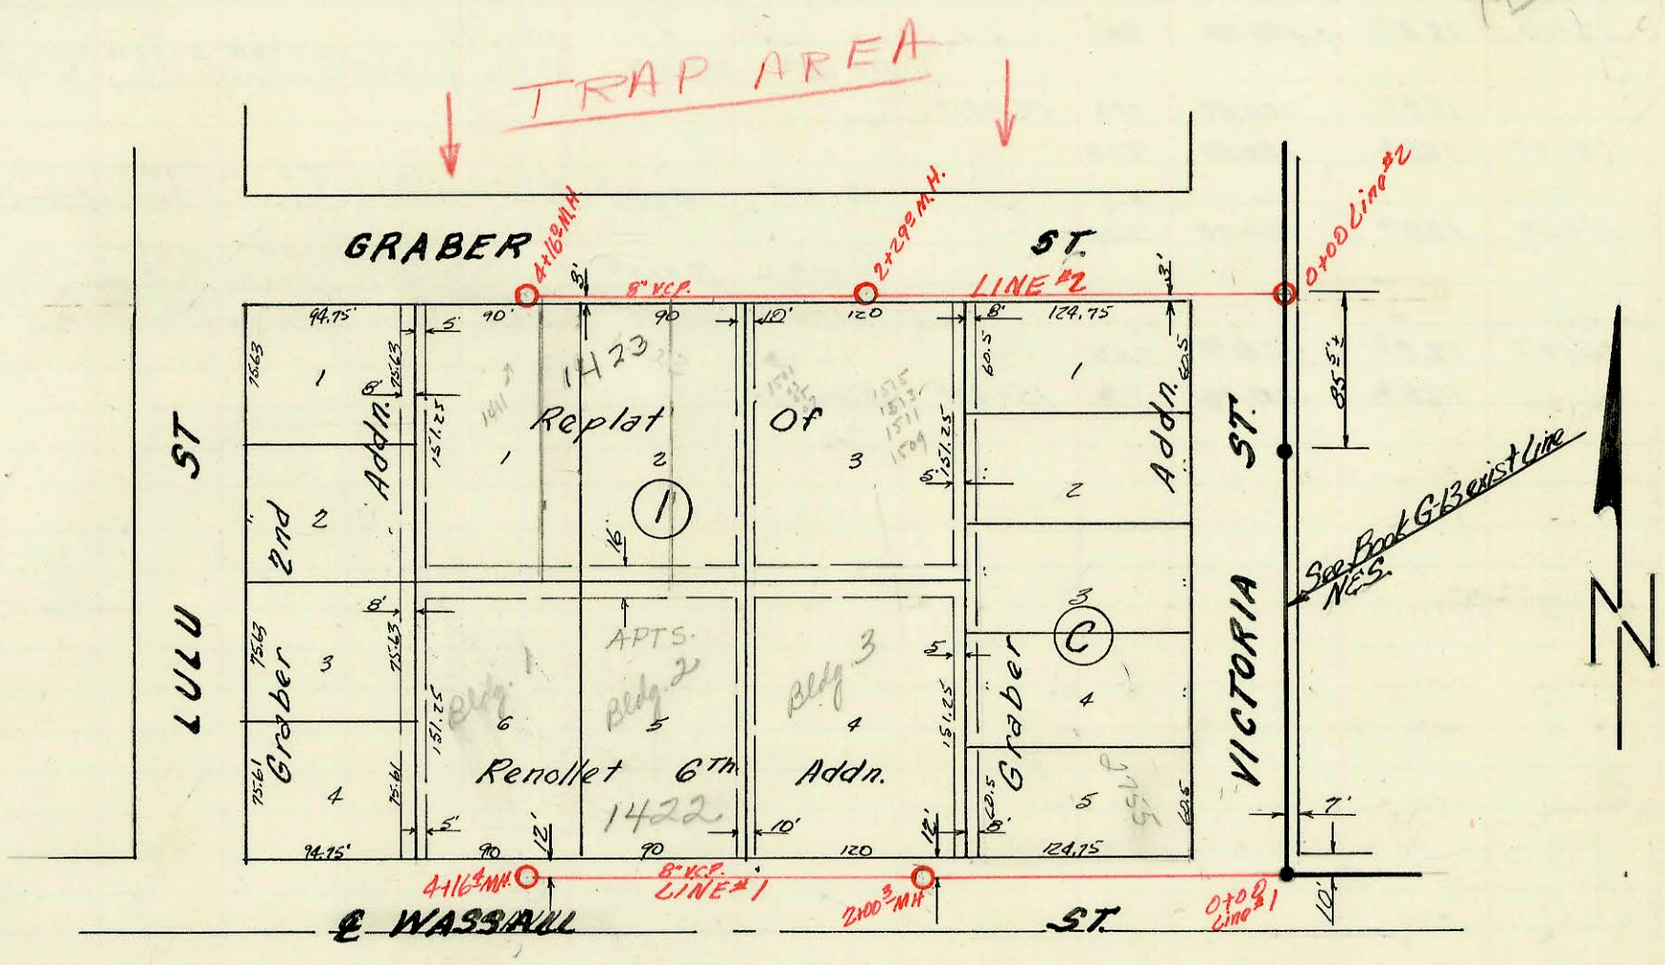

NOTE: All WYES 6"

LAT. 5, DIST. Z, S.S. #20
Mid States Constr. Co, Inc. March 31, 1964
Proj. C 23-112 K-75 Booked 4-28-64

96

Form 41-(54) 7-60

CONSTRUCTION RECORD							SERVICE RECORD					
STATION	ELEVATION		Depth	MANHOLE	4-INCH "Y" BRANCHES		No. of Permit		House Number		DATE OF PERMITS	
	Ground	Grade			North West	South East	North West	South East	North West	South East	North West	South East
ST JUDE SAN. SEWER												
0+00	129.0	121.43	7.6	0+00 Exist								
	129.2	121.53	7.7	0+54 5	4" Stub S.		#17306		3030 Amidon		6-21-63	
						14" off main 1+21.5 S/O	#93-171597		3030 Amidon		6-29-93	
1+00	129.7	121.93	8.3				#22723		3100 Amidon	R (Parish)	3-15-89	
						1+21.3	17333				6-27-63	
	128.4	122.33	8.08	1+99 0	8" Stub N 4" Stub NE		#17332		3100 Amidon (CONVENT)		6-27-63	
Ext. St. Jude SS Private Const. May 64												
0+00		117.05		0+00	Exist MH							
		117.60		0+55 0	4" Stub E.		#10470 1729		3130 N. Amidon		3-15-84	8-4-64
							C3655		3120 3110 N. Amidon	(Church)		4-12-67
LAT. 5, DIST. 2, S.S. #20												
LINE #1				NOTE: All WYE'S = 6"								
0+00	93.8	Out 88.50 In 88.60	5.3	0+00 Exist M.H. 0+77 3			94-05763 C75096		2755 Victoria	A	9-24-94 10-30-79	
1+00	95.3	89.00	6.3									
					1+79 0							
2+00												
	94.6	89.40	5.2	2+00 3								
					2+36 0		C31132		1422 Wassall	Bldg. 3	3-22-72	
					2+88 0							
3+00	94.7	89.80	4.9	top	3+74 4		C31134		1422 Wassall	Bldg 2	3-22-72	
					3+19 5							
4+00	94.7	90.20	4.5									
					4+07 0		C31133		1422 Wassall	Bldg #1	3-22-72	
	94.8	90.26	4.5	4+16 4								
LINE #2				NOTE: All WYE'S = 6"								
0+00	94.0	89.10	4.9	0+00 New M.H. over exist. Line								
1+00	94.6	89.50	5.1									
						1+76 5	B1185		1509-11-13-15 Graber		5-4-64	
2+00	95.0	89.90	5.1									
	94.8	90.02	4.8	2+29 0								
						2+89 0	B1184		1501-03-05-07 Graber		5-4-64	
3+00	95.0	90.30	4.7									
						3+15 5	B4602		1423 Graber		11-22-65	
4+00												
						4+07 5	B3655		1411 Graber		6-24-65	
	95.0	90.76	4.2	4+16 0								

See L-89 additional Cons for School Bd 200.00 $8.64 assessment