107 A

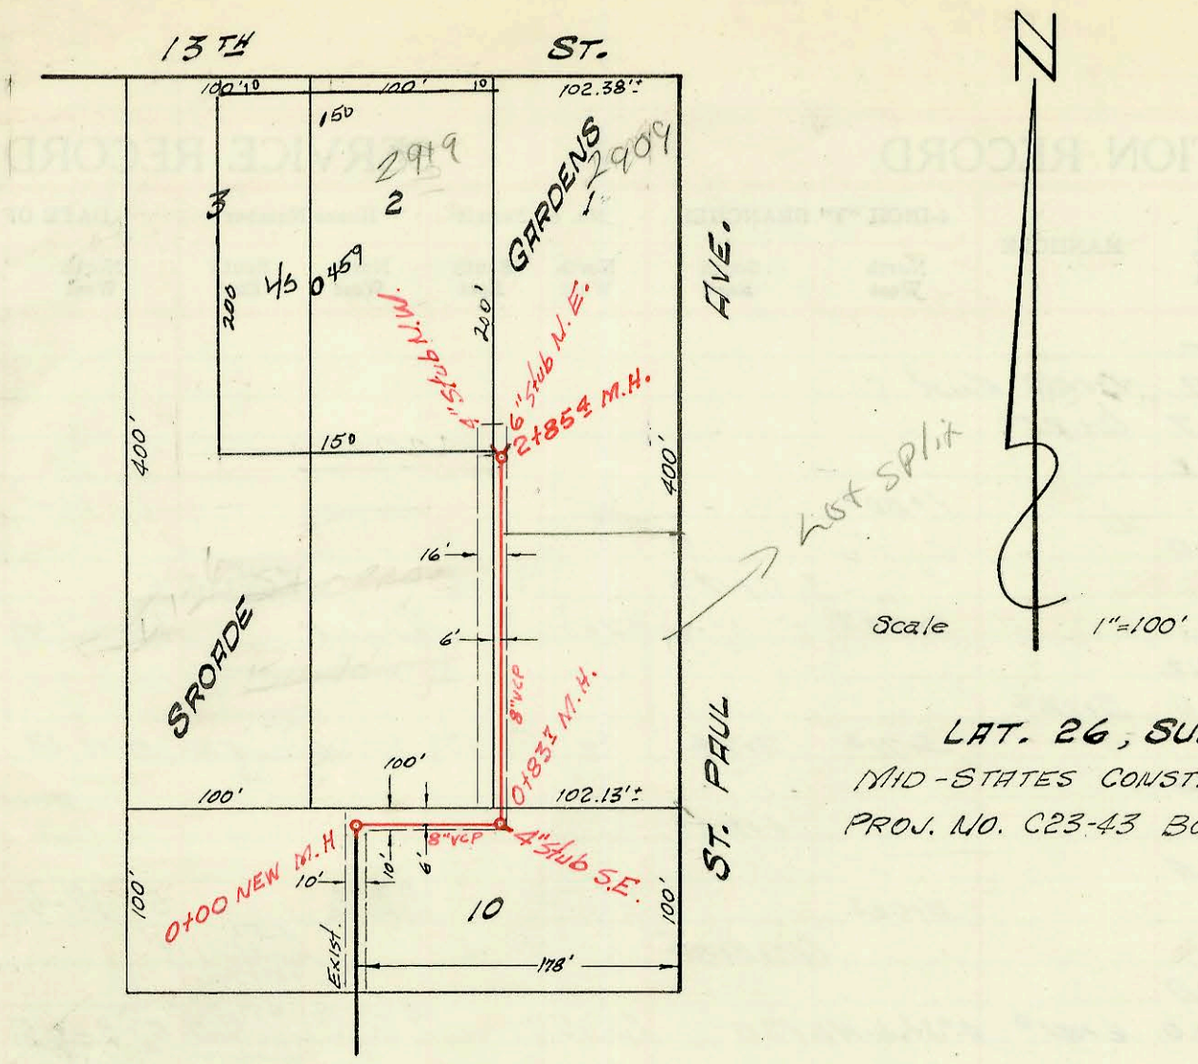

LAT. 26, SUB. 9, S. S. #22

MID-STATES CONSTRUCTION CO., INC. JULY 5, 1963

PROJ. NO. C23-43 BOOKED AUG 1, 1963

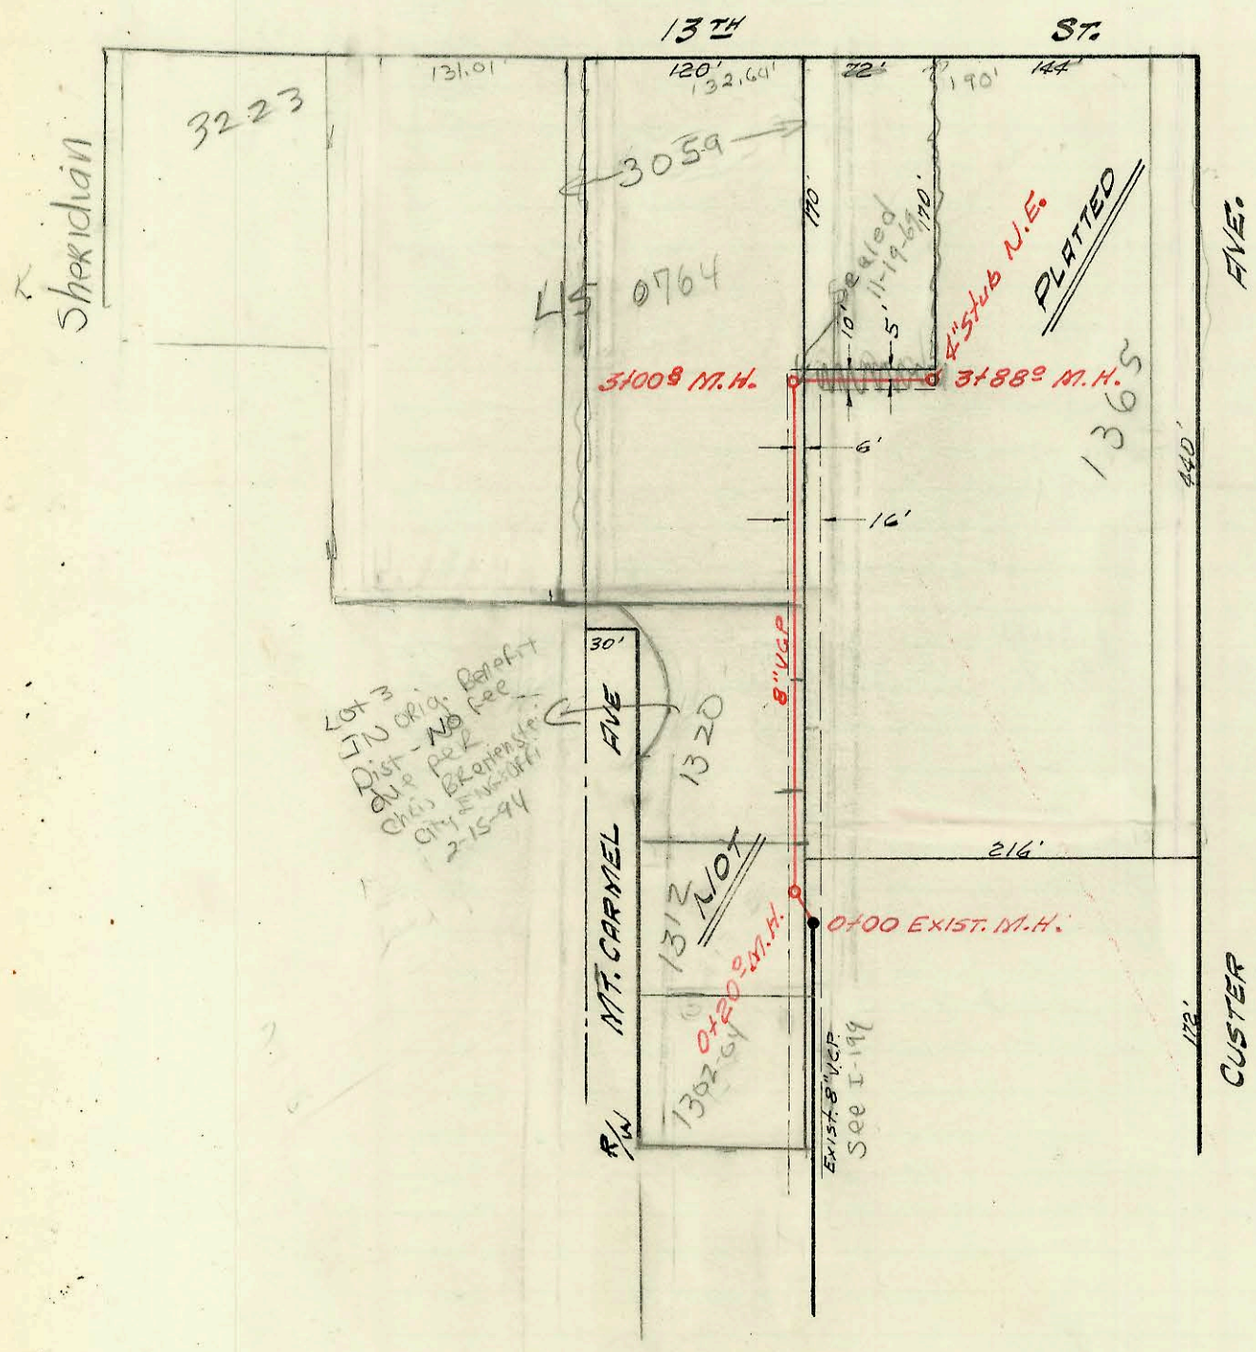

LAT. 25, SUB. 9, S. S. #22

MID-STATES CONSTRUCTION CO., INC. 7-16-63

PROJ. NO. C23-13 BOOKED 8-2-63

K-107

Form 41-(54) 7-60

CONSTRUCTION RECORD							SERVICE RECORD					
STATION	ELEVATION		Depth	MANHOLE	4-INCH "Y" BRANCHES		No. of Permit		House Number		DATE OF PERMITS	
	Ground	Grade			North West	South East	North West	South East	North West	South East	North West	South East
LAT. 26, SUB, 9, S.S. #22												
0+00	129.5	117.82	11.7	NEW 0+00 ℄								
	127.8	out 118.00 in 118.09	9.8 9.7	0+83 ⊤		4" Stub S.E.						
1+00	128.0	118.12	9.9									
						1+47 ℄						
					1+84 ⊥							
2+00	129.0	118.32	10.7				96-24127					
	130.8	118.50	12.3	2+85 ⊥	4" PVC 40 6" Stub N.E.	4" Stub N.W.	17475	726	2909 W 13th	2719 W 13th N	2-26-96 8-5-63	7-10-80
LAT. 25, SUB. 9, S.S. #22												
0+00	124.15	118.45	5.7	Exist 0+00 ℄								
	123.6	out 118.49 in 118.59	5.1 5.0	0+20 ℄			16313		1312 Mt CARMEL		5-21-86	
					0+75 ⊥	0+73 ⊥	16312		1314 Mt CARMEL		5-21-86	
1+00	123.0	118.75	4.3		4" ABS 40 0+91.9		94-4581		1320 N Mt CARMEL		3-31-94	
					1+34 ⊥	1+32 ⊥						
					1+94 ⊥	1+92 ⊥						
2+00	123.60	118.95	4.7		sealed in yard w of MH		23009		5/0		4-25-69	
					2+54 ℄	2+52 ℄	17425	C16669	3059 W 13th	1365 N Custer	July 22, 63	11-10-69
3+00	126.3	119.15	7.2		3+10.5 TAP		23887		3059 N/C W 13th		9-13-89	
					3+00 ⊥							
	126.6	out 119.18 in 119.27	7.4 7.3	3+17 ⊥			M.H. Stop A.E. #C17107			1365 N. Custer		11-26-69
					3+71 ℄							
	125.4	119.43	6.0	3+88 ℄	4" Stub NE.		B1620		3001 W 13th		7-7-64	
							C13840		Cap off		4-29-69	