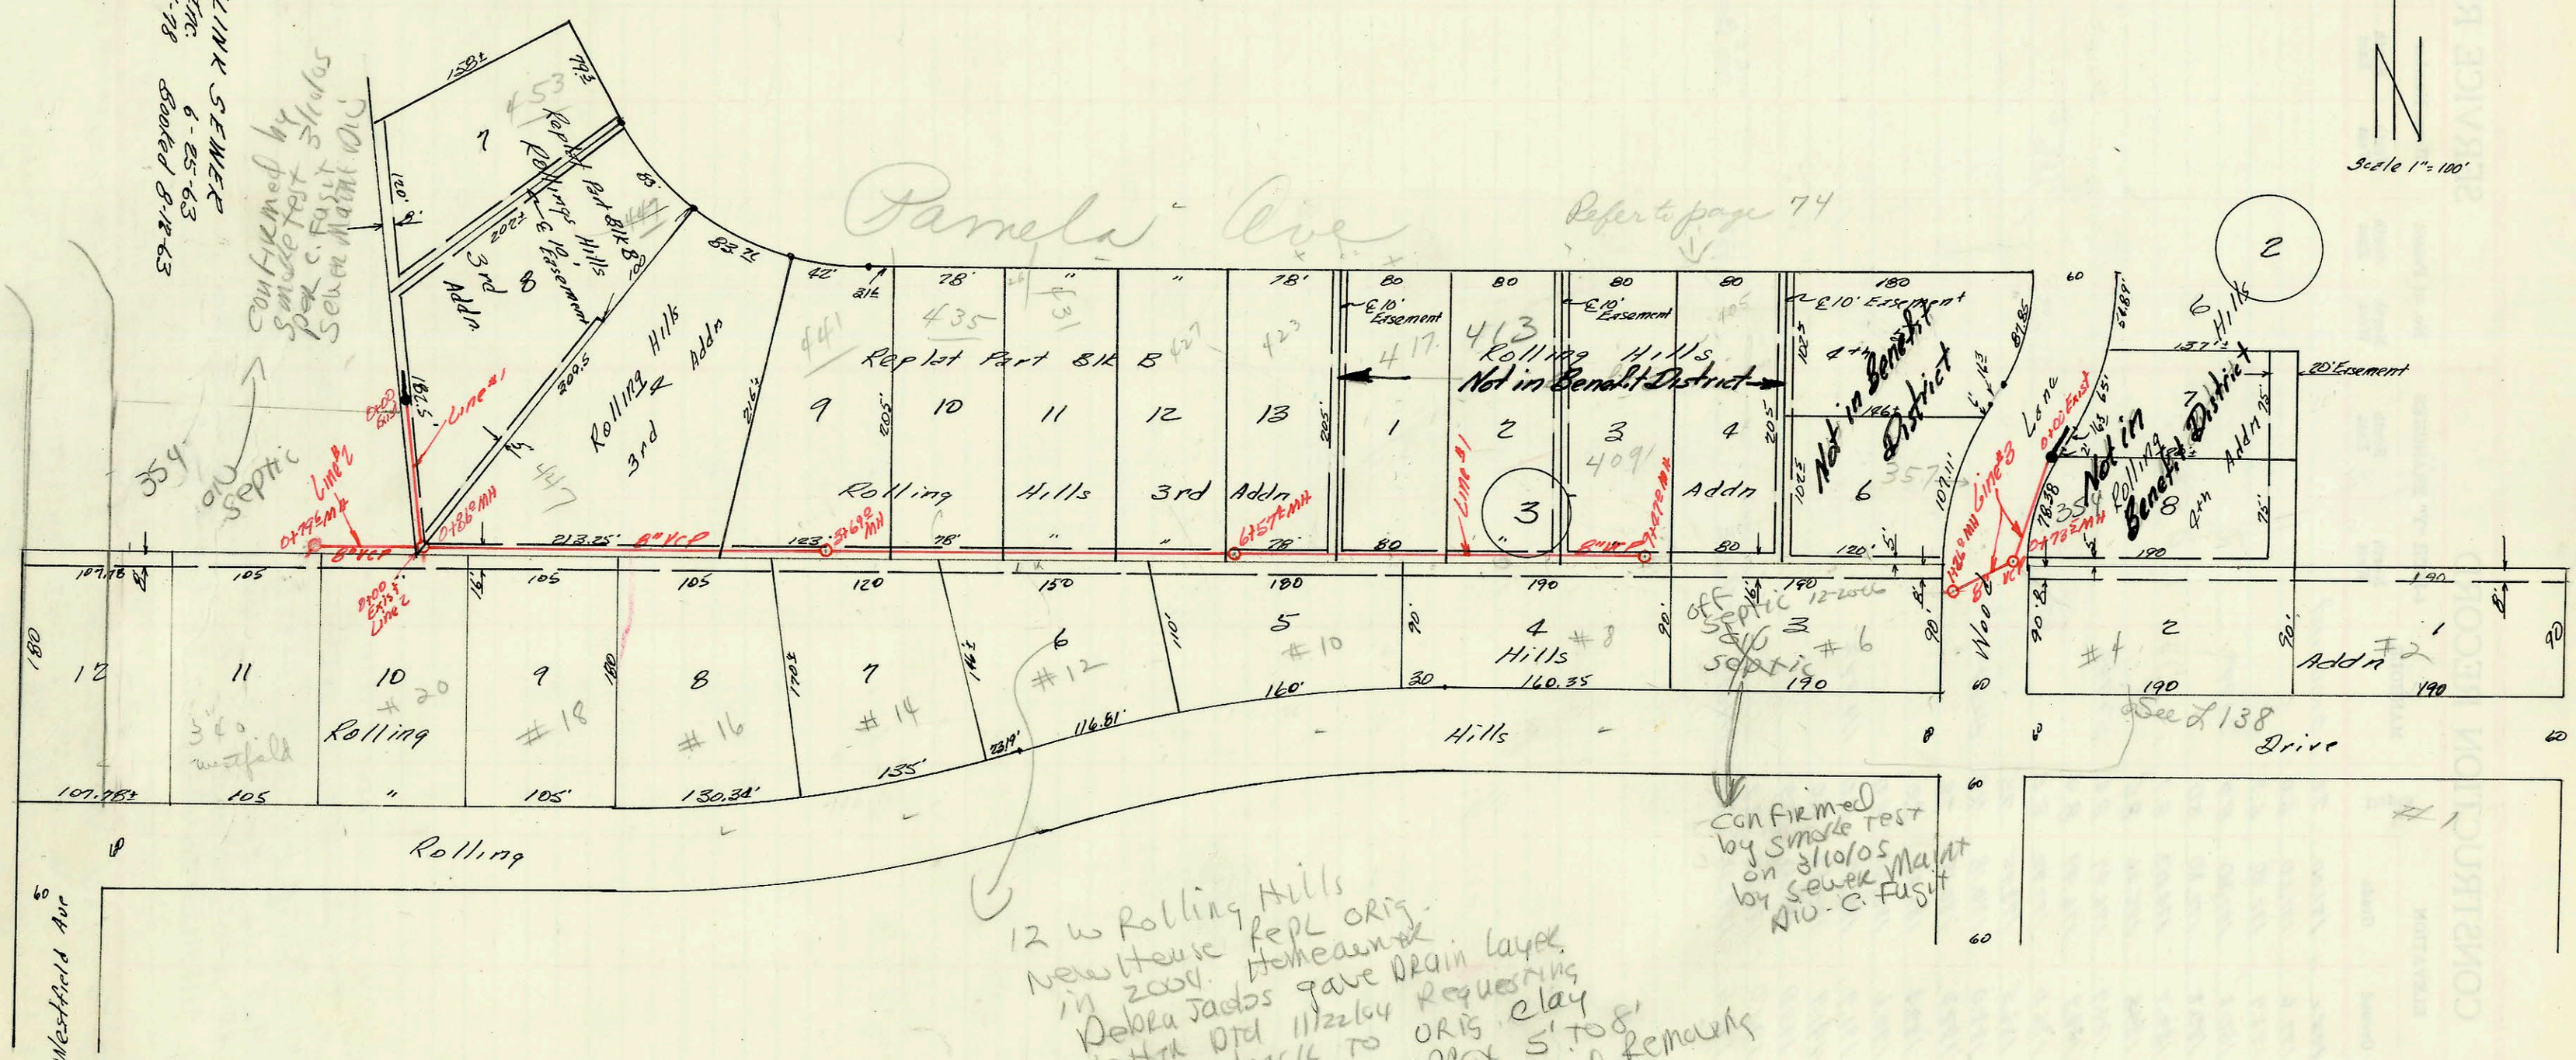
C.H.T. I WESTLINK SEWER
Mid-Sierra Court & Etc
Proj. No. C 23-P
6-25-63
Accepted 8-12-63
Scale 1" = 100'
Pamela Ave
Refer to page 74
Rolling Hills 3rd Addn
Replat Part Blk B
Rolling Hills 3rd Addn
Not in Benefit District
Not in Benefit District
Not in Benefit District
Rolling Hills Addn
Hills Drive
Rolling
Westfield Ave
Confirmed by smoke test on 8/10/05 by Sewer Maint. Dist. C. Fusit
12 w Rolling Hills New House Repl ORIG. in 2004. Homeowner Debra Jacobs gave Drain layer letter dtd 11/22/04 requesting to tie back to ORIG. clay Bldg. line at appox 5' to 8' from main to avoid removing cedar tree and fence
BF 11/24/04
K 1094

109

Form 41-(54) 7-60

CONSTRUCTION RECORD							SERVICE RECORD					
STATION	ELEVATION		Depth	MANHOLE	4-INCH "Y" BRANCHES		No. of Permit		House Number		DATE OF PERMITS	
	Ground	Grade			North ~~West~~	South ~~East~~	North West	South East	North West	South East	North West	South East
CAT 1 Westlink Sewer												
Line #1												
0+00	143.9	136.45	7.1	0+00 Exist.								
	144.5	136.58	7.9	0+86º	4" stub So.							
1+00	144.5	136.70	7.8									
						1+98º		C13530		#18 Rolling Hills		4-10-69
2+00	143.6	136.85	6.7		2+00º		C30773		447 Pamela		3-2-72	
3+00	142.4	137.00	5.4									
						3+28º		#B28		#16 Rolling Hills		8-14-63
					3+55º							
	142.º	137.11	4.9	3+69º								
4+00	142.2	137.15	5.0									
					4+32º		B1514		435 Pamela		6-15-64	
						4+44º		#B27		#14 Rolling Hills		8-14-63
5+00	142.0	137.30	4.7									
					5+06º	5+08º	B1681	2004-02613 #C19239	431 Pamela	#12 Rolling Hills	7-21-64	3-12-04 5-12-70
					5+90º		B2901		427 Pamela		3-1-65	
6+00	142.0	137.45	4.5									
	141.5	137.55	3.9	6+57º								
					6+68º							
7+00	141.4	137.60	3.8									
						7+15º		B-26		#10 Rolling Hills		8-14-63
					7+43º							
8+00	141.4	137.75	3.6									
					8+21º							
9+00	142.3	137.9	4.4									
					9+03º			2002-02492		R Rudy Mellron		9-11-02
						9+36º		B-25		#8 Rolling Hills		8-14-63
	142.6	137.98	4.6	9+47º								
Line #2												
0+00	144.5	136.68	7.8	0+00 exist = 0+86º Line #1				623		#20 Rolling Hills		6-25-80
	144.7	137.00	7.7	0+79º	4" stub SW		1529		340 Westfield		10-16-80	
Line #3												
0+00	142.9	136.91	6.0	0+00 exist.								
	142.0	137.05	4.9	0+73º								
1+00	~~142.3~~	~~137.27~~	~~5.0~~									
	142.2	137.27	5.0	1+26º	4" stub W.		2006-3263		#6 Rolling Hills		12-20-06	

SUR, 2004-02933 11/03/04 #12 Rolling Hills (Newhouse) Wilks - 4" sch 40 from House TO GRIS 4" clay line at approx 5' to 8' from city main (see attd Letter)

#B2794 - 423 Pamela - Von White - 3-4-65 - tape (7+20.7)
" B3526 - 417 Pamela - Von White - 7-1-65 - tape (7+81.0)