138A

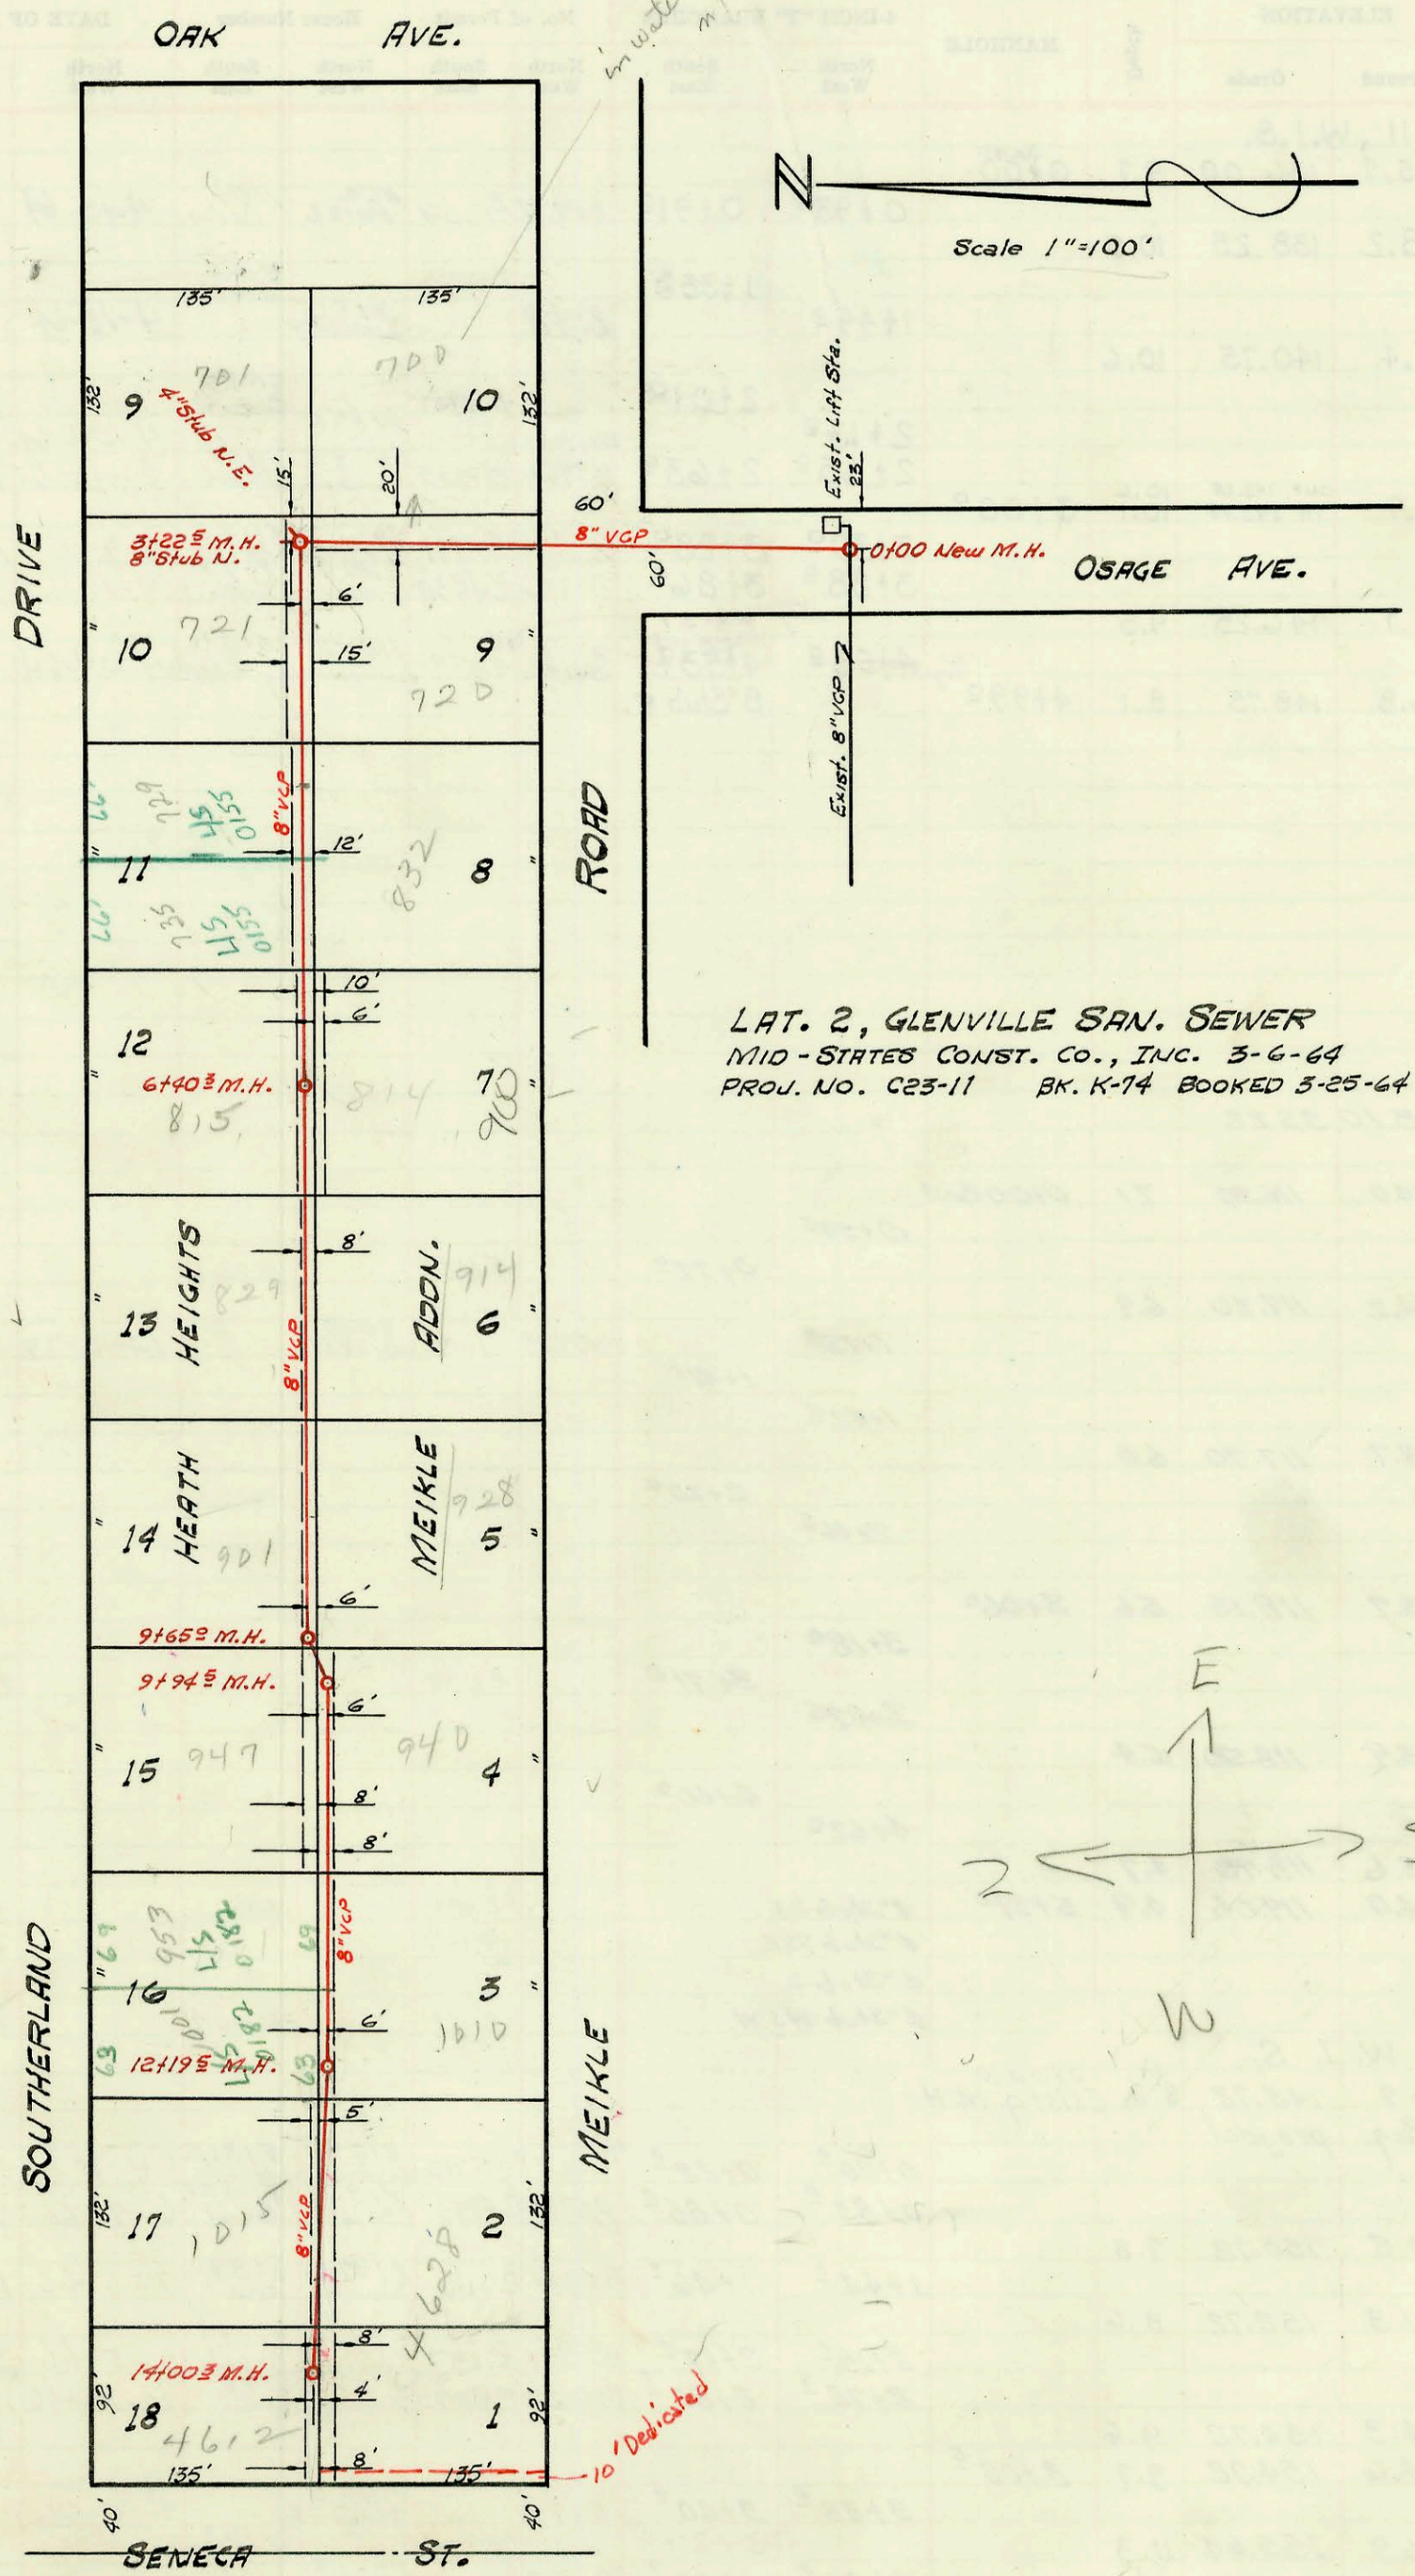

LAT. 2, GLENVILLE SAN. SEWER
MID-STATES CONST. CO., INC. 3-6-64
PROJ. NO. C23-11 BK. K-14 BOOKED 3-25-64

138

Form 41-(54) 7-60

CONSTRUCTION RECORD							SERVICE RECORD					
STATION	ELEVATION		Depth	MANHOLE	4-INCH "Y" BRANCHES		No. of Permit		House Number		DATE OF PERMITS	
	Ground	Grade			North West	South East	North West	South East	North West	South East	North West	South East
Lat. 2, Glenville Sewer												
0+00	87.8	79.23	8.6	New 0+00								
1+00	88.0	79.43	8.6									
2+00	89.0	79.63	9.4									
						2+62						
3+00	89.1	79.83	9.3				Stub N.E. B1400		721 Sutherland		6-15-64	
	89.3	out 79.87 in 79.97	9.4 9.3	3+22	4" Stub N.E.	8" Stub N.						
					3+41	M.H. Lap	B1106	C44535 #B5724	721 Sutherland	700 Meible 720 Meible	4-17-64	4-18-74 5-27-66
						3+58						
					3+69							
4+00	89.0	80.33	8.7									
					4+66		#B1453		729 Sutherland		4-8-64	
5+00	88.9	80.53	8.4									
						5+13		#B1454		832 Meible		4-8-64
					5+25		C39073		735 Sutherland		5-17-73	
					5+92							
6+00	87.3	80.73	6.6									
						6+19		B2206		814 Meible		10-27-64
	87.2	80.81	6.4	6+40								
					6+47		23698 B1993		815-R Sutherland		8-7-89 9-21-64	
7+00	87.1	80.93	6.2									
					7+62		B1177		829 Sutherland		4-30-64	
						7+69		B1587		914 Meible		6-30-64
8+00	87.4	81.13	6.3									
						8+96		#B1173		928 Meible		4-29-64
9+00	87.6	81.33	6.3									
					9+08		#C7936		901 Sutherland		4-19-68	
	87.5	81.46	6.0	9+65								
						9+77						
	87.5	81.52	6.0	9+94								
10+00	87.6	81.53	6.1									
					10+02		#B3072	2004-03839 B1166	947 Sutherland	940 Meible	4-9-65	4-28-64
						10+44						
11+00	87.6	81.73	5.9									
					11+16		C-51650		753 Sutherland		10-1-75	
					11+83	11+85	C-23781	B1631	1001 Sutherland	1010 Meible	4-16-71	7-9-64
12+00	87.4	81.93	5.5									
	86.9	81.97	4.9	12+19								
					12+73	~~12+71~~ (reconnect) 12+83.1		C3894-7 C53308		46285, Seneca 46.28 Seneca Sonic Burger		5-11-73 1-21-76
13+00	86.8	82.13	4.7									
					13+35		26198 B1432		1015-R Sutherland		4-6-89	
						13+43						
					13+92	13+90	B1431		46128 Seneca		4-6-64	
14+00	87.3	82.33	5.0									
	87.3	82.33	5.0	14+00								

#19606 · 4628 S. Seneca (house added not hydrant) (house in rear S/O only) - Henning - (sealed at house)
~~Not~~ Sonic Burger Resto.