


LAT. 20, SUB. 17, S.S. 22  
UTILITY CONTRACTORS, INC.  
PROJ. No. C23-47 K-81 BOOKED 4-16-64

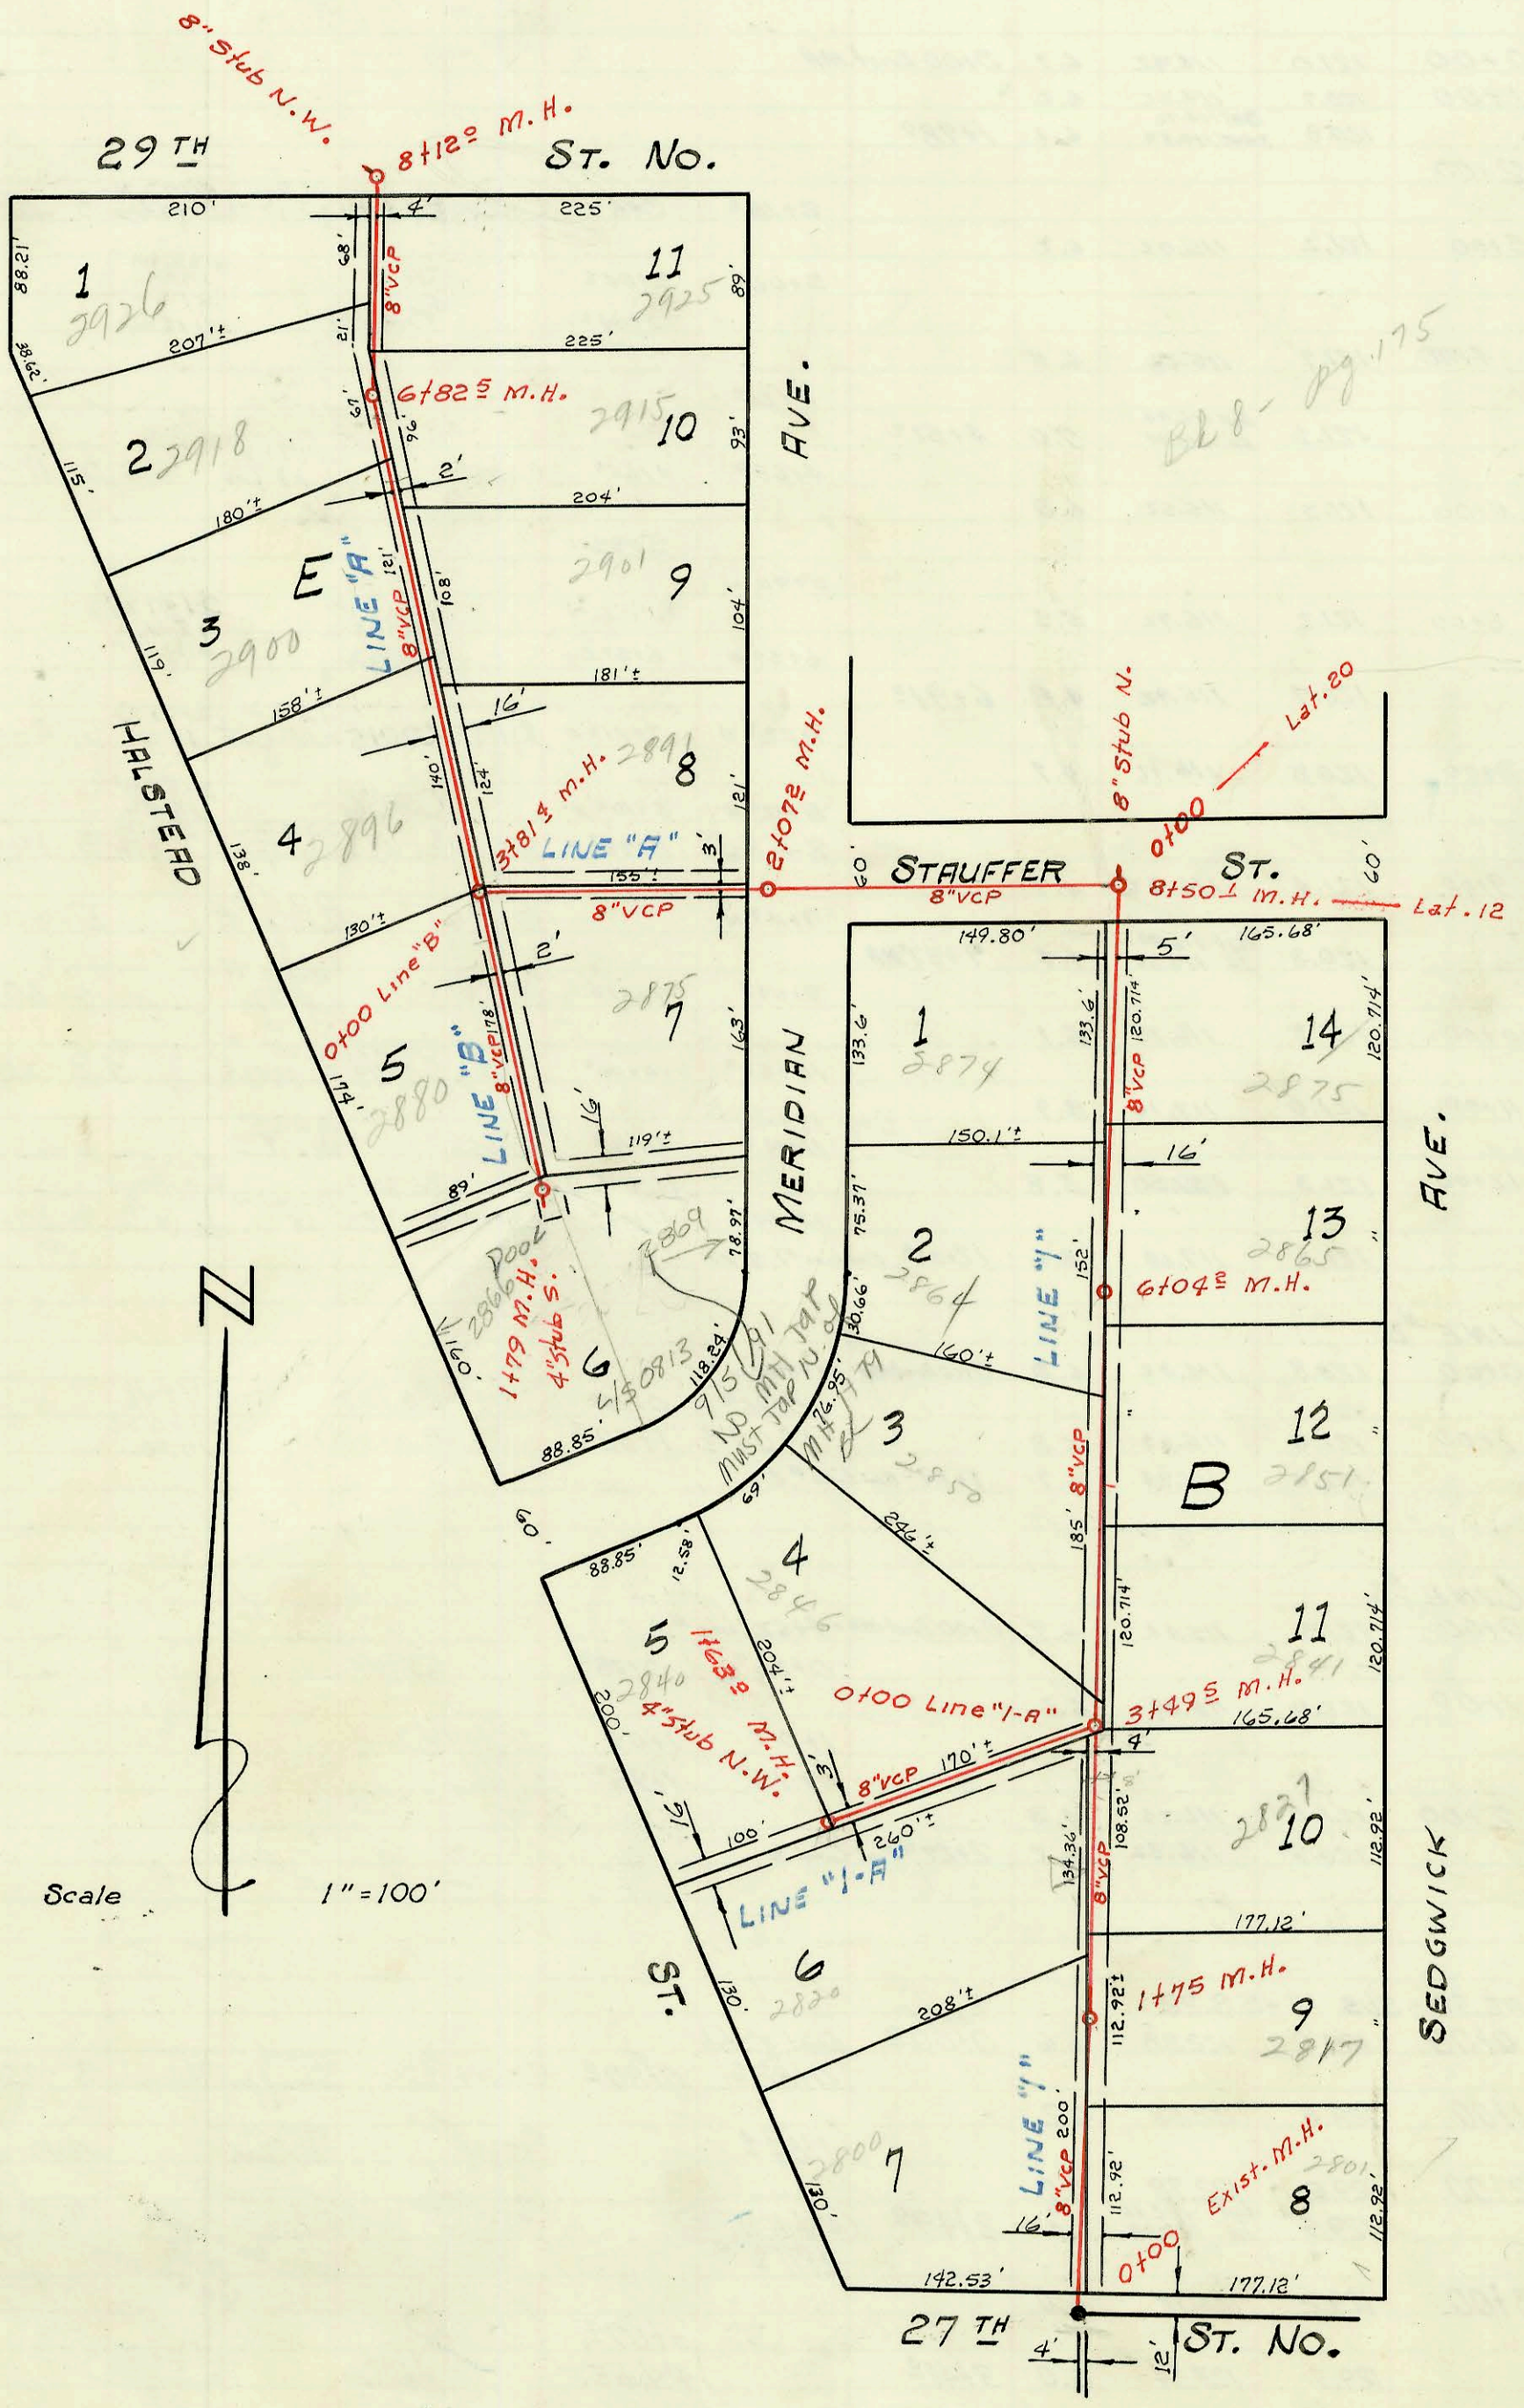

LAT. 12, SUB. 17, S.S. 22  
MID-STATES CONSTRUCTION Co.  
PROJ. No. C23-19 K-84 BOOKED 4-16-64

