K-145A

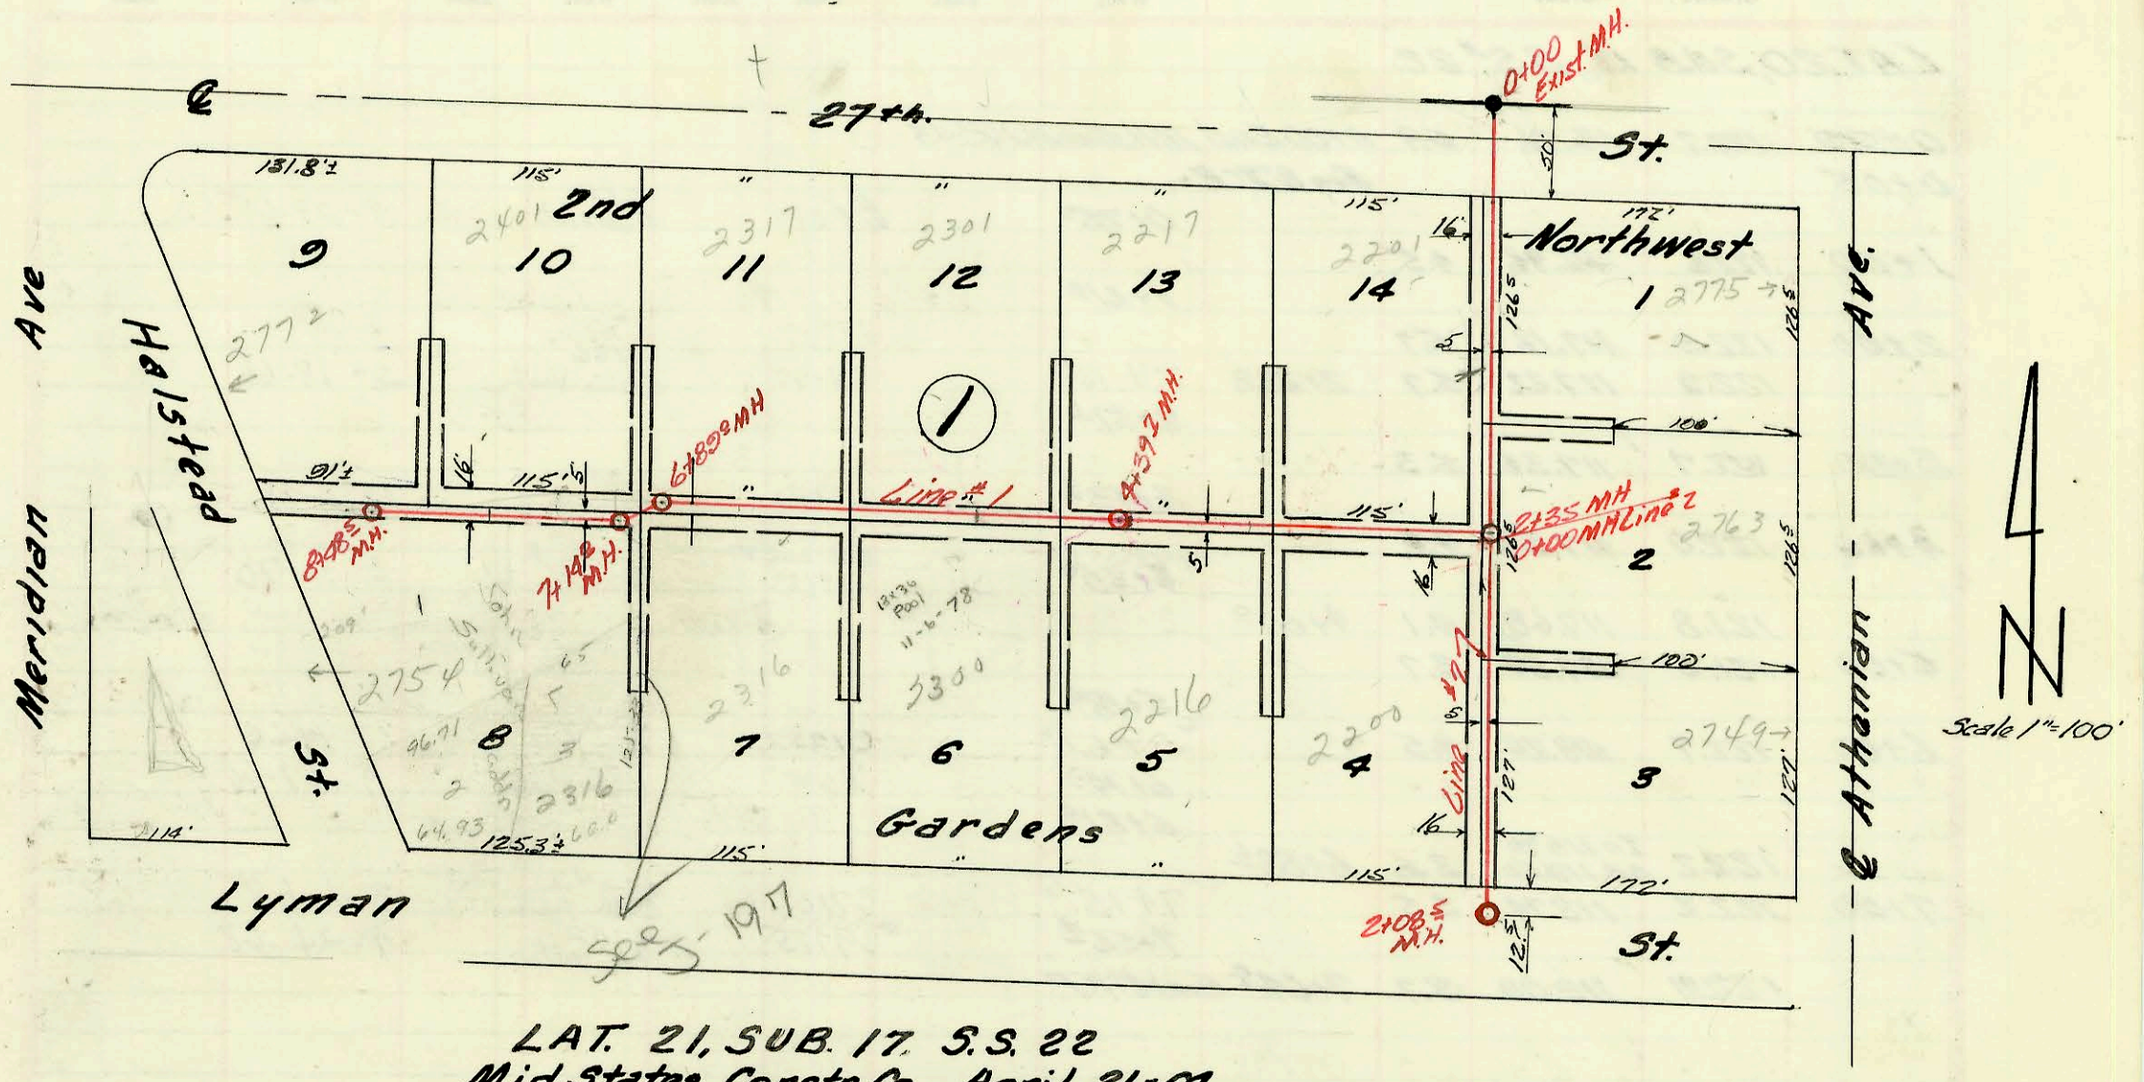

LAT. 21, SUB. 17. S.S. 22
Mid States Constr Co. April 21-64
Proj. C 23-48, K-79 Booked 6-2-64

K-145

Form 42-020

CONSTRUCTION RECORD							SERVICE RECORD					
STATION	ELEVATION		Depth	MANHOLE	4-INCH "Y" BRANCHES		No. of Permit		House Number		DATE OF PERMITS	
	Ground	Grade			North West	South East	North West	South East	North West	South East	North West	South East
LAT. 21, SUB. 17, S.S. 22												
LINE #1												
				0+00 Exist. MH.								
0+05	127.6	119.22	8.4	Begin								
1+00	127.0	119.42	7.6									
						1+05° E		B1518		2775 N. Atherton		6-15-64
					1+32° W		C3777		2201 W 27th No		6-29-67	
2+00	127.2	119.62	7.6									
						2+23°		B1519		2763 N. Atherton		6-15-64
	127.3	In 119.77 Out 119.69	7.6	2+35°								
						2+63 S						
3+00	127.3	120.05	7.2									
					3+06°							
					3+98°	3+96°		B1760		2716 Lyman		8-12-64
4+00	127.4	120.45	6.9									
	127.1	120.61	6.5	4+39 I								
					4+96°		B1553		2301 W. 27th		6-22-64	
5+00	127.3	120.85	6.4									
						5+17 S		B1343		2300 Lyman		6-2-64
6+00	127.3	121.25	6.0									
						6+14°		B1377		2376 W Lyman		6-8-64
					6+41°		C19361		2317 W 22nd St N		5-18-70	
	127.5	In 121.71 Out 121.61	5.9	6+89°								
7+00												
	127.8	In 121.91 Out 121.81	6.0	7+14°								
						7+21°						
					7+43°		C902		2401 W 27th		11-21-66	
						7+85 S		B4683		2754 Halstead		9-7-65
8+00	128.2	122.25	5.9									
					8+36°		B1503		2777 Halstead		6-12-64	
	128.4	122.44	6.0	8+48 S								
LINE #2												
0+00	127.3	119.69	7.6	0+00 Exist MH = 2+35 Line #1								
					0+94° W		B4511		2200 Lyman		11-10-65	
1+00	127.2	119.89	7.3									
						1+11° E		B4510		2749 N. Atherton		11-10-65
2+00	127.1	120.09	7.0									
	126.8	120.11	6.7	2+08 S								