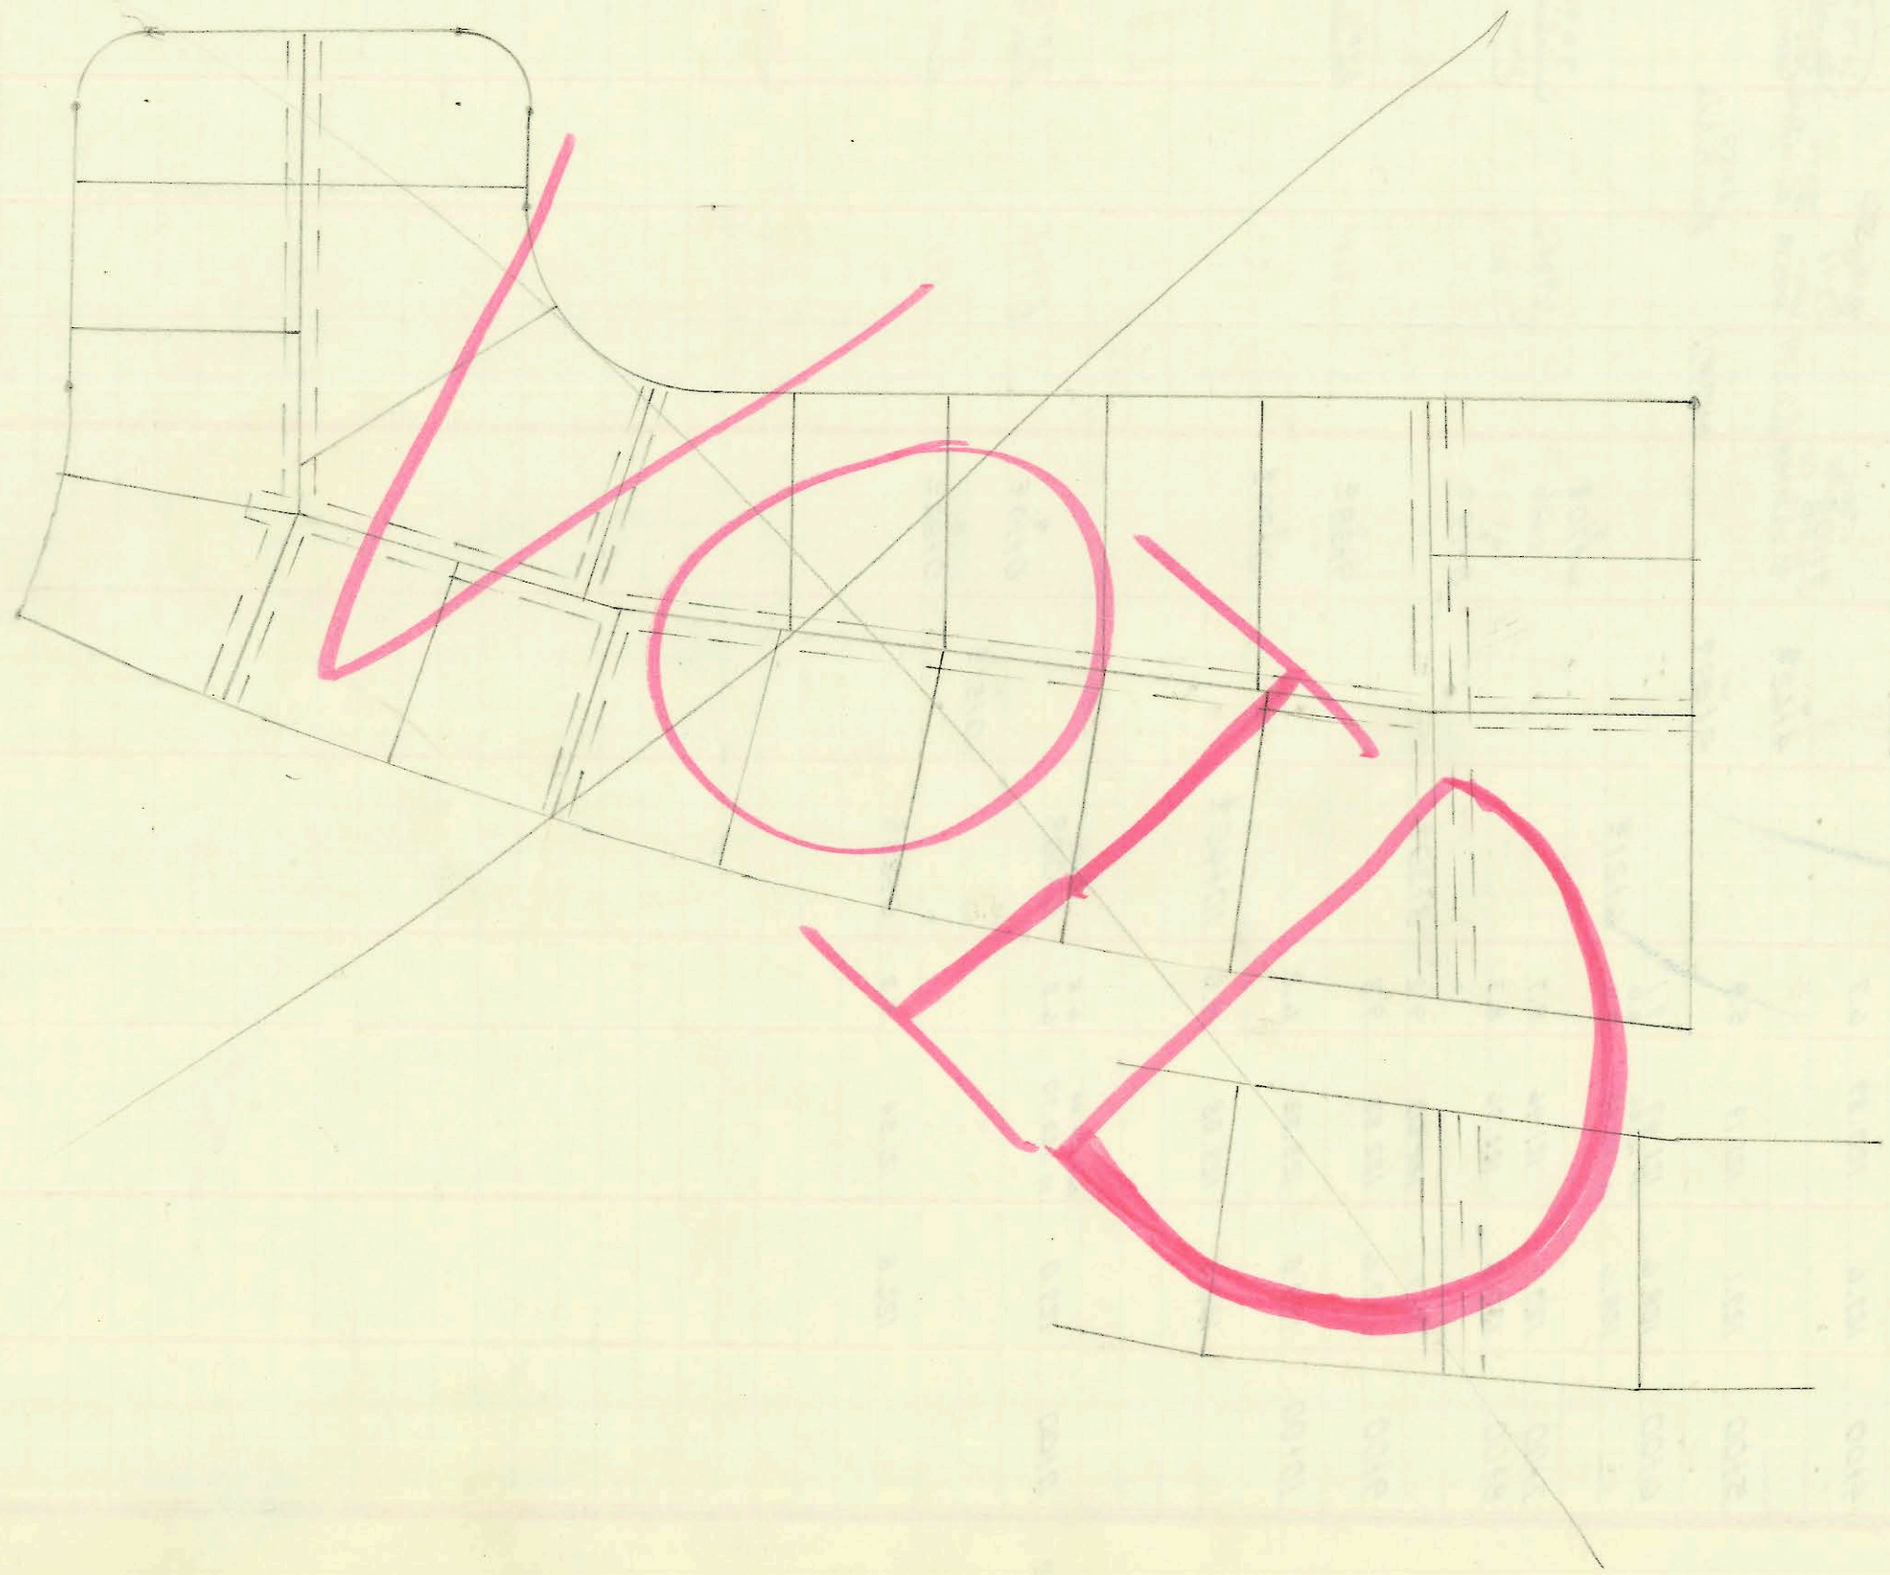

VOID

137A

157

Form 42-020

| | CONSTRUCTION RECORD | | | | | | | SERVICE RECORD | | | | | |
|---|---|---|---|---|---|---|---|---|---|---|---|---|---|
| | STATION | ELEVATION | | Depth | MANHOLE | 4-INCH "Y" BRANCHES | | No. of Permit | | House Number | | DATE OF PERMITS | |
| | | Ground | Grade | | | North West | South East | North West | South East | North West | South East | North West | South East |
| | Lot 1, Sub. 19, S.S.22 | | | | | | | | | | | | |
| Line #2 | 0+00 | 126.7 | 120.00 | 6.7 | Exist. 0+00 ℄ | | | | | | | | |
| | | | | | | | E. 0+27 ℄ | | | | | | |
| | | | | | | W. 0+89 ⅝ | | | | | | | |
| | 1+00 | 126.6 | 120.20 | 6.4 | | | | | | | | | |
| | | | | | | | E. 1+47 ℄ | | B1776 | | 3027 River Pk. Dr. | | 8-12-64 |
| | 2+00 | 126.8 | 120.40 | 6.4 | | | | | | | | | |
| | | 126.4 | 120.55 | 5.9 | 2+73 ℄ | | | | | | | | |
| | 3+00 | 127.4 | 120.60 | 6.8 | | | | | | | | | |
| | | | | | | | E. 3+24 ℄ | | B1917 | | 3075 River Pk. Ct. | | 9-4-64 |
| | | | | | | W. 3+44 ℄ | | B2414 | | 3069 River Pk. Ct. | | 11-30-64 | |
| | | | | | | | E. 3+87 ⅝ | | C33225 | | 3081 River Park Dr. | | 6-28-72 |
| | 4+00 ℄ | 127.0 | 120.80 | 6.2 | 4+00 ℄ | | | | | | | | |
| Line #3 | 0+00 | 126.4 | 120.69 | 5.7 | Exist. 0+00 ℄ | | | | | | | | |
| | | | | | | N. 0+49 ℄ | | | | | | | |
| | 1+00 | 126.6 | 121.25 | 5.4 | | | | | | | | | |
| | | | | | | 1+45 ? | | | | | | | |
| | 2+00 | 126.4 | 121.83 | 4.6 | | | | | | | | | |
| | | 126.4 | 121.89 | 4.5 | 2+09 ℄ | 4" stub N.W. | | # C33041 | | 3057 River Park Ct. | | 6-19-72 | |
| | | | | | top | 2+81.2 | | C35360 | | 3063 River Park | | 10-12-72 | |

This meas does not make sense. Probably should be 1+37 bsR

K