


**CAUTION**  
**UNDERGROUND**  
**UTILITIES**

Please check with K G & E or  
 Southwestern Bell  
 Telephone Co. for Location

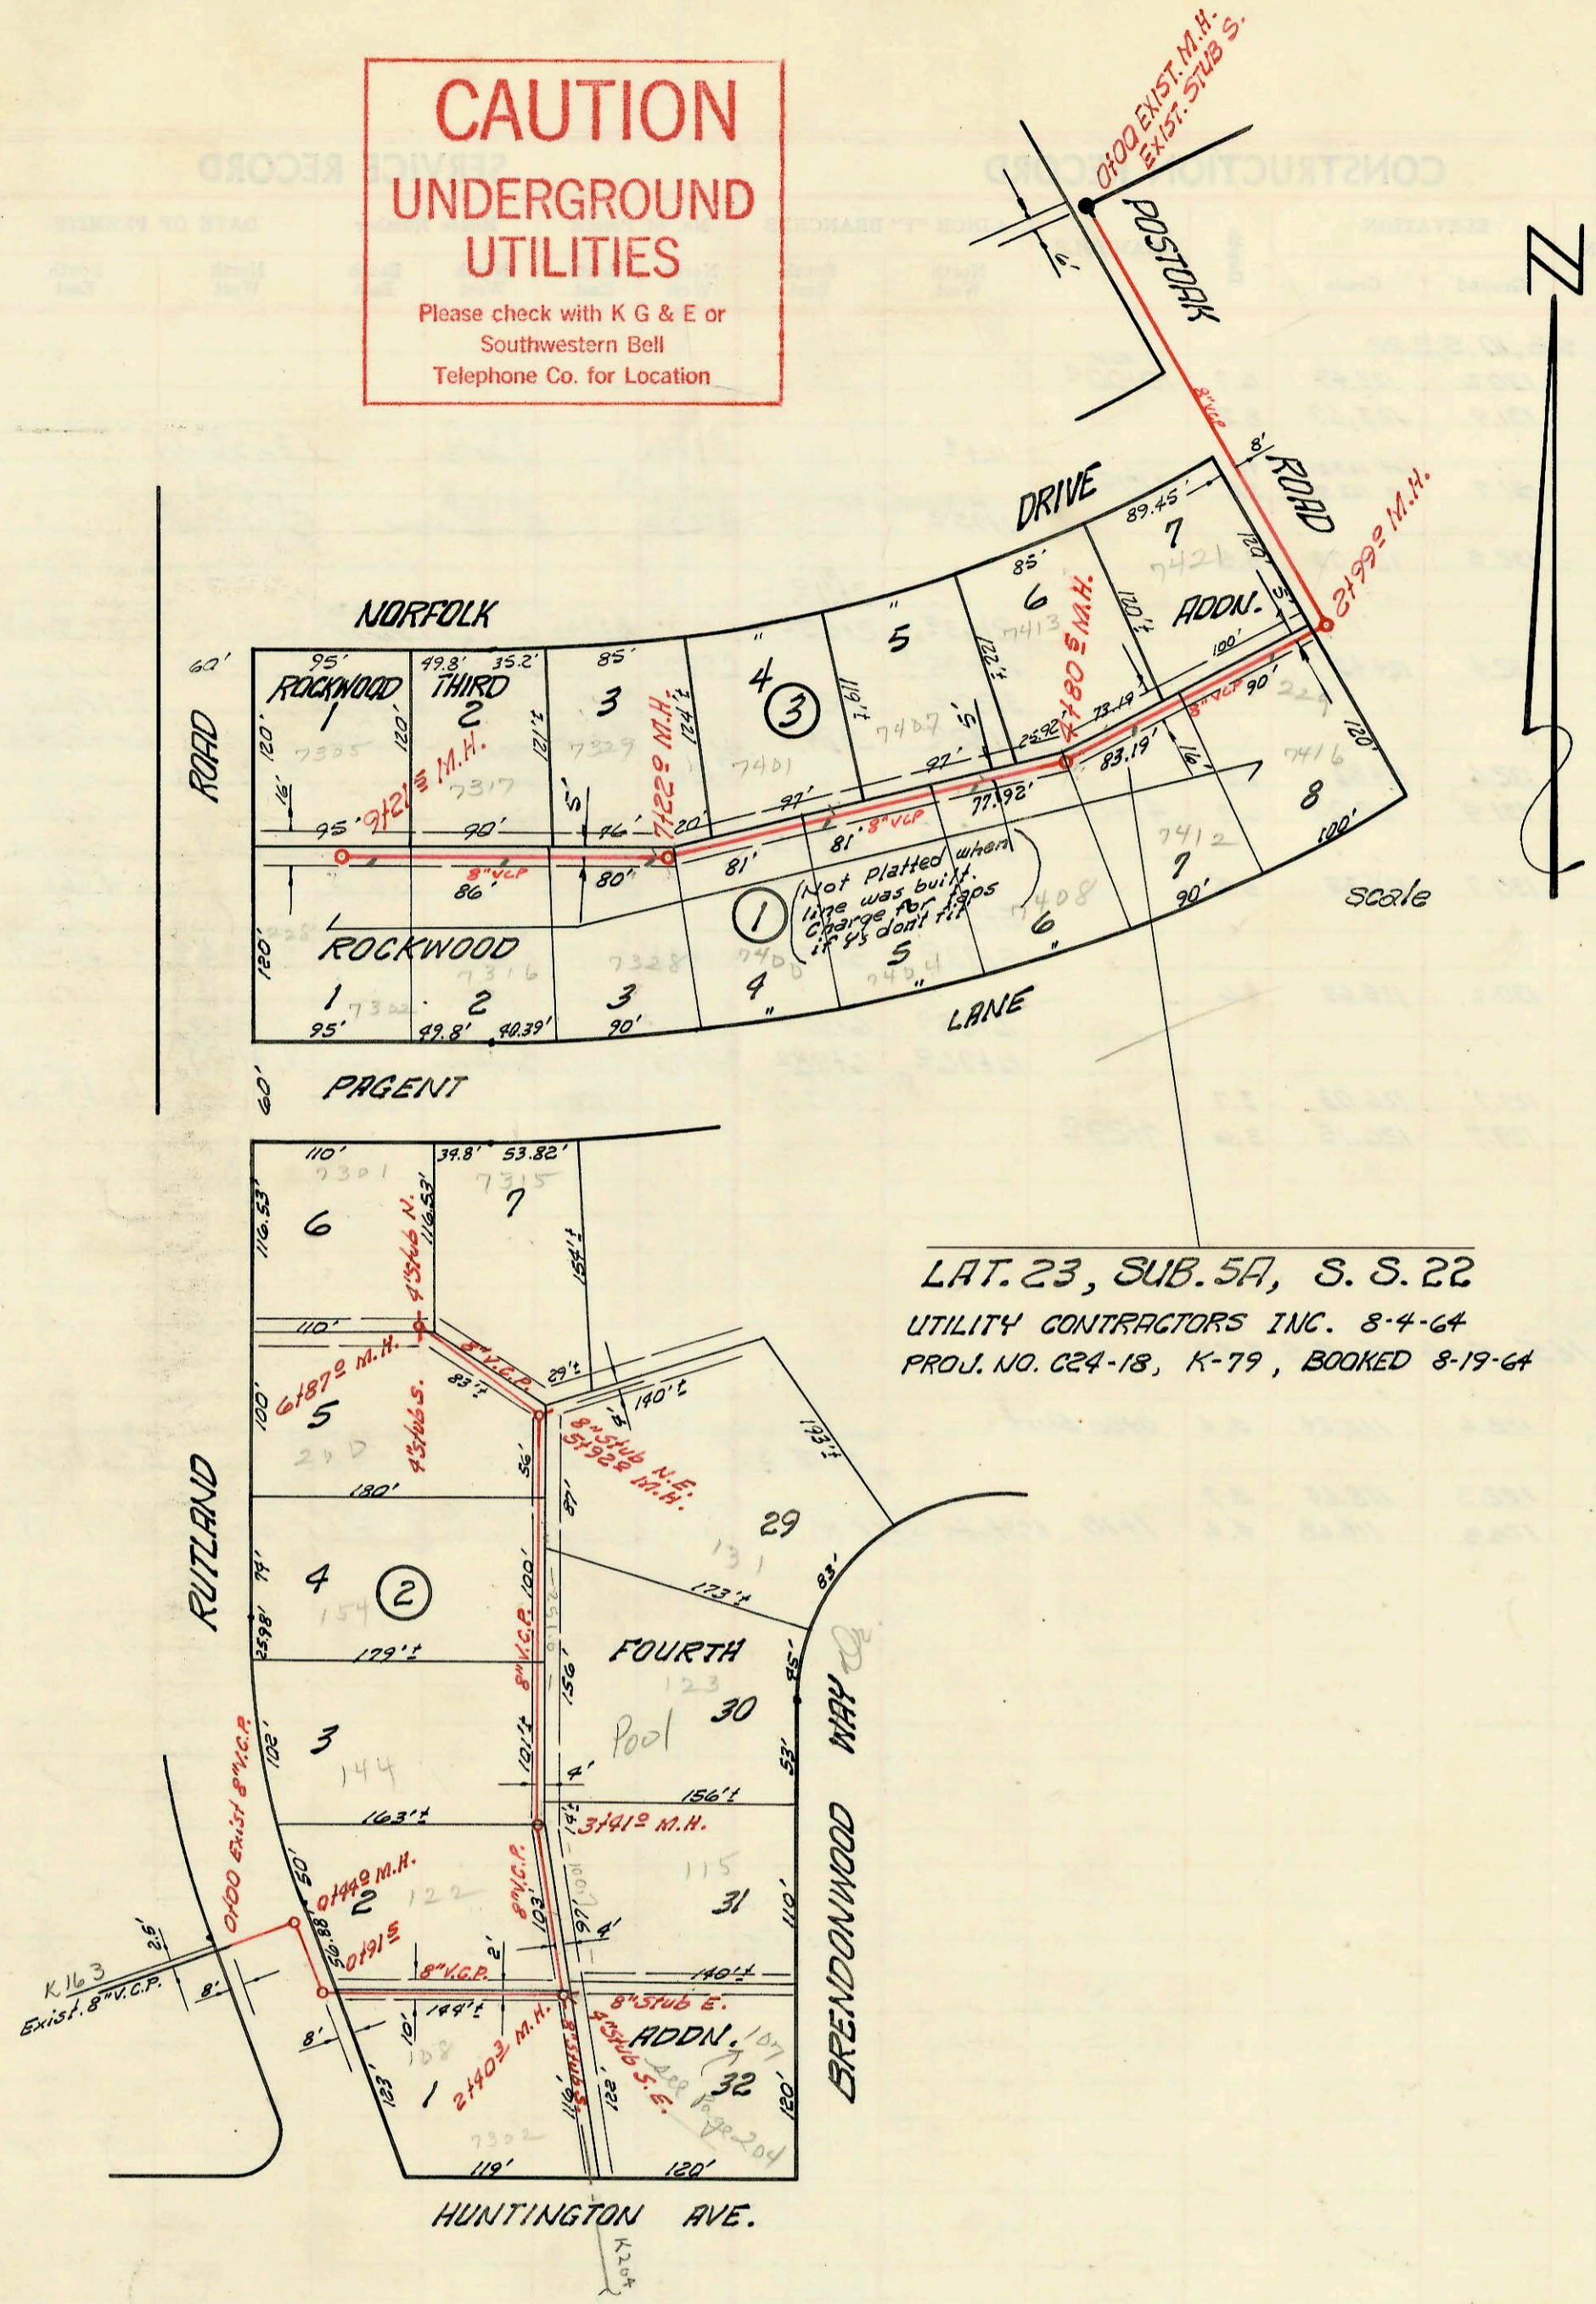

LAT. 23, SUB. 5A, S. S. 22  
 UTILITY CONTRACTORS INC. 8-4-64  
 PROJ. NO. C24-18, K-79, BOOKED 8-19-64

LAT. 26, SUB. 5A, W. I. S.  
 MID-STATES CONST. CO. INC. 1-19-65  
 PROJ. NO. C24-48 K-82 BOOKED 3-1-65

| CONSTRUCTION RECORD      |           |                         |              |                   |                                   | SERVICE RECORD                    |               |            |                |                    |                 |            |
|--------------------------|-----------|-------------------------|--------------|-------------------|-----------------------------------|-----------------------------------|---------------|------------|----------------|--------------------|-----------------|------------|
| STATION                  | ELEVATION |                         | Depth        | MANHOLE           | 4-INCH "Y" BRANCHES               |                                   | No. of Permit |            | House Number   |                    | DATE OF PERMITS |            |
|                          | Ground    | Grade                   |              |                   | North West                        | South East                        | North West    | South East | North West     | South East         | North West      | South East |
| Lat. 23, sub. 5A, W.I.S. |           |                         |              |                   |                                   |                                   |               |            |                |                    |                 |            |
| 0+00                     | 172.3     | 163.01                  | 9.3          |                   |                                   |                                   |               |            |                |                    |                 |            |
| 1+00                     | 170.7     | 163.21                  | 7.5          |                   |                                   |                                   |               |            |                |                    |                 |            |
| 2+00                     | 170.7     | 163.41                  | 7.3          |                   |                                   |                                   |               |            |                |                    |                 |            |
|                          | 171.4     | out 163.61<br>in 163.71 | 7.3<br>7.7   | 2+99 <sup>o</sup> |                                   |                                   |               |            |                |                    |                 |            |
| 3+00                     | 171.4     | 163.71                  | 7.7          |                   |                                   |                                   |               |            |                |                    |                 |            |
|                          |           |                         |              |                   | 3+35 <sup>o</sup>                 | 3+37 <sup>o</sup>                 |               | B3515      | 7416<br>Pagent |                    |                 | 6-3-65     |
| 4+00                     | 172.0     | 163.91                  | 8.1          |                   |                                   |                                   |               |            |                |                    |                 |            |
|                          |           |                         |              |                   | 4+28 <sup>o</sup>                 | 4+30 <sup>o</sup>                 |               | B2032      | 7412<br>Pagent | 7412<br>Norfolk    | 9-28-64         | 9-28-65    |
|                          | 172.6     | out 164.07<br>in 164.17 | 8.5<br>8.4   | 4+80 <sup>o</sup> |                                   |                                   |               |            |                |                    |                 |            |
| 5+00                     | 172.9     | 164.21                  | 8.7          |                   |                                   |                                   |               |            |                |                    |                 |            |
|                          |           |                         |              |                   | 5+34 <sup>o</sup>                 | 5+36 <sup>o</sup>                 |               | B3023      | 7407<br>Pagent | 7408<br>Norfolk    | 1-6-65          | 5-3-67     |
| 6+00                     | 173.1     | 164.41                  | 8.7          |                   |                                   |                                   |               |            |                |                    |                 |            |
|                          |           |                         |              |                   | 6+27 <sup>o</sup>                 | 6+29 <sup>o</sup>                 |               | B2050      | 7401<br>Pagent | 7404<br>Norfolk    | 9-30-64         | 9-11-67    |
| 7+00                     | 173.5     | 164.61                  | 8.9          |                   |                                   |                                   |               |            |                |                    |                 |            |
|                          | 174.1     | out 164.65<br>in 164.75 | 9.5<br>9.4   | 7+22 <sup>o</sup> |                                   |                                   |               |            |                |                    |                 |            |
|                          |           |                         |              |                   | 7+29 <sup>o</sup>                 | 7+31 <sup>o</sup>                 |               | B2073      | 7327<br>Pagent | 7328<br>Norfolk    | 10-5-64         | 5-13-65    |
| 8+00                     | 173.5     | 165.07                  | 8.4          |                   |                                   |                                   |               |            |                |                    |                 |            |
|                          |           |                         |              |                   | 8+18 <sup>o</sup>                 | 8+20 <sup>o</sup>                 |               | B2614      | 7317<br>Pagent | 7316<br>Norfolk    | 1-6-65          | 5-13-65    |
| 9+00                     | 173.6     | 165.47                  | 8.1          |                   |                                   |                                   |               |            |                |                    |                 |            |
|                          |           |                         |              |                   | 9+07 <sup>o</sup>                 | 9+09 <sup>o</sup>                 |               | B1823      | 7305<br>Pagent | 7302<br>Norfolk    | 8-21-64         | 5-13-65    |
|                          | 173.9     | 165.55                  | 8.4          | 9+21 <sup>o</sup> |                                   |                                   |               |            |                |                    |                 |            |
| LAT. 26, SUB. 5A, W.I.S. |           |                         |              |                   |                                   |                                   |               |            |                |                    |                 |            |
| 0+00                     | 169.7     | 156.9                   | 13.7         |                   |                                   |                                   |               |            |                |                    |                 |            |
|                          | 170.0     | out 156.16<br>in 156.30 | 13.8<br>13.7 | 0+99 <sup>o</sup> |                                   |                                   |               |            |                |                    |                 |            |
|                          | 169.6     | out 156.43<br>in 156.51 | 13.2<br>13.1 | 0+91 <sup>o</sup> |                                   |                                   |               |            |                |                    |                 |            |
| 1+00                     | 170.2     | 156.57                  | 13.6         |                   |                                   |                                   |               |            |                |                    |                 |            |
| 2+00                     | 170.5     | 156.89                  | 13.6         |                   |                                   |                                   |               |            |                |                    |                 |            |
|                          | 170.9     | out 157.00<br>in 157.00 | 13.9         | 2+40 <sup>o</sup> | 8" stub S.E.<br>2+67 <sup>o</sup> | 4" stub S.E.<br>2+65 <sup>o</sup> |               | B3402      | 122<br>Rutland | 115<br>Brandonwood | 5-13-65         | 8-29-66    |
| 3+00                     | 171.1     | 157.30                  | 13.8         |                   |                                   |                                   |               |            |                |                    |                 |            |
|                          | 171.4     | 157.92                  | 13.7         | 3+41 <sup>o</sup> |                                   |                                   |               |            |                |                    |                 |            |
|                          |           |                         |              |                   | 3+60 <sup>o</sup>                 |                                   |               |            |                |                    |                 |            |
|                          |           |                         |              |                   |                                   |                                   |               | B3977      | 144<br>Rutland |                    |                 | 8-17-65    |
| 4+00                     | 171.7     | 157.72                  | 14.0         |                   |                                   |                                   |               |            |                |                    |                 |            |
|                          |           |                         |              |                   | 4+55 <sup>o</sup>                 |                                   |               |            |                |                    |                 |            |
|                          |           |                         |              |                   | 4+53 <sup>o</sup>                 |                                   |               |            |                |                    |                 |            |
| 5+00                     | 172.5     | 158.04                  | 14.5         |                   |                                   |                                   |               |            |                |                    |                 |            |
|                          |           |                         |              |                   | 5+14 <sup>o</sup>                 |                                   |               |            |                |                    |                 |            |
|                          |           |                         |              |                   | 5+25 <sup>o</sup>                 |                                   |               |            |                |                    |                 |            |
|                          |           |                         |              |                   | 5+67 <sup>o</sup>                 |                                   |               |            |                |                    |                 |            |
|                          |           |                         |              |                   | 4+53 <sup>o</sup>                 |                                   |               |            |                |                    |                 |            |
| 6+00                     | 173.1     | out 158.33<br>in 158.30 | 15.8<br>15.8 | 5+92 <sup>o</sup> | 8" stub N.E.                      |                                   |               |            |                |                    |                 |            |
|                          | 172.9     | 162.99                  | 10.9         |                   | 6+02 <sup>o</sup>                 |                                   |               |            |                |                    |                 |            |
|                          | 173.0     | 163.72                  | 9.3          | 6+87 <sup>o</sup> | 4" stub NW                        | 4" stub S.                        |               | B3407      | 7315<br>Pagent |                    |                 | 5-13-65    |
|                          |           |                         |              |                   |                                   |                                   |               | B3406      | 7301<br>Pagent | 200<br>Rutland     | 5-13-65         | 3-12-65    |

B2198-9421 770 folks - Reginald Alley - 1-5-65 - top (3+75.0)  
 B3507-168 Rutland - De Druffin - 6-2-65 - top (1+60.2)  
 Top B3591-7400 Pagent Dr. - Kennedy Pkwy. - 5-10-66 (6+74.3)