


Scale
1"=100'

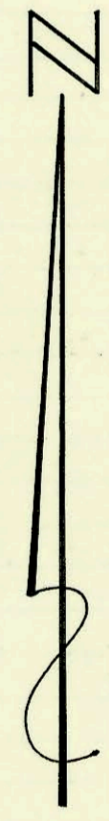

LAT. 17, SUB. 17, S. S. 22
 W. B. CARTER CONSTRUCTION CO., INC. 11-10-64
 PROJ. NO. C23-37 K-86 BOOKED 12-15-64

