183A

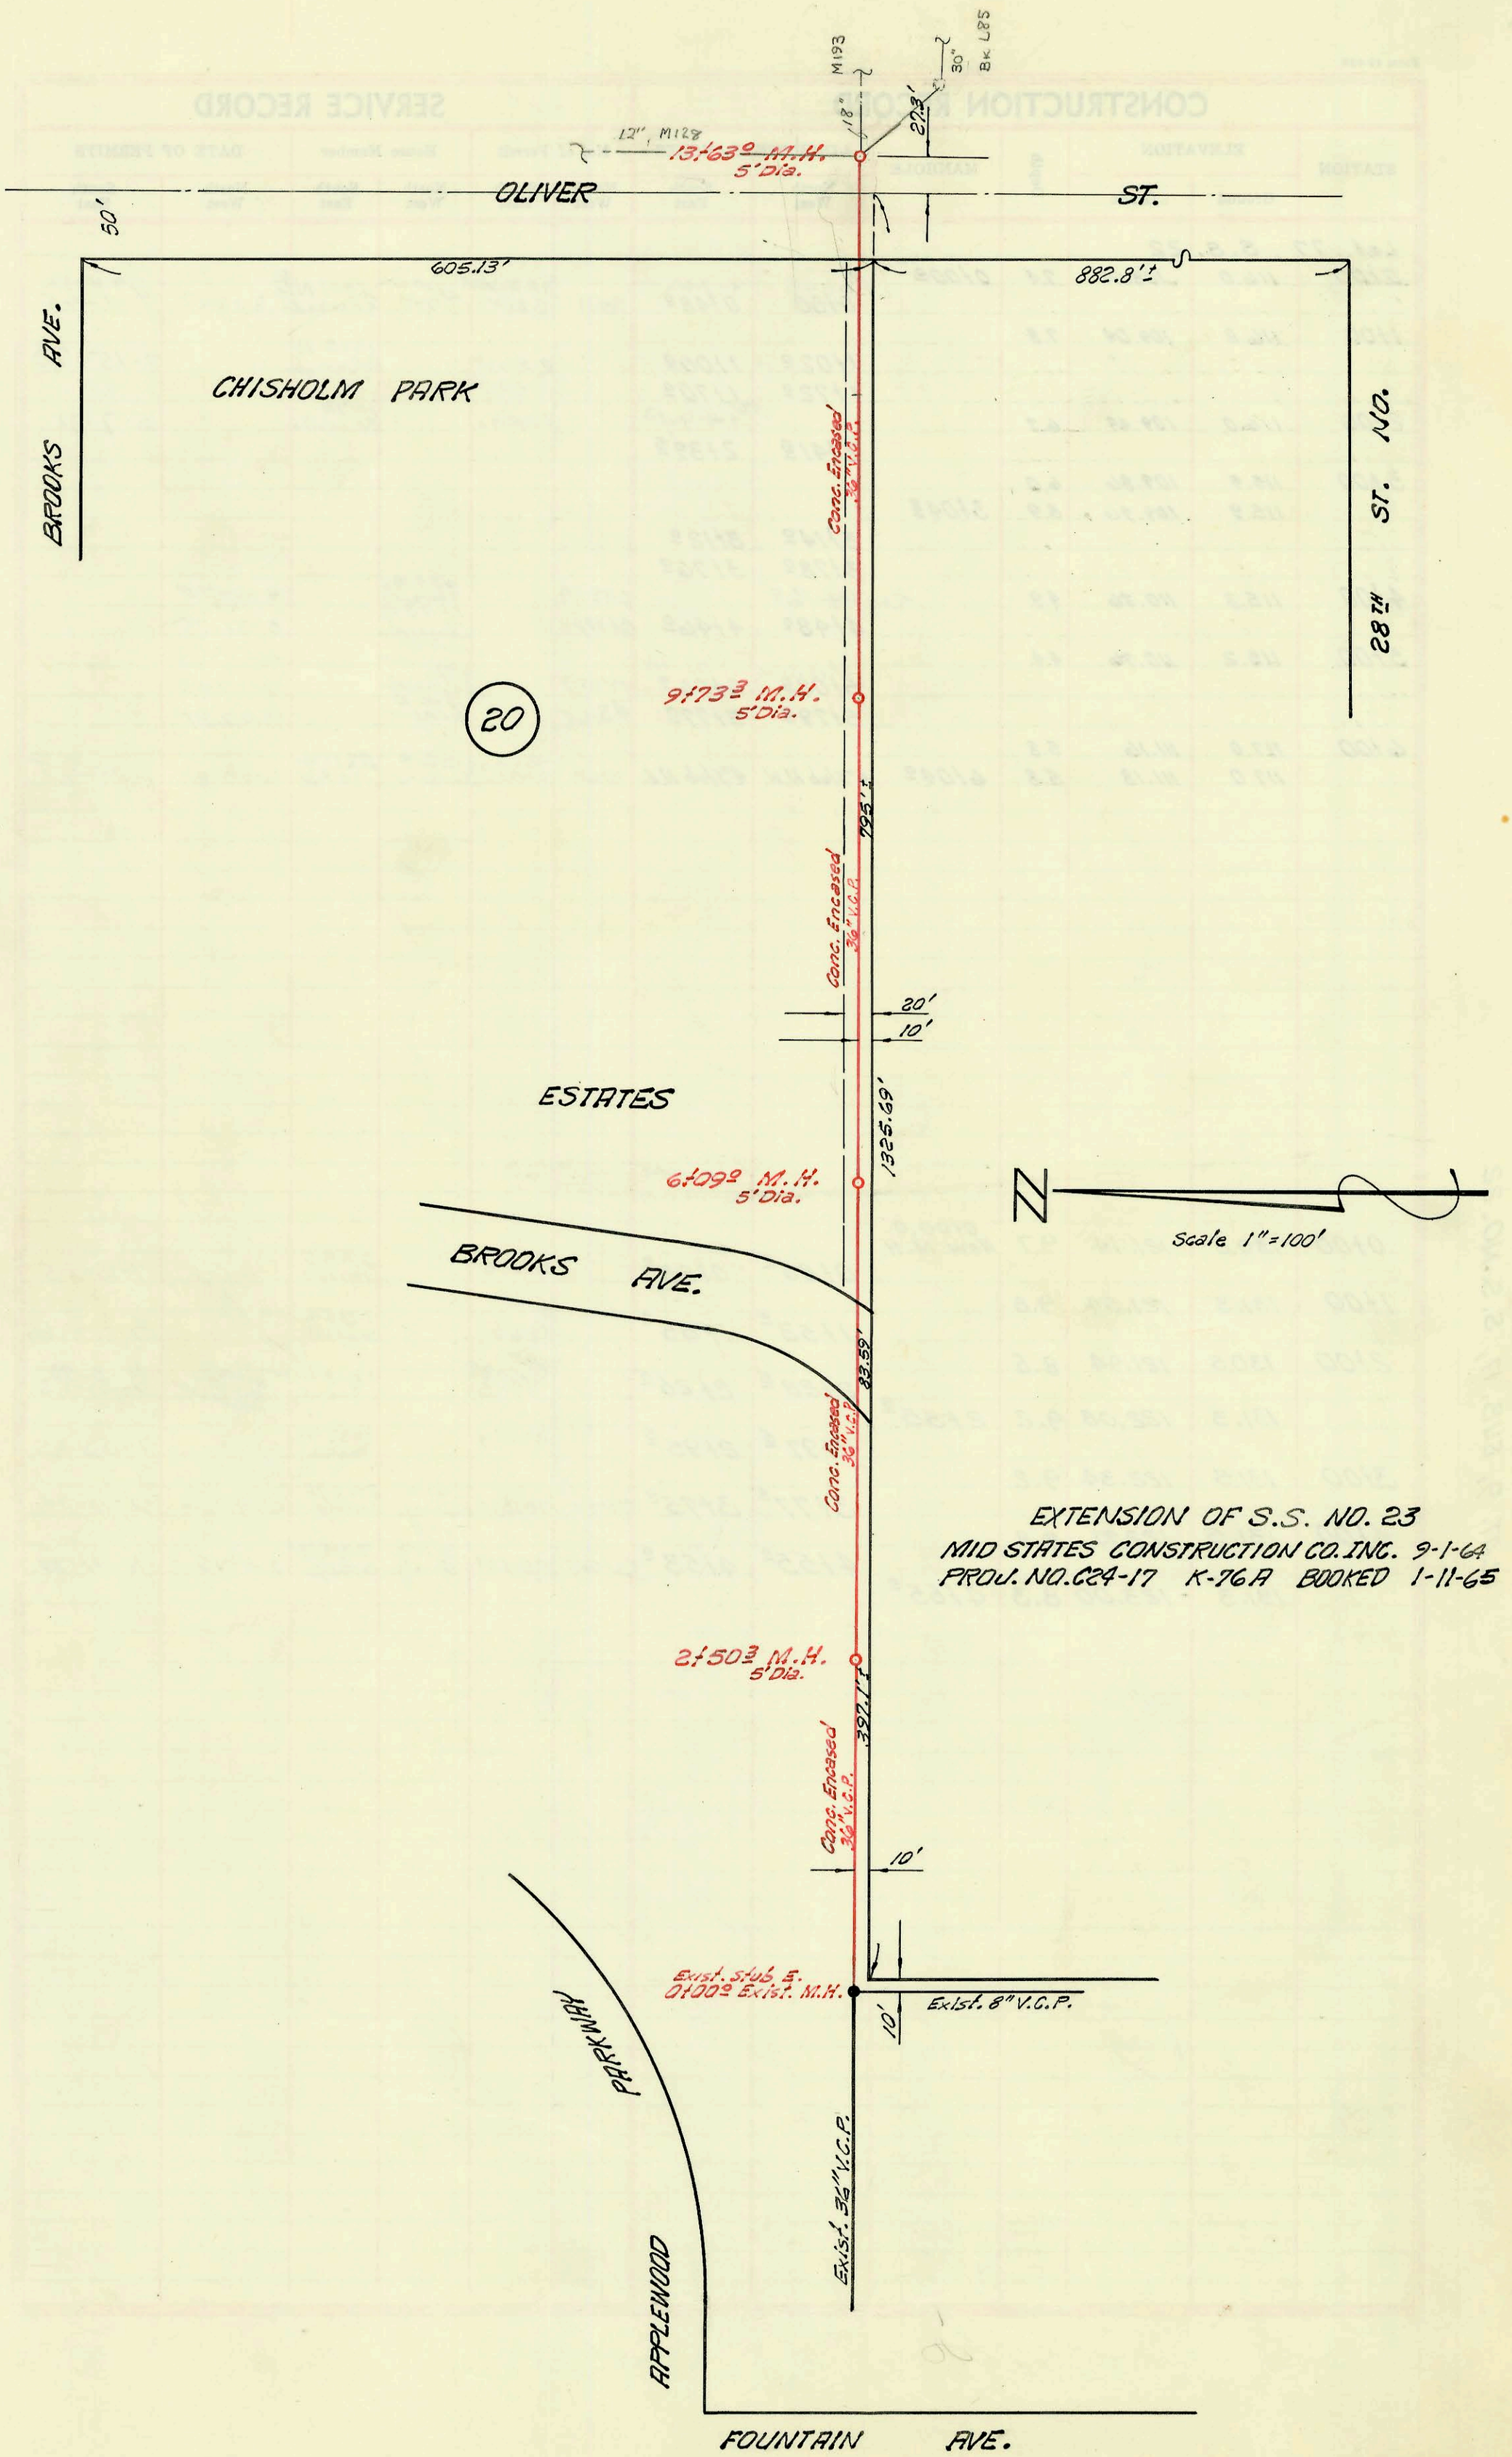

EXTENSION OF S.S. NO. 23
MID STATES CONSTRUCTION CO. INC. 9-1-64
PROJ. NO. C24-17 K-76A BOOKED 1-11-65

183

Form 42-020

CONSTRUCTION RECORD							SERVICE RECORD					
STATION	ELEVATION		Depth	MANHOLE	4-INCH "Y" BRANCHES		No. of Permit		House Number		DATE OF PERMITS	
	Ground	Grade			North West	South East	North West	South East	North West	South East	North West	South East
EXTENTION OF S.S.23												
0+00	150.4	137.91	12.5	Exist. 0+00 º	(Exist. 36" stub)							
1+00	149.4	138.07	11.3									
2+00	152.4	138.23	14.2									
	152.8	138.31	14.5	2+50 ³								
3+00	150.5	138.39	12.1									
4+00	151.2	138.55	12.7									
5+00	155.3	138.71	16.6									
6+00	159.2	138.87	20.3									
	159.5	138.89	20.6	6+09 º								
7+00	160.4	139.03	21.4									
8+00	160.2	139.19	21.0									
9+00	157.0	139.35	17.7									
	156.5	139.47	17.0	9+73 ³								
10+00	156.8	139.51	17.3									
11+00	157.4	139.67	17.7									
12+00	158.3	139.83	18.5									
13+00	159.3	139.99	19.3									
	160.0	140.09	19.9	13+63 º								

K