K207A

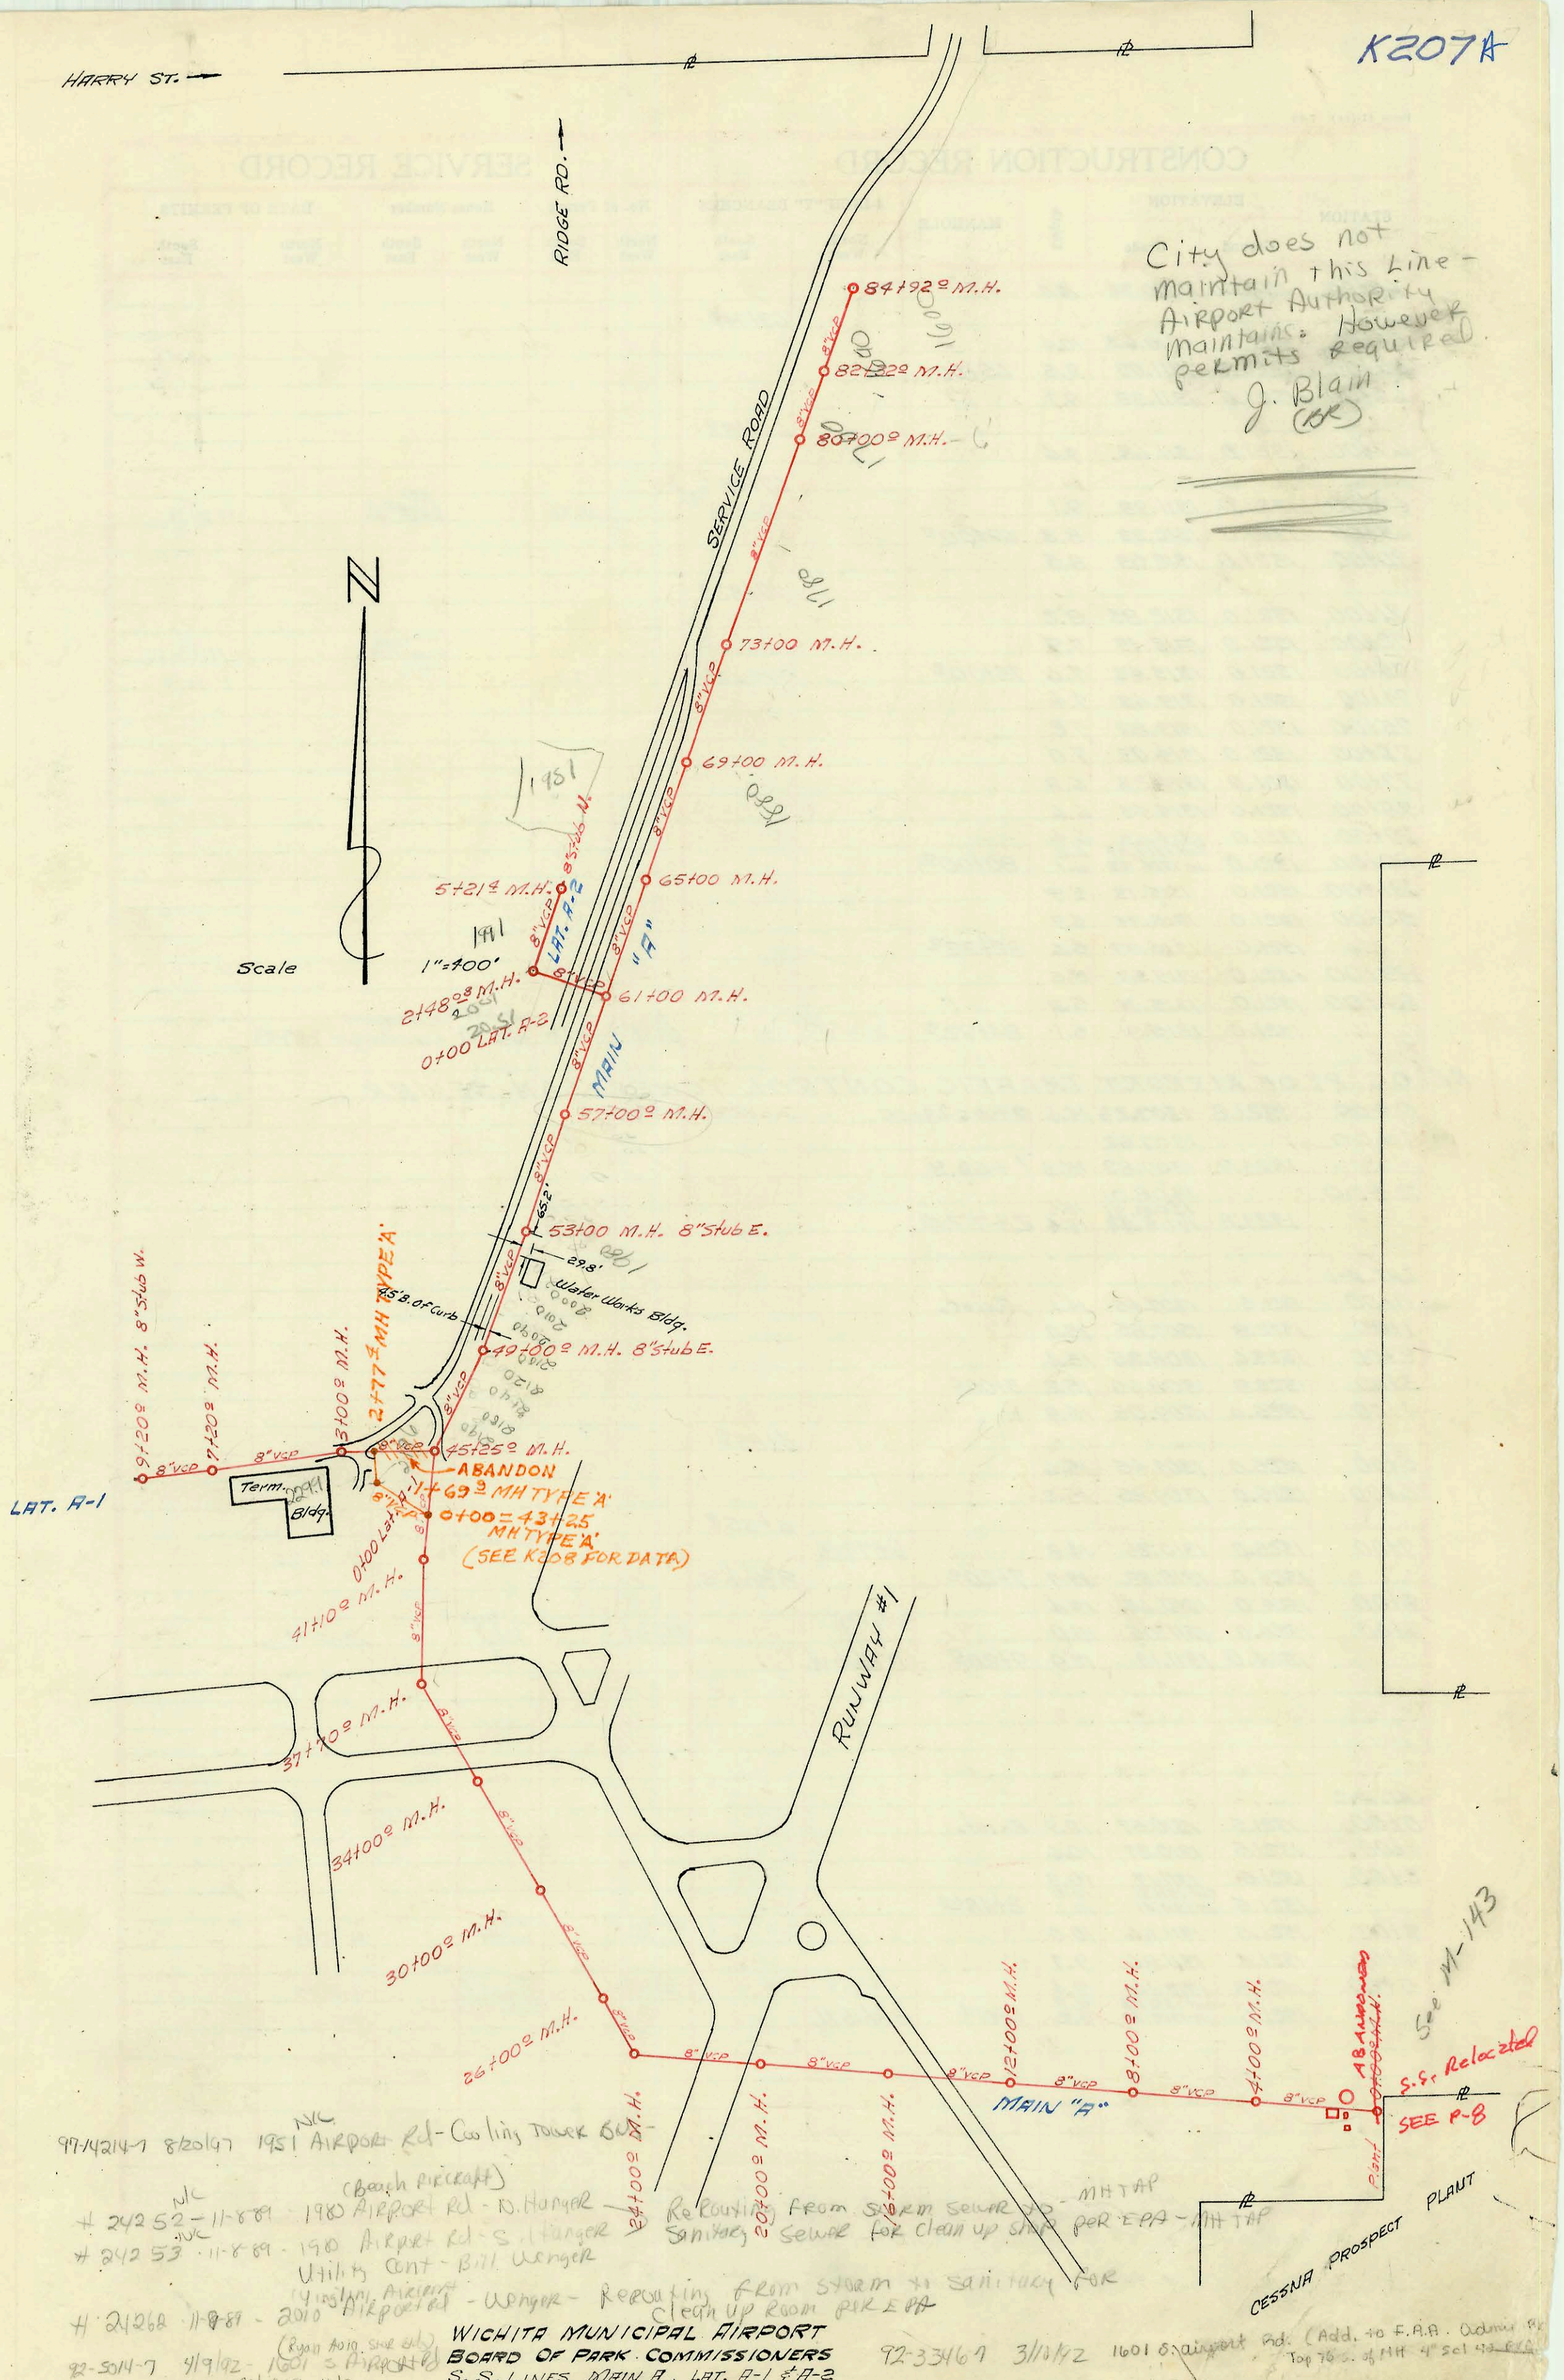

City does not maintain this Line - Airport Authority maintains. However permits required.
J. Blain (KK)

See M-143

97-14214-7 8/20/97 1951 Airport Rd - Cooling Tower Bldg - NIC (Beech Aircraft)

#24252 - 11-8-89 1980 Airport Rd - N. Hanger - NIC

#24253 - 11-8-89 - 1980 Airport Rd - S. Hanger - NIC
Utility Cont - Bill Wenger

#21262 11-8-89 - 2010 Airport Rd (Wichita Airport) - Wenger - Rerouting from storm to sanitary for clean up room per EPA

92-5014-7 4/9/92 - 1601 S. Airport Rd (Ryan Aviation Service Bldg) Bldg #19 - NIC - (M.H. Top 6" SDR 35)

Rerouting from storm sewer to sanitary sewer for clean up shop per EPA - MH TAP

92-33467 3/10/92 1601 S. Airport Rd. (Add. to F.A.A. Admin Bldg) Top 76'S. of MH 4" Scl 40 PVC

92-35477 3/13/92 1601 S. Airport Rd - Storage Bldg for FAA - Airport Bldg - NIC (Top 74'S of MH. 4" Scl 40 PVC)

WICHITA MUNICIPAL AIRPORT
BOARD OF PARK COMMISSIONERS
S.S. LINES MAIN A, LAT. A-1 & A-2
EDIGER ENGINEERING COMPANY 1952
PLANS. PRIVATE BOOKED 10-7-63
RELOCATION CONTROL TOWER SEWER
BUILT BY: UTILITY CONTR. INC
PROJ. Nº 468-76-245-80000-000-000-008
BOOKED 4-1-82 FROM BR54

208

Form 41-(54) 7-60

CONSTRUCTION RECORD							SERVICE RECORD					
STATION	ELEVATION		Depth	MANHOLE	4-INCH "Y" BRANCHES		No. of Permit		House Number		DATE OF PERMITS	
	Ground	Grade			North West	South East	North West	South East	North West	South East	North West	South East
63+00	1321.0	1310.33	10.7									
						63+94 S						
64+00	1321.0	1310.63	10.4									
65+00	1320.5	1311.03	9.5	65+00								
66+00	1321.0	1311.33	9.7									
						66+18 S						
67+00	1321.0	1311.63	9.4									
						67+43 ±						
68+00	1321.0	1311.93	9.1			67+79.4 TAP		22105		1880 Airport Rd		11-29-86
69+00	1321.0	1312.23	8.8	69+00 S								
70+00	1321.0	1312.53	8.5									
						70+82 ±						
71+00	1321.0	1312.83	8.2									
72+00	1321.0	1313.13	7.9			73+23.0		4646		1601 Hangar Airport Rd #27		11-13-81
73+00	1321.0	1313.43	7.6	73+00 S		72+93.0 Tap		4725		Hangar #27 Unit 1760		11-18-81
74+00	1321.0	1313.63	7.4									
75+00	1321.0	1313.83	7.2									
76+00	1321.0	1314.03	7.0									
77+00	1321.0	1314.23	6.8									
78+00	1321.0	1314.43	6.6									
79+00	1321.0	1314.63	6.4									
80+00	1321.0	Out 1314.83 In 1314.93	6.2 6.1	80+00 S								
81+00	1321.0	1315.13	5.9									
82+00	1321.0	1315.33	5.7									
	1321.0	1315.39	5.6	82+32 S								
83+00	1321.0	1315.53	5.5									
84+00	1321.0	1315.73	5.3									
	1321.0	1315.91	5.1	84+92 S	MH TAP		22490	6272	1601 Airport 1640 #17	1601 Airport 1640-19 Hangar	1-27-89	
RELOC PT OF AIRPORT TRAFFIC CONTROL TOWER SAN SEWER												
0+00	1321.8	1307.23	14.6	0+00 = 43+25								
1+00		1307.62										
	1323.2	1307.89	15.3	1+69.9								
2+00		1308.01										
		1308.31	15.5									
	1323.8	1308.44	15.4	2+77.4								
LAT. A-1												
0+00	1321.5	1307.45	14.1	Exist.								
1+00	1322.8	1307.85	15.0									
2+00	1323.6	1308.25	15.4									
3+00	1323.8	1308.65	15.2	3+00 S								
4+00	1325.0	1309.05	15.9									
						4+83 S						
5+00	1325.0	1309.45	15.6									
6+00	1325.0	1309.85	15.2									
						6+35 S						
7+00	1325.0	1310.25	14.8		6+79.3		C51723		Hanger #20		10-6-75	
	1324.0	1310.33	13.7	7+20 S		8" Stub S.						
8+00	1324.0	1310.65	13.4									
9+00	1324.0	1311.05	13.0		MH tap West		C68726		Air Cargo Bldg		10-5-78	
	1324.0	1311.13	12.9	9+20 S	8" Stub W.							
LAT. A-2												
0+00	1321.5	1310.57	10.9	Exist.								
1+00	1321.5	1310.87	10.6									
2+00	1321.5	1311.17	10.3									
		Out 1311.31	10.2									
	1321.5	In 1311.41	10.1	2+48 S								
3+00	1321.5	1311.56	10.0				2002 01052		1951 Airport		4-11-02	
4+00	1321.5	1311.86	9.7									
5+00	1321.5	1312.16	9.4		5+14.6		C60164		1601 S 1951 Airport Rd. Flight Safety Int.		3-2-77	
		Out 1312.23	9.3									
	1321.5	In 1312.33	9.2	5+21 ±	8" Stub N.							

97-15490-7 9-10-97 1601 S. Airport Rd (2073 Air Cargo Rd)

N/C 1601 Airport Rd #2299 Term. Bldg. 8-15-84 MH tap in Private line.

#24685 1-2-90 1760 S. Airport Rd (Koch Hanger) Jim Morris - N/C -

K-208

A