


MAIN 24, WAR INDUSTRIES (PHASE II)
 468-76-245-81477-000-000-001
 Built By Mid-States Const.
 Booked 7-22-87 from AR-90

9910 clubhouse PR

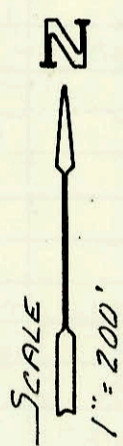

NW Cor. Sec. 9
 T 27 S R 2 E.

21st St. No.

Center Sec. 4, T 27 S, R 2 E

154+45.3 PLUG
 153+51.3 MH Tr 'P'
 8" stubs W & E
 152+68.1 MH Tr 'P'
 150+37.6 MH Tr 'P'
 8" stub SW
 147+87.5 MH Tr 'P'
 8" stub SW
 146+27.8 MH Tr 'P'
 140+81.8 MH Tr 'P'
 138+41.6 MH Tr 'P'
 136+05.5 MH Tr 'P'
 8" stubs W & E
 132+30.0 MH Tr 'P'
 8" stubs W & E
 128+56.2 MH Tr 'P'
 124+82.0 MH Tr 'P'
 40 L.F. 10" stub E.
 123+57.3 MH Exist.

30' Sdn. Sewer Esmt

30' Sdn. Sewer Esmt

Outside Drop

50' L.F. 22" steel Casing

75' K6+E Esmt
1165.44'±

K232

K228

50' 50'

122120'±

CONSTRUCTION RECORD						SERVICE RECORD						
STATION	ELEVATION		Depth	MANHOLE	4-INCH "Y" BRANCHES		No. of Permit		House Number		DATE OF PERMITS	
	Ground	Grade			North West	South East	North West	South East	North West	South East	North West	South East
MAIN 24, WIS	(Phase II)											
	203.03	187.23 OUT 187.40 IN	15.8	EXIST. 123+57.3								
124+00	202.2	187.70	14.5									
	204.80	188.29 OUT 188.43 IN	16.5	124+82.0		40' 10" stub E						
125+00	203.8	188.47	15.3									
126+00	202.0	188.67	13.3									
127+00	202.5	188.87	13.6									
128+00	202.6	189.08	13.5									
	206.45	189.19 OUT 189.29 IN	17.3	128+56.2								
129+00	203.5	189.38	14.1									
130+00	203.8	189.60	14.2									
131+00	204.7	189.81	14.9									
132+00	206.2	190.03	16.2									
	207.86	190.09 OUT 190.31 IN	17.8	132+30.0	8" stub W	8" stub E						
133+00	208.0	190.49	17.5									
134+00	209.5	190.74	18.8									
135+00	211.1	191.00	20.1									
136+00												
	212.27	191.27 OUT 191.32 IN	21.0	136+05.5	8" stub W	8" stub E						
137+00	213.1	191.53	21.6									
138+00	214.9	191.75	23.2									
	215.40	191.84	23.6	138+41.6								
139+00	215.0	191.91	23.1									
140+00	215.0	192.04	23.0									
	214.06	192.14 OUT 192.17 IN	21.9	140+81.8								
141+00	214.6	192.20	22.4									
142+00	213.3	192.36	20.9									
143+00	211.2	192.52	18.7									
144+00	209.5	192.68	16.8									
145+00	208.6	192.84	15.8									
146+00	208.3	193.01	15.3									
	210.37	193.05 OUT 193.25 IN	17.3	146+27.8								
147+00	209.0	193.41	15.6									
	210.56	193.60	17.0	147+87.5		8" stub SW						
148+00	210.2	193.61	16.6									
149+00	210.8	193.69	17.1									
150+00	210.9	193.78	17.1									
	209.83	193.81 OUT 194.00 IN	16.0	150+37.6		8" stub SW						
151+00	209.0	194.12	14.9									
152+00	206.8	194.32	12.5									
	206.31	194.45 OUT 194.63 IN	11.9	152+68.1								
153+00	204.9	194.71	10.2									
	206.25	194.83 OUT 194.85 IN	11.4	153+51.3	8" stub W	8" stub E						
154+00	204.8	194.94	9.9									
154+45.3	205.4	195.02	10.4									