



LIFT STATION AND FORCE MAIN
in conn. with LAT 241, SWI
468-76-245-81696-000-000-001
Built By Utility Contr.
Booked 12-2-87 From KW #8

LAT 241, SWI
468-76-245-81697-000-000-001
Built By Utility Contr.
Booked 12-2-87 From KW #8

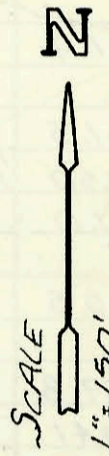

Need \$400 Spec
Ass. for Lots
14-18
& Gray's
4th
to rip into
J-203

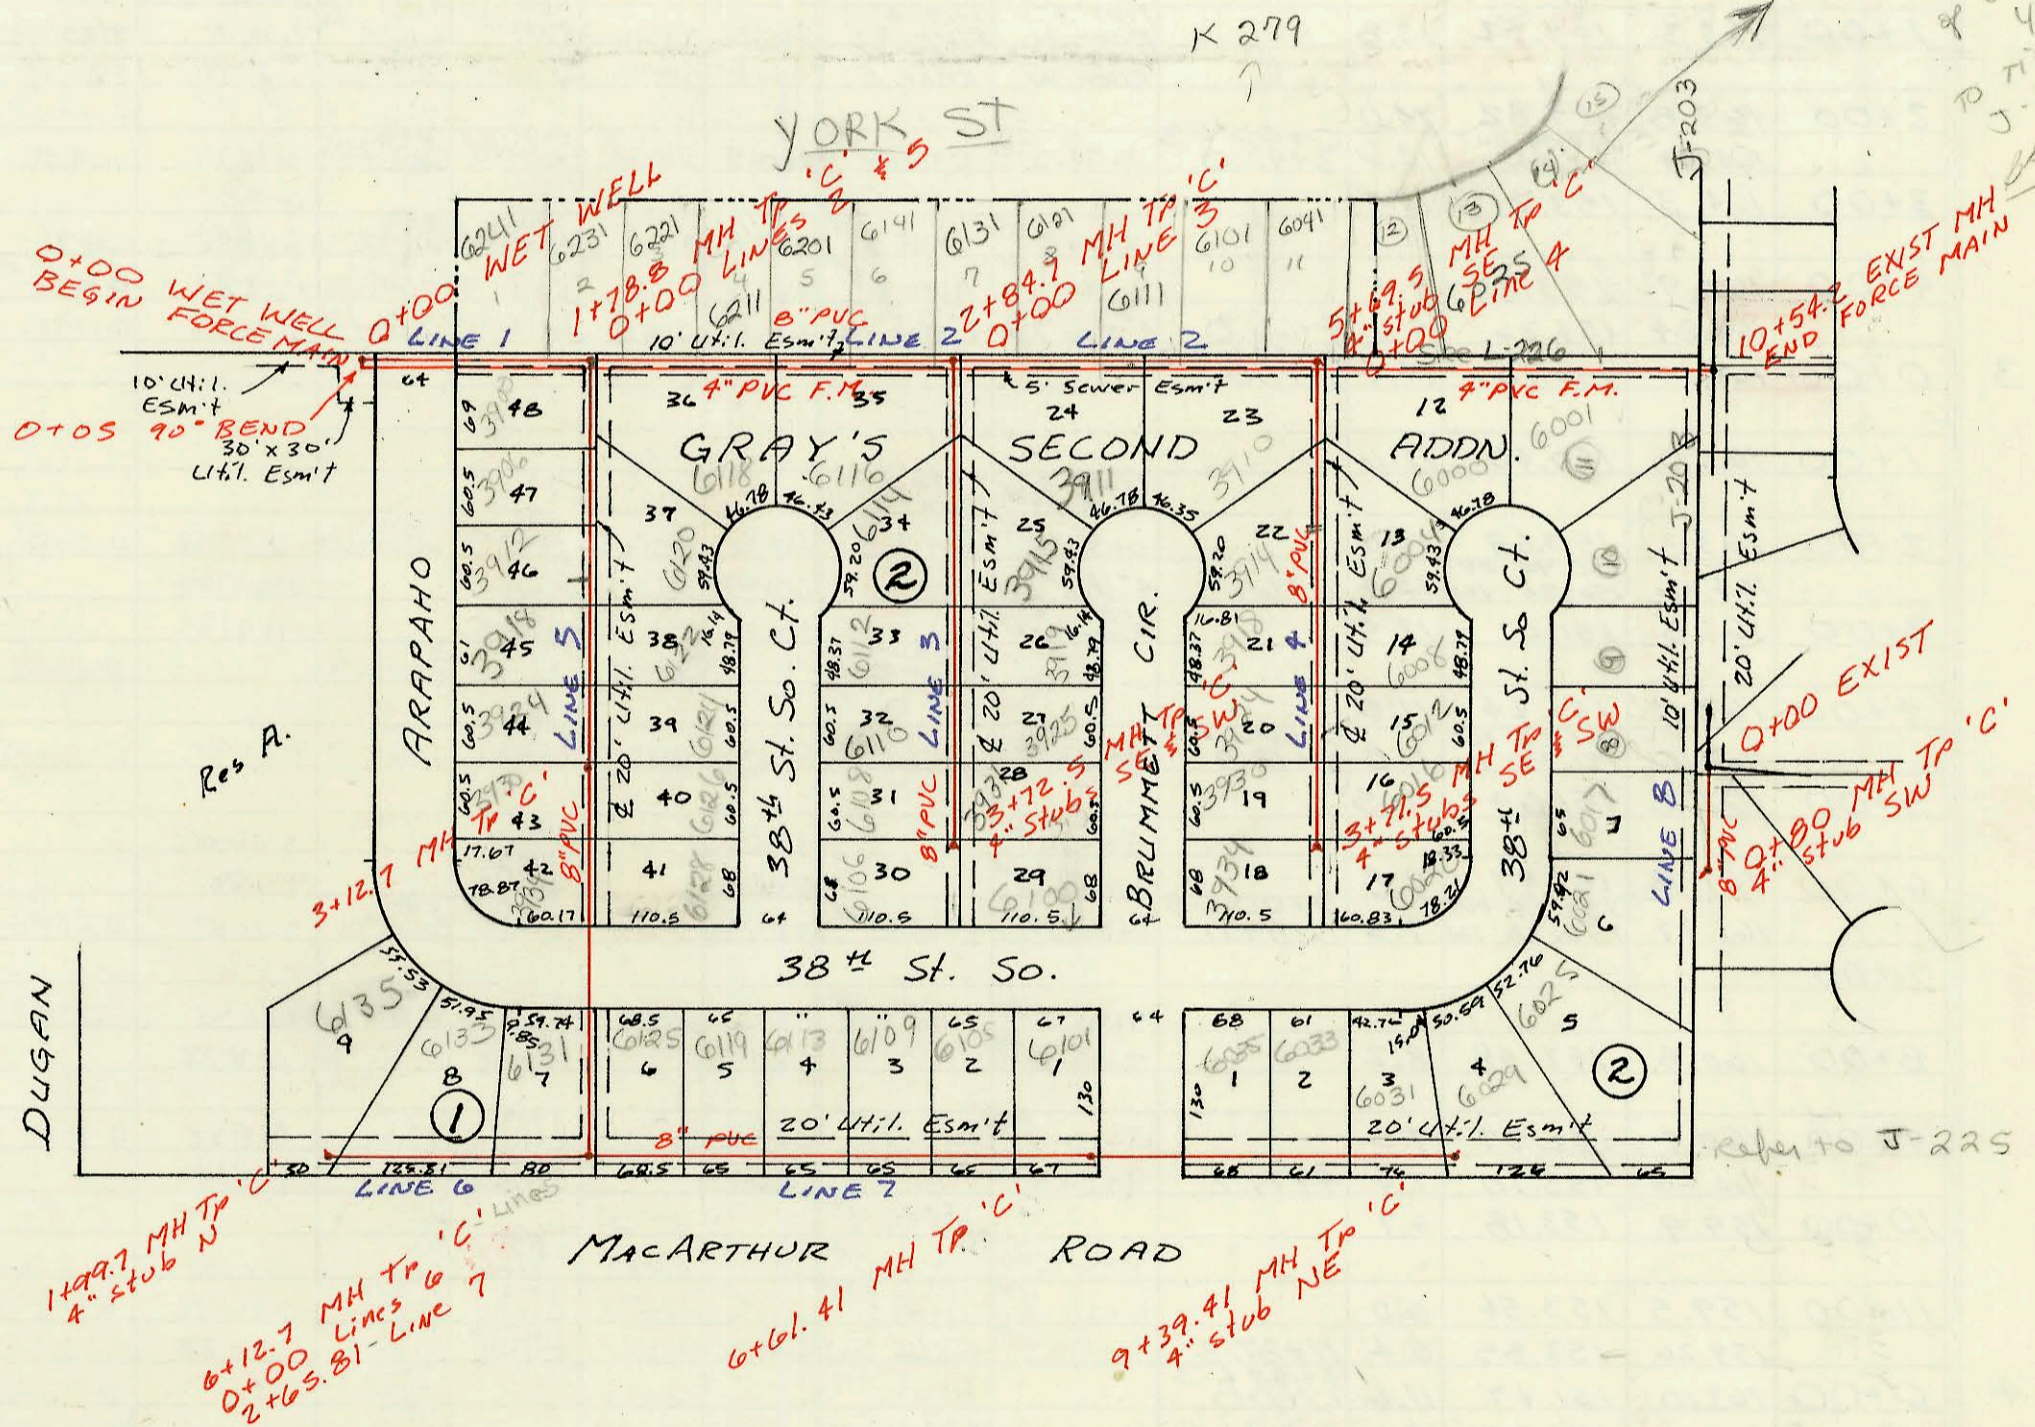

Plot
6-77

CONSTRUCTION RECORD							SERVICE RECORD					
STATION	ELEVATION		Depth	MANHOLE	4-INCH "Y" BRANCHES		No. of Permit		House Number		DATE OF PERMITS	
	Ground	Grade			North West	South East	North West	South East	North West	South East	North West	South East
LAT 241 SWI												
LINE 1	0+00	118.10	104.33	13.8	0+00							
	1+00	117.5	104.62	12.9		0+92.8 TAP		24896		6241 YORK		3-5-90
		118.20	104.85 OUT	13.4	0+00 L-2 4'-5	1+70.8 TAP		21912		6231 YORK		11/14/86
LINE 2	0+00	118.20	108.11	10.1	0+00							
	1+00	118.3	108.44	9.9		0+56.0 TAP	0+75	21913	19180	6221 YORK	6184 38th S.W.	11/14/86
	2+00	119.5	108.78	10.7		1+10.0 TAP		21967		6211 YORK		11-14-88
		120.02	109.06	11.0	0+00 L-3	1+64.7 TAP		23495		6201 YORK		7-1-89
	3+00	119.6	109.24	10.4	2+84.7	2+44.7 TAP	2+15	22350	19179	6141 YORK	6116 38th S.W.	1-9-89
	4+00	120.2	110.44	9.8		3+15.7 TAP	3+79.7	25052	19307	6131 YORK	3911 BRUMMETT CT	1-5-90
	5+00	121.6	111.64	10.0		3+56.7 TAP		25602		6121 YORK		6-21-90
		123.30	112.47	10.8	0+00 L-4	4+14.7 TAP		23412		6111 YORK		6-22-89
LINE 3	0+00	120.02	109.37	10.7	0+00	4+32.5 TAP		23077		6101 YORK CT		1-5-89
	1+00	119.4	109.69	9.7		5+41.5 TAP	5+09.5 TAP	23262	20460	6041 YORK CT	310 BRUMMETT CT	5-23-89
		119.0	110.01	9.0		5+69.5 TAP	4" stub SE	19276		6031 YORK CT	6000 38th S.W.	10/05/87
	2+00	119.5	110.34	9.2		0+98.0 TAP	1+29.0 TAP	19902	20012	6114 38th S. CT	3915 BRUMMETT CT	12/29/87
		118.93	110.57	8.4	3+72.5	1+96.5 TAP		19116		6112 38th S.	3919 BRUMMETT CT	1-28-88
LINE 4	0+00	123.30	112.50	5.7	0+00	2+18.5 TAP	2+56.5 TAP	19178		6112 38th S.	3925 CT	9/30/87
	1+00	122.8	112.80	10.0		2+46.5 TAP	3+23.5 TAP	221654	19177	6108 38th S. CT	3931 BRUMMETT CT	3-2-89
	2+00	122.5	113.11	9.4		3+23.5 TAP	3+16.5 TAP	20457	21347	6106 38th S. CT	3931 BRUMMETT CT	4-13-88
	3+00	122.0	113.41	8.6		4" stub SW	4" stub SE	21226	21104	6106 38th S. CT	6100 38th S. CT	8-1-88
	4+00	122.26	113.63	8.6	3+71.5	4" stub SW	4" stub SE	22879	22717	6106 38th S. CT	6100 38th S. CT	10/04/88
LINE 5	0+00	118.20	104.95	13.3	0+00	4" stub SW	4" stub SE	20350		6106 38th S. CT	6100 38th S. CT	3-28-88
	1+00	117.9	105.25	12.7		4" stub SW	4" stub SE	21987	20201	3914 BRUMMETT CT	6041 38th S. CT	10/27/88
	2+00	117.3	105.54	11.8		1+32.0 TAP	1+94.5 TAP	21452		6008 38th S.		7-8-88
	3+00	117.1	105.84	11.3		2+17.5 TAP	2+57.5 TAP	21259		3918 BRUMMETT CT		8-5-88
	4+00	116.6	106.19	10.4		2+90.5 TAP	2+52.5 TAP	21065	21575	3924 BRUMMETT CT	6012 38th S.	7-13-88
	5+00	116.5	106.54	10.0		3+55.5 TAP	2+52.5 TAP	21474	21853	6130 BRUMMETT CT	6016 38th S. CT	9-13-88
	6+00	116.2	106.89	9.3		4" stub SW	4" stub SE	22879	22717	3934 BRUMMETT CT	6016 38th S. CT	4-7-89
LINE 6	0+00	116.66	106.93	9.7	0+00	0+16.6 TAP		20350		6106 38th S. CT	6100 38th S. CT	3-28-88
	1+00	115.8	107.21	8.6		1+17.0 TAP		21202	19151	3904 ARAPHO	6121 38th S. CT	8-1-88
	2+00	116.66	106.93	9.7		1+78.0 TAP		20401		3912 ARAPHO		4-5-88
	3+00	117.1	105.84	11.3		2+25.7 TAP	2+05.0 TAP	19875	19516	3918 ARAPHO	6122 38th S. CT	5-10-88
	4+00	117.49	105.88	11.6	3+12.7	2+62.7 TAP	3+61.7 TAP	19364	19163	3924 ARAPHO	6124 38th S. CT	12/17/87
	5+00	116.5	106.54	10.0		3+61.7 TAP	3+92.7 TAP	19175	19163	3930 ARAPHO	6126 38th S. CT	9/30/87
	6+00	116.2	106.89	9.3		4+14.7 TAP	3+98.7 TAP	21915	19164	3934 ARAPHO	6128 38th S. CT	9/30/87
LINE 7	0+00	116.66	106.93	9.7	0+00	0+27.0 TAP		21785		6131 38th S.		10-27-88
	1+00	115.8	107.21	8.6		0+50.7 TAP		21449		6133 38th S.		9/8/88
	2+00	116.59	107.49	9.1	1+99.7	4" stub N		2450		6135 W. 38th S.		11-3-92
LINE 8	2+65.81	116.66	107.30	9.4	2+65.81	3+33.81 TAP		19182		6125 W. 38th S.		9/30/87
	3+00	116.1	107.42	8.7		3+90.81 TAP		19869		6119 38th S.		12/17/87
	4+00	116.5	107.79	8.7				21030		6113 38th S.		7-6-88
	5+00	116.6	108.15	8.5		5+03.81 TAP		20334		6109 38th S.		3-25-88
	6+00	117.9	108.51	9.4		5+47.41 TAP		20708		6105 38th S.		5-20-88
	7+00	118.1	110.51	7.6		6+15.81 TAP		20200		6101 38th S.		3-1-88
	8+00	119.3	111.58	7.7		7+68.41 TAP		21545		6035 W. 38th S.		9/10/88
	9+00	121.1	112.64	8.5		8+10.9 TAP		22438		6033 W. 38th S.		1-23-89
	0+00	125.44	117.03	8.4	9+39.41	8+94.41 TAP		20903		6031 W. 38th S.		6-20-88
FORCE MAIN	0+00	117.85	108.58	9.3	0+00	4" stub NE		21404		6029 38th S.		8-30-88
	7+54.5	123.0	116.35	6.7	0+80	4" stub SW		20001		6011 W. 38th S. CT		1-26-88
	10+54.2	125.61	118.15	7.5				19275		6021 W. 38th S. CT		10/08/87