


LAT 7, MAIN 24, W.I.S.
 468-76-245-81663-000-000-001
 Built By Utility Contr.
 Booked 12-23-87 From AG-19

CLEAR

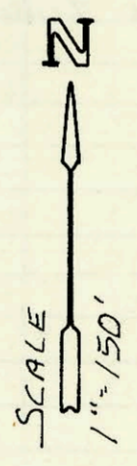

K-232

1335

Refer to K-214

K-214

LAT 7
LINE 1

LINE 2

LINE 3

LINE 4

LINE 5

LINE 6

CONSTRUCTION RECORD						SERVICE RECORD						
STATION	ELEVATION		Depth	MANHOLE	4-INCH "Y" BRANCHES		No. of Permit		House Number		DATE OF PERMITS	
	Ground	Grade			North West	South East	North West	South East	North West	South East	North West	South East
MAIN	24. WIS											
0+00	210.56	197.67	12.9	EXIST 0+00								
1+00	211.4	199.67	11.7		1+90.9		19834		2510 FOX RUN		12/02/87	
	212.34	200.98 OUT 202.90 IN	11.4	1+65.9								
2+00	213.0	203.59	9.4		2+00.90		20807		2508 FOX RUN		6-6-88	
					2+97.4 TAP		20461				4-13-88	
3+00	215.5	205.63	9.9									
4+00	218.0	207.66	10.3		3+78.4		19838		2506 FOX RUN		12/01/87	
	220.41	209.42 OUT 209.49 IN	11.0	4+86.4	4+48.4 TAP		21093		2509 FOX RUN		7-14-86	
5+00	220.2	209.55	10.7		5+10.9 TAP		20805		2502 FOX RUN		6-6-88	
6+00	220.4	209.98	10.4									
7+00	220.6	210.41	10.2									
	220.37	210.54 OUT 210.63 IN	9.8	7+30.1		7+85.1 TAP		24160		2501 FOX RUN		1-22-90
8+00	221.0	211.25	9.3									
9+00	222.4	213.35	9.1									
	223.53	214.04 OUT 214.17 IN	9.5	9+42.8		8+75.6 TAP		20893		2503 FOX RUN		6-17-88
						9+27.8 TAP		20358		2508 FOX RUN		3-28-88
10+00	224.3	214.65	9.7									
	226.86	215.37 OUT 217.43 IN	11.5	0+00 L-2 10+86.9								
11+00	226.7	217.56	9.1									
12+00	228.3	218.56	9.7									
	229.00	219.45 OUT 219.60 IN	9.6	12+88.9								
13+00	228.5	219.77	8.7		4" PVC 40 13+65.3		254787		9610 Clubhouse		3-30-85	
	230.56	221.04	9.5	13+81.3	4" stub NW		93-79697		9614 E. Clubhouse Ct			
0+00	226.86	215.57	11.3	10+86.9 L-1 0+00								
					4" PVC 40 2+63.5 TAP	0+53.0 TAP	2-8357	23363	9612 Clubhouse	2507 FOX RUN	6-2-92	6-15-89
1+00	228.0	215.99	12.0		4" PVC 40 97.0 TAP	TAP 1+65	72-3557	19835	7638 Clubhouse	2509 FOX RUN	3-12-92	12/08/87
2+00	229.5	216.42	13.1		4" PVC 40 1+60.5 TAP	TAP 2+60.6	72-8347	19836	7634 Clubhouse	2511 FOX RUN	6-3-92	12/08/87
3+00	230.0	216.84	13.2									
	230.38	216.99 OUT 217.18 IN	13.4	0+00 L-3 3+34.6								
	229.38	217.89	11.5	3+88.8	4" stub NE		20390		2581 FOX RUN		4-1-88	
0+00	230.38	217.12	13.3	3+34.6 L-2 0+00	0+12.0 TAP		20482		2599 FOX RUN		4-18-88	
					0+68.0 TAP	4" PVC 40 0+85.5 4" PVC 40 1+94.6	20938	93-159427	2537 FOX RUN	9630 Clubhouse	6-23-88	6-14-93
1+00	229.6	217.90	11.7		1+65.6 TAP			94-145377	2545 FOX RUN	9626 Clubhouse	6-16-89	9-7-91
2+00	229.4	218.68	10.7		4" PVC 40 2+71.6			93-294577	9622 Clubhouse		11-15-93	
	229.66	219.43	10.2	2+95.6	2+69.6 TAP	4" stub SW	22996	93-19517	2553 FOX RUN	9618 Clubhouse	3-27-89	1-28-83
0+00	209.83	197.83	12.0	EXIST 0+00	0+13.0 TAP		81287		2544 FOX RUN		8-26-88	
1+00	212.2	199.69	12.5		1+22.3 TAP		24762		2542 FOX RUN		3-19-90	
	212.96	199.83 OUT 202.70 IN	13.1	1+07.3		1+18.3 TAP		21315	2540 FOX RUN	2512 FOX RUN	8-16-88	
2+00	214.7	204.02	10.7		2+38.3 TAP	2+16.3 TAP	22792	23620	2540 FOX RUN	2514 FOX RUN	3-27-89	7-28-89
3+00	217.2	205.45	11.8		3+10.5 TAP	3+02.5 TAP	24810	19474	2538 FOX RUN	2516 FOX RUN	2-14-90	11/02/87
	219.01	206.19 OUT 209.04 IN	12.8	3+51.5	3+72.5 TAP		24826		2516 FOX RUN		11-02-89	
4+00	220.0	210.02	10.0									
					4+54.5 TAP	4+19.5 TAP	23933	19476	2534 FOX RUN	2518 FOX RUN	9-21-87	11/02/87
5+00	223.3	212.04	11.3		5+26.2 TAP	4+58.4 TAP	23749	19477	2532 FOX RUN	2520 FOX RUN	8-14-89	11/02/87
	226.19	213.66 OUT 213.95 IN	12.5	0+00 L-5 5+80.2		5+71.2 TAP		20604	2522 FOX RUN	2522 FOX RUN	4-24-88	
6+00	226.2	214.18	12.0		6+22.8 TAP		24227		2530 FOX RUN	2528 FOX RUN	11-02-87	
	227.23	214.99	12.2	6+70.8	4" stub NW		19837				12/03/87	
0+00	226.19	214.90	11.3	5+80.2 L-4 0+00								
	225.81	215.43	10.4	0+94.8	0+89.8 TAP	4" stub S	22921	20514	2506 FOX RUN	2524 FOX RUN	4-14-87	4-19-88
0+00	206.25	195.34	10.9	EXIST 0+00								
1+00	207.8	197.27	10.5			1+25.0 TAP		21302		2548 FOX RUN		8-17-88
	210.03	198.89 OUT 199.48 IN	11.5	1+81.0								
2+00	209.8	199.91	9.9									
	211.53	201.78 OUT 201.90 IN	9.8	2+81.6								
3+00	211.3	202.17	9.1		3+40.1 TAP		24259		2550 FOX RUN		11-08-89	
	212.42	203.01 OUT 203.17 IN	9.4	3+58.1	3+74.6 TAP		24934		2552 FOX RUN		6-23-88	
4+00	212.9	204.10	8.8									
					4+58.1 TAP		24639		2554 FOX RUN		10-5-89	
5+00	215.6	206.31	9.3									