


MAIN 15, SW1 (Phase II)
 468-76-245-81618-000-000-001
 Built By Stamer Const.
 Booked 7-27-88 from TCD-60

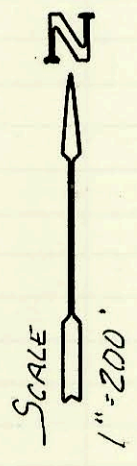

See agreement
 over sewer for
 Wall K-270

See City Eng's
 office about
 MH EXT

83+02.0 MH Tp 'P'
 0+00 Line 2

78+24.2 MH Tp 'P'
 4\" stub
 MH SW N by app
 15'

74+09.5 MH Tp 'P' S' Dia.
 0+00 Line 3
 72+98.7 MH Exist.

100' ARKLA
 PIPELINE EASEMENT

21st St. No.

RIDGE ROAD

20' San. Sew. Esm't

20' San. Sew. Esm't

21\"/>

15\"/>

15\"/>

LINE 1

15\"/>

21\"/>

LINE 3

21\"/>

LINE 2

12\"/>

12\"/>

12\"/>

12\"/>

12\"/>

12\"/>

12\"/>

12\"/>

12\"/>

12\"/>

12\"/>

CONSTRUCTION RECORD						SERVICE RECORD						
STATION	ELEVATION		Depth	MANHOLE	4-INCH "Y" BRANCHES		No. of Permit		House Number		DATE OF PERMITS	
	Ground	Grade			North West	South East	North West	South East	North West	South East	North West	South East
5, SW 1 (PHASE II)												
72+	143.59	126.23	17.4	EXIST 72+92.7								
73+00	143.2	126.23	17.0									
74+00	142.7	126.24	16.5									
	143.87	126.24 OUT 126.27 IN	17.6	0+00 L-3 74+69.5								
75+00	143.1	126.31	16.8									
76+00	143.1	126.46	16.6									
77+00	141.8	126.60	15.2									
78+00	141.0	126.74	14.3									
	141.88	126.78 OUT 126.88 IN	14.3	78+24.6	4" stub SW		25425		7236 W 21st N/S		5-29-90	
79+00	140.5	126.96	13.5									
80+00	140.2	127.06	13.1									
81+00	140.2	127.16	13.0									
82+00	141.2	127.27	13.9									
83+00												
	141.46	127.37 OUT 127.80 IN	14.1	0+00 L-2 83+02.0								
84+00	140.3	127.92	12.4									
85+00	140.5	128.05	12.5									
86+00	140.5	128.17	12.3									
87+00	140.4	128.30	12.1									
	140.56	128.33	12.2	87+24.2								
88+00	139.9	128.44	11.5									
89+00	140.0	128.59	11.4									
90+00	139.8	128.74	11.1									
91+00	140.1	128.89	11.2									
92+00	140.5	129.04	11.5									
93+00	140.7	129.19	11.5									
	140.99	129.23	11.8	93+24.2								
94+00	140.3	129.36	10.9									
95+00	139.4	129.52	9.9									
96+00	139.8	129.69	10.1									
97+00	140.5	129.85	10.7									
	140.19	129.96	10.2	97+44.7								
98+00	139.2	130.01	9.2									
99+00	137.2	130.17	7.0									
100+00	137.0	130.32	6.7									
101+00	136.7	130.47	6.2									
102+00	136.2	130.62	5.6									
103+00	136.7	130.77	5.9									
	138.04	130.87	7.2	103+63.8 83+02.0 L-1 0+00								
0+00	141.46	127.58	13.9									
1+00	140.5	127.81	12.7									
2+00	140.5	128.04	12.5									
3+00	141.7	128.27	13.4									
4+00	141.6	128.50	13.1									
5+00	141.5	128.73	12.8									
	141.03	128.80 OUT 128.87 IN	12.2	5+32.1								
6+00	141.5	129.01	12.5									
7+00	141.5	129.22	12.3									
	141.22	129.42 OUT 129.51 IN	11.8	7+98.6				9815904-7	7390 W 21st		2/26/91	
8+00												
9+00	141.5	129.80	11.7									
	141.98	129.98 OUT 130.12 IN	12.0	9+62.1	8" stub E 8" stub S							
10+00	141.9	130.22	11.7									
11+00	141.6	130.49	11.1									
12+00	142.0	130.76	11.2									
	142.56	130.83	11.7	12+27.3	8" stub W 12" stub W	8" stub S						
0+00	143.87	127.18	16.7	0+00								
1+00	142.4	127.47	14.9									
2+00	142.5	127.76	14.7									
	143.00	127.86 OUT 127.94 IN	15.1	2+34.6	8" stub W							
3+00	142.5	128.09	14.4									
	143											
4+00	143.0	128.32	14.7									
5+00	143.5	128.54	15.0									
6+00	144.5	128.77	15.7									
7+00	144.6	129.00	15.6									
	145.16	129.11	16.1	7+49.6	8" stub W	4" stub NE 4" stub SE	9811377 2379	2378	2111 15th 2105 N Ridge	2-898 4-21-92	4-21-92	

MAIN
Line 1

LINE 2

LINE 3

in county
at
connection

Form #192-020 (July, 1981)
 2301 N Ridge Rd - fee in lieu of lat assess paid
 5-4-89 in amt of \$200⁰⁰
 9810346-7 6-15-98 2121 N Ridge Rd - Braun's - Lubbers
 98-23558-7 12-2-98 2105 N Ridge Rd - Dental office