K-290A

Cowskin Interceptor Sewer
468-76-245-81838-000-000-001
Built By Utility Contr.
Booked 1-1-89 from JLA #27

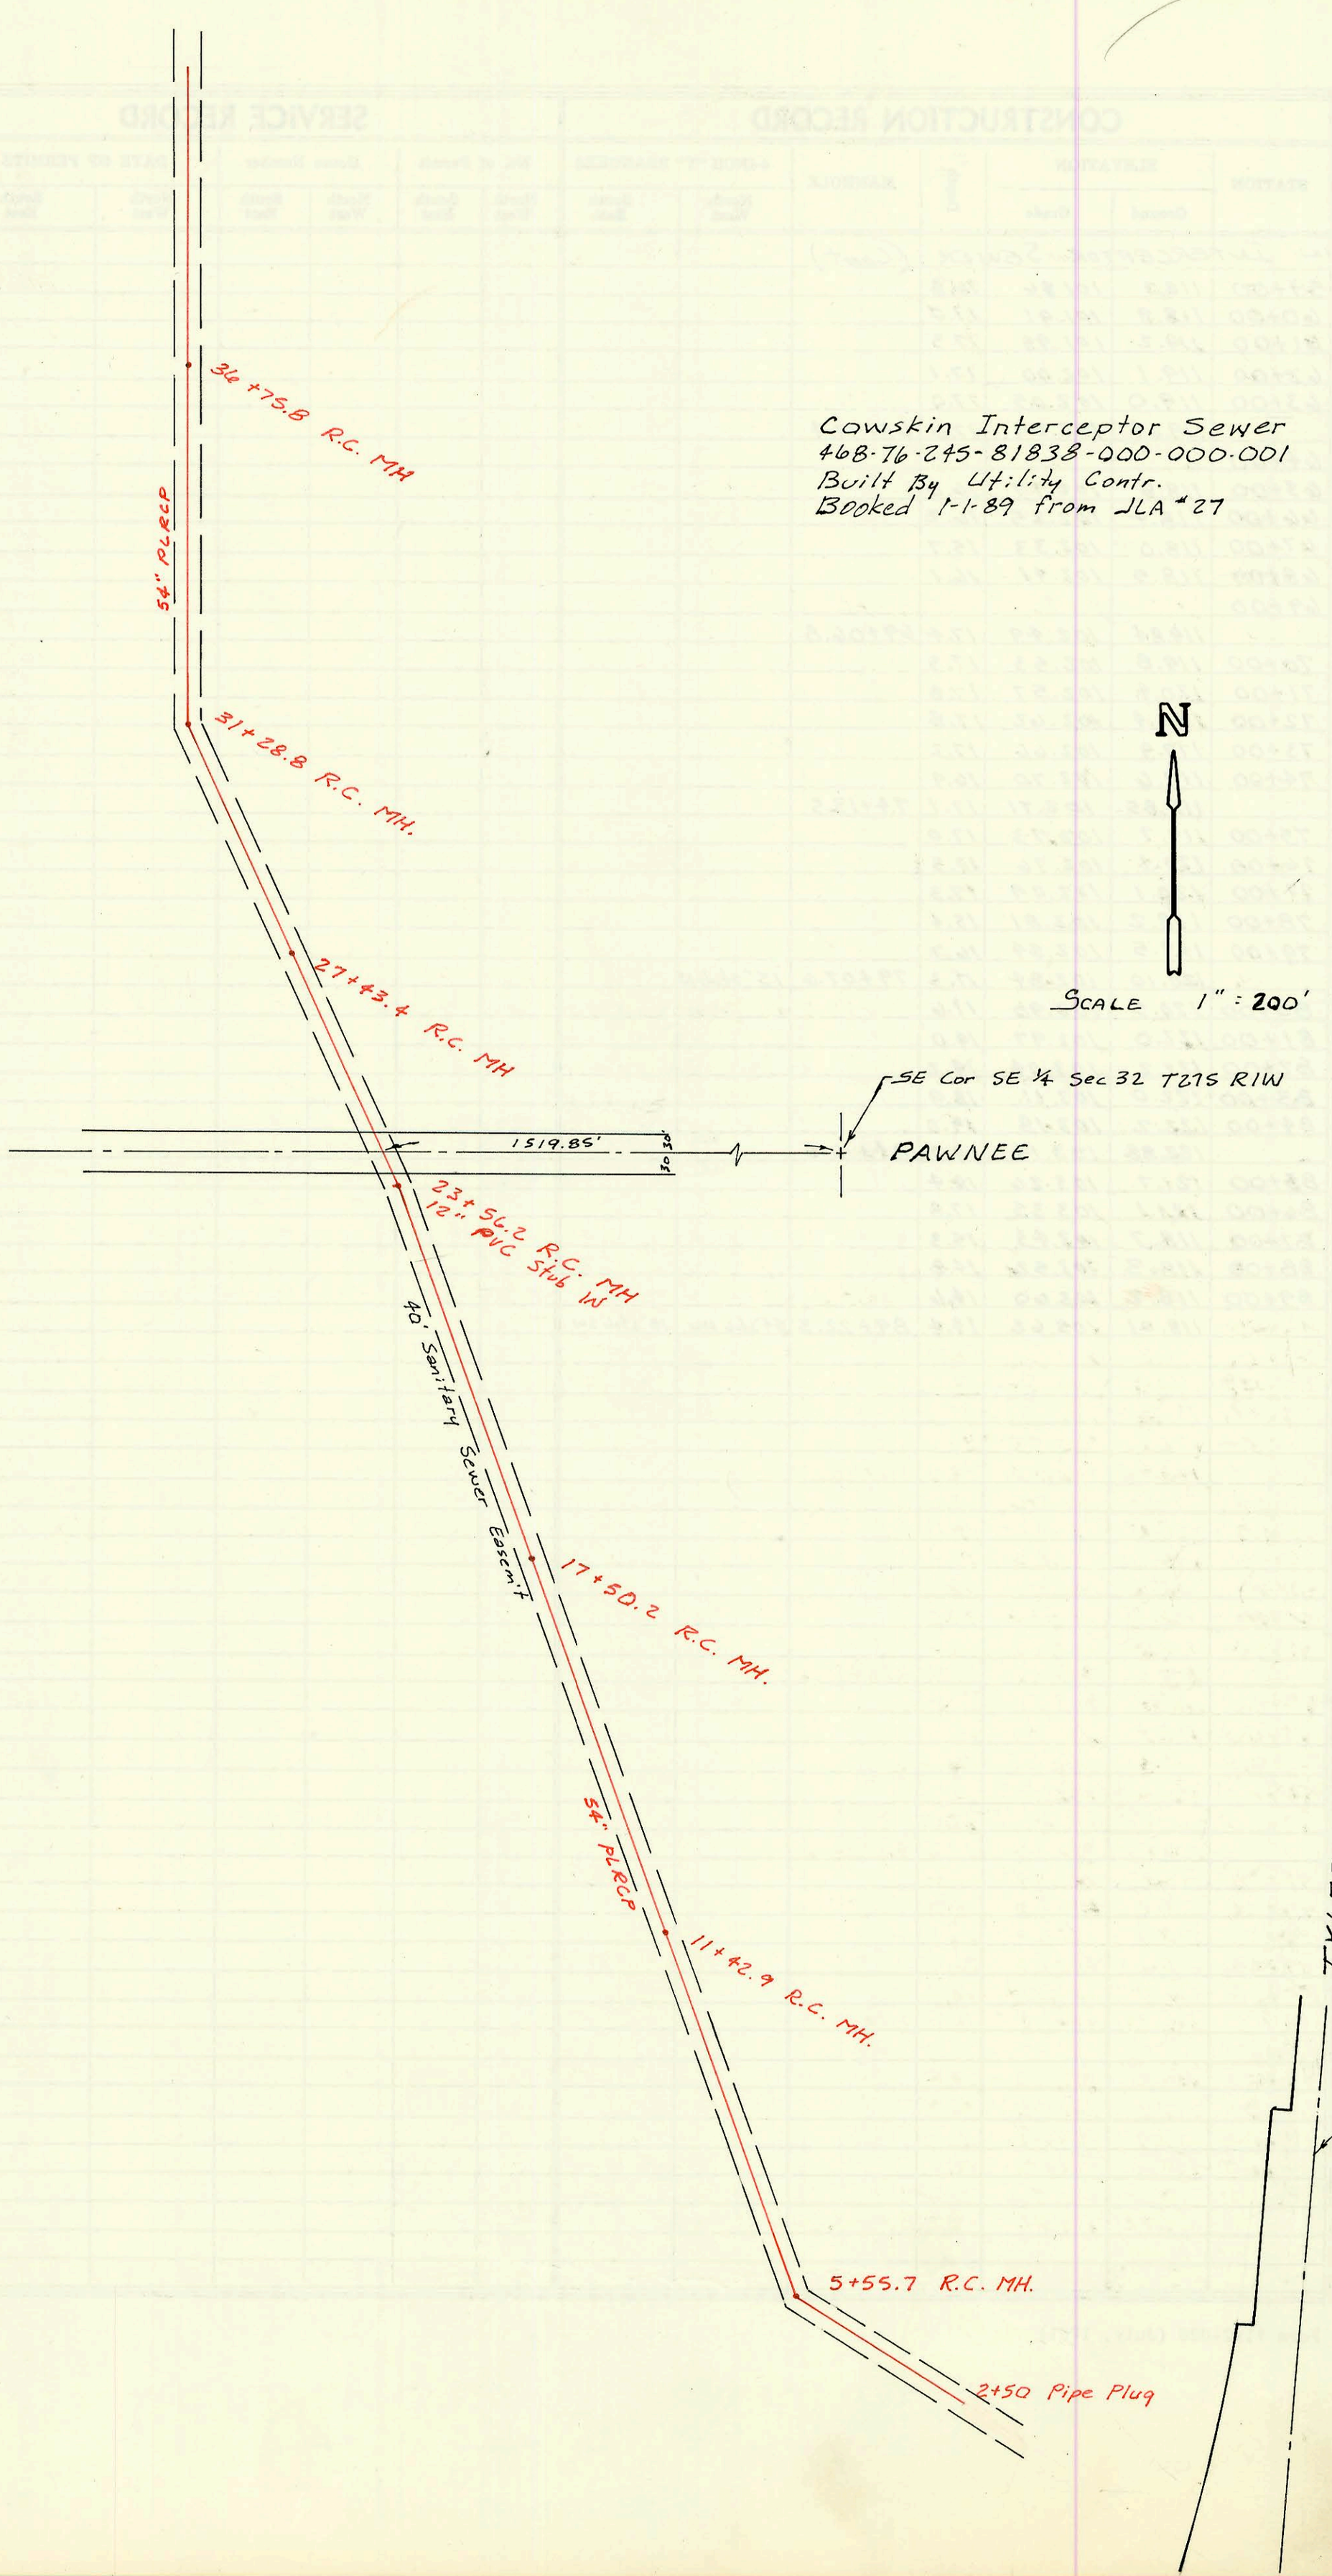

K-290

CONSTRUCTION RECORD							SERVICE RECORD					
STATION	ELEVATION		Depth	MANHOLE	4-INCH "Y" BRANCHES		No. of Permit		House Number		DATE OF PERMITS	
	Ground	Grade			North West	South East	North West	South East	North West	South East	North West	South East
Cowskin Interceptor Sewer												
2+50	114.8	99.08	15.7									
3+00	114.6	99.10	15.5									
4+00	114.7	99.13	15.6									
5+00	115.4	99.16	16.4									
	115.03	99.18	15.9	5+55.7								
6+00	115.3	99.21	16.1									
7+00	115.3	99.27	16.0									
8+00	114.4	99.33	15.1									
9+00	114.2	99.39	14.8									
10+00	114.5	99.44	15.1									
11+00	113.9	99.50	14.4									
	114.28	99.53	14.8	11+42.9								
12+00	114.0	99.57	14.4									
13+00	114.2	99.63	14.6									
14+00	114.2	99.70	14.5									
15+00	115.0	99.77	15.2									
16+00	115.4	99.83	15.6									
17+00	116.0	99.90	16.1									
	116.83	99.93	16.9	17+50.2								
18+00	116.7	99.96	16.7									
19+00	116.8	100.01	16.8									
20+00	116.9	100.07	16.8									
21+00	117.1	100.13	17.0									
22+00	117.8	100.18	17.6									
23+00	118.4	100.24	18.2									
	119.82	100.27	19.6	23+56.2	12" stub W							
24+00	120.5	100.30	20.2									
25+00	118.9	100.36	18.5									
26+00	118.5	100.41	18.1									
27+00	118.5	100.47	18.0									
	118.26	100.50	17.8	27+43.4								
28+00	118.6	100.52	18.1									
29+00	117.5	100.55	17.0									
30+00	117.5	100.58	16.9									
31+00	117.5	100.61	16.9									
	118.02	100.62	17.4	31+28.8								
32+00	118.5	100.66	17.8									
33+00	119.0	100.72	18.3									
34+00	120.5	100.78	19.7									
35+00	121.0	100.84	20.2									
36+00	121.1	100.90	20.2									
	120.86	100.94	19.9	36+75.8								
37+00	120.5	100.95	19.6									
38+00	119.0	101.00	18.0									
39+00	118.5	101.05	17.5									
40+00	118.3	101.09	17.2									
41+00	118.1	101.14	17.0									
42+00	118.0	101.19	16.8									
	118.5	101.21	17.3	42+43.0								
43+00	118.0	101.24	16.8									
44+00	117.8	101.29	16.5									
45+00	117.8	101.35	16.5									
46+00	118.5	101.40	17.1									
47+00	118.4	101.45	17.0									
	118.73	101.50	17.2	47+86.4								
48+00	118.1	101.51	16.6									
49+00	118.0	101.55	16.5									
50+00	118.1	101.59	16.5									
51+00	118.1	101.63	16.5									
52+00	116.2	101.67	14.5									
	116.31	101.71	14.6	52+98.7								
53+00												
54+00	116.5	101.73	14.8									
55+00	117.1	101.76	15.3									
56+00	117.9	101.78	16.1									
57+00	118.6	101.81	16.8									
58+00	118.6	101.83	16.8									
	119.13	101.84	17.3	58+45.7								
CONT ON K-291												

Form #192-020 (July, 1981)