



Plot 5-43

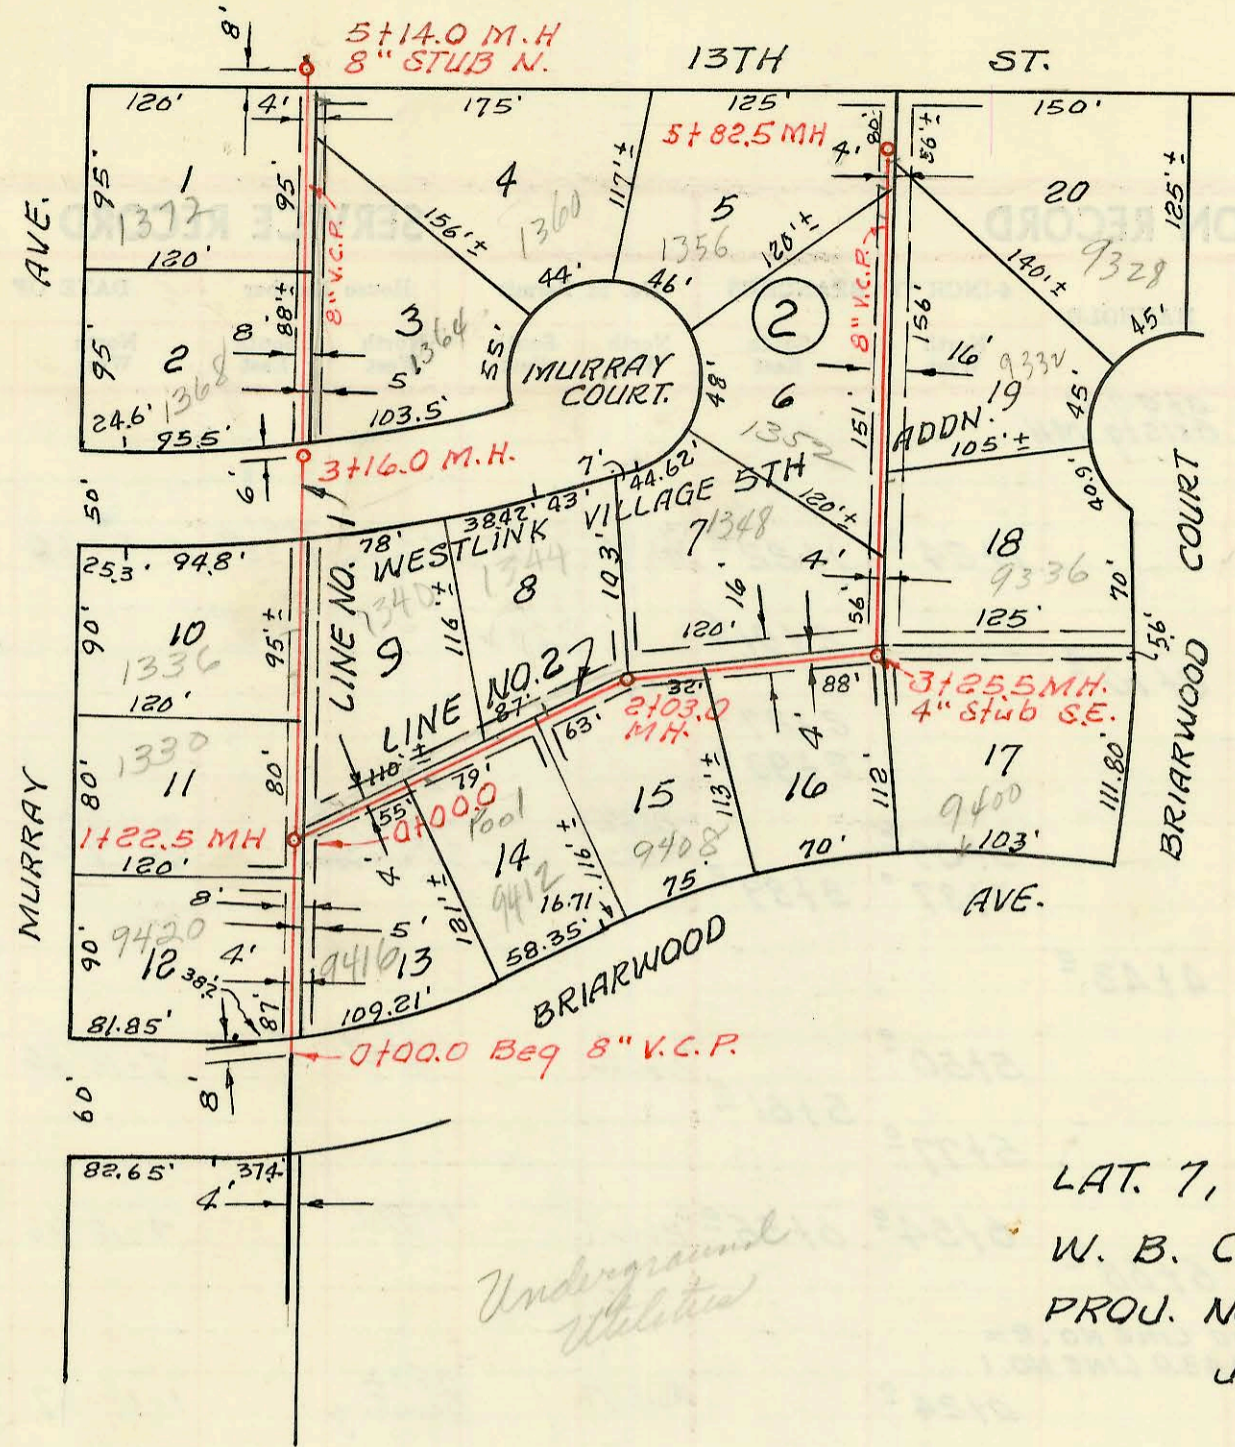

LAT. 7, WESTLINK SEWER
 W. B. CARTER CONST. CO. INC.
 PROJ. NO. C24-25, BK K-83
 JUNE 1, 1966

Underground Utilities

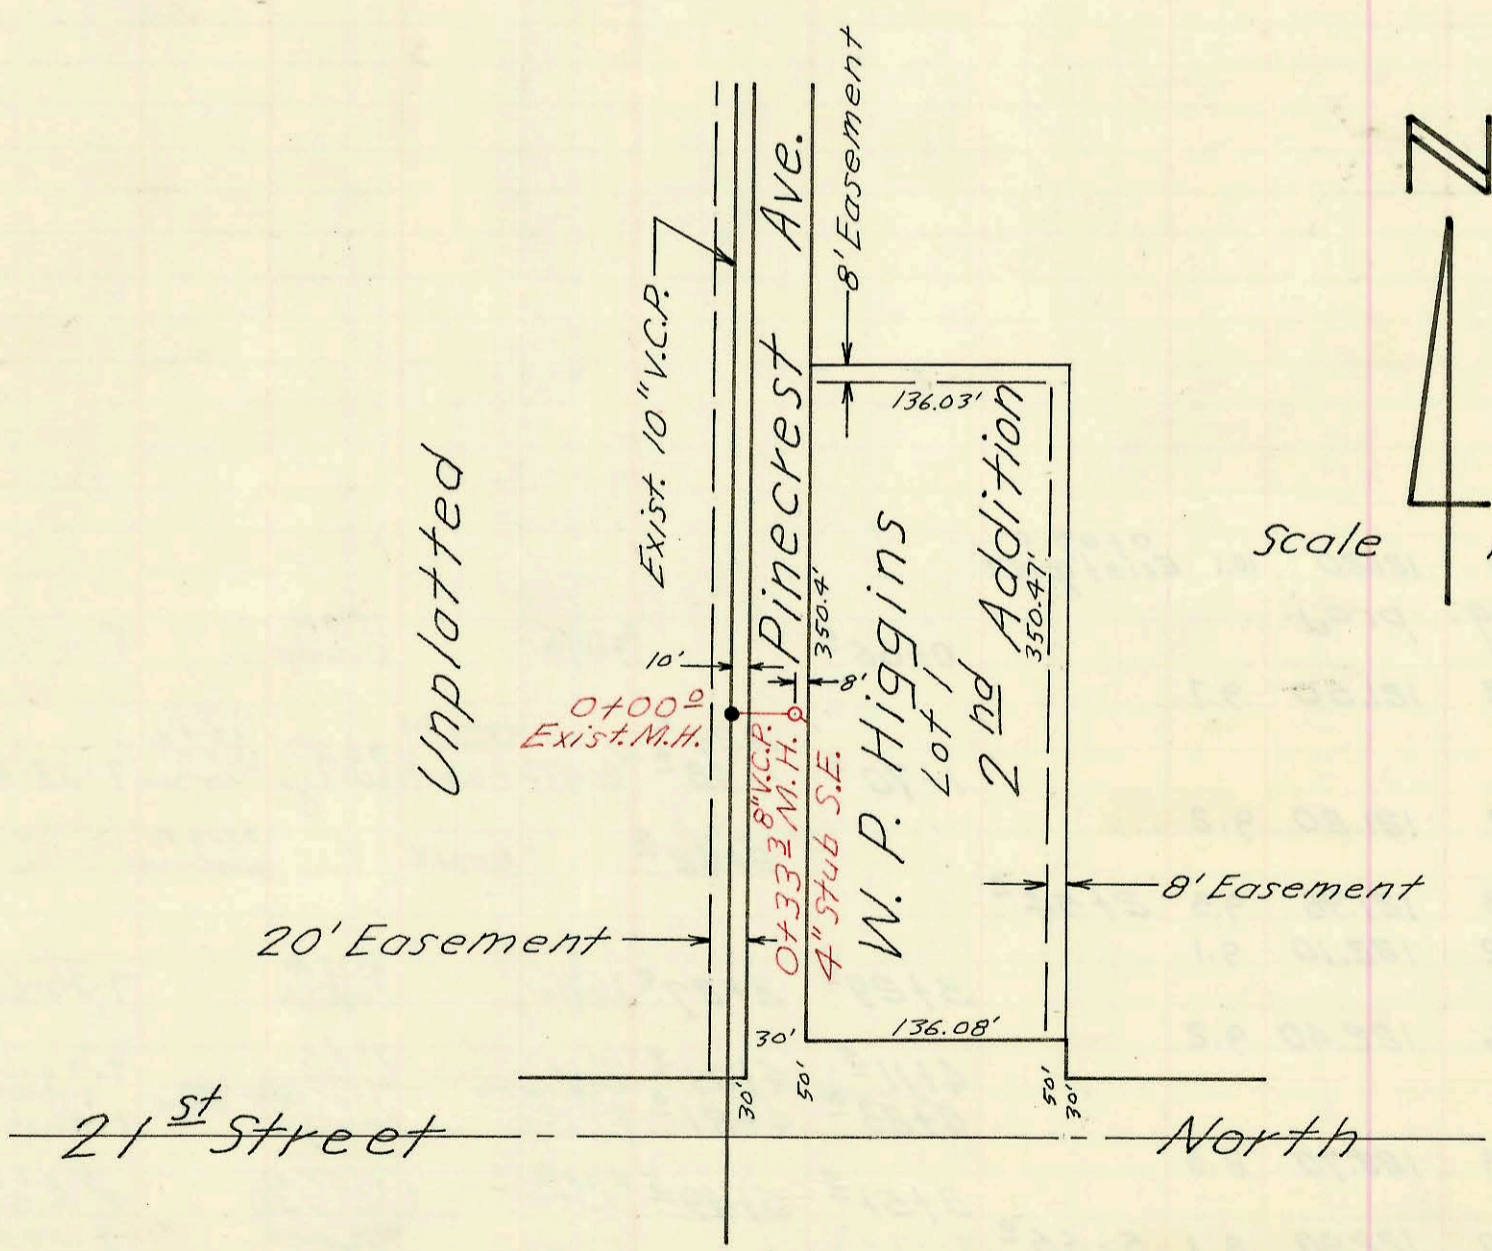

Lot 24, Sub. 5, S.S. No. 23
 Mid-States Const. Co., Inc. Feb. 1968
 Proj. No. C 27-55 Bk. K-89 Booked 3-18-68

CONSTRUCTION RECORD

SERVICE RECORD

LINE NO. 1

LINE NO. 2

STATION	ELEVATION		Depth	MANHOLE	4-INCH "Y" BRANCHES		No. of Permit		House Number		DATE OF PERMITS	
	Ground	Grade			North West	South East	North West	South East	North West	South East	North West	South East
0+00	153.2	143.72	9.5	Bag. 8" V.C.P.	0+26 ⁵		#C971		9420 Briarwood		11-8-66	
1+00	153.0	143.92	9.1		0+58 ⁶		C3148		9416 Briarwood		5-18-67	
	153.3	143.96 out 144.06 in	9.3 9.2	1+22 ⁵	1+13 ⁰		B6185		1330 N. Murray Ave.		8-16-66	
					1+90 ⁰		B6215		1376 N. Murray		8-22-66	
2+00	153.8	144.12	9.7		3+43 ⁰	3+41 ⁰	#C1528		1368 N. Murray		1-12-67	
3+00	154.9	144.32	10.6		4+25 ⁵	4+20 ⁰	C7397		1364 Murray Ct		3-20-68	
4+00	155.2	144.52	10.7	3+16 ⁰	4+25 ⁵	4+97 ⁵	C3510		1372 Murray		6-13-67	8-28-63
							C3760		1360 Murray Ct		5-18-67	
5+00	155.0	144.72	10.3		5+14 ⁰	8" stub N.						
	155.0	144.74	10.3									
0+00	153.3	144.06	9.2	0+00.0 Line #2 = 1+22.5 Line #1	0+19 ⁰	0+21 ⁰ 0+78 ⁰	#C1461	14716 C1662	1340 MURRAY CT	9412 W.B. Briarwood	1-6-66	10-29-65 10-24-67
1+00	154.8	144.76	10.0		1+29 ⁵ 1+58 ⁴	1+56 ⁵ 1+91 ⁰	C2420		1344 Murray Ct	9408 Briarwood	3-28-67	3-1-67
2+00	156.5	145.48	11.0	2+03 ⁰	2+67 ⁰	2+50 ⁰	#C2727	B5794	1348 N. Murray Ct	9404 Briarwood	6-9-66	4-12-67
3+00	156.8	144.16	12.6		3+25 ⁵	4" stub S.E.	#C2008		9400 Briarwood		2-23-67	
	156.6	146.33 out 146.39 in	10.2		3+49 ⁰		#C3959		9336 Briarwood Ct		7-17-67	
4+00	156.5	146.96	9.5		4+05 ⁵	4+22 ⁵	C2068		1352 Murray Ct		3-1-67	
5+00	156.4	147.66	8.7		5+53 ⁰	4+76 ⁶	C4120	(1661)	1356 Murray Ct	9332 Briarwood Ct	1/24/67	7-27-67
	156.5	148.16	8.3	5+82 ⁵	5+75 ⁰		#C2919		9328 Briarwood Ct		5-1-67	
Lot. 24, Sub. 5, S.S. No. 23												
0+00	218.9	209.86	9.0	0+00 ⁰ Exist. M.H.	0+33 ³	4" stub S.E.	C6806		5222 F. 2722		2-8-68	