



20A

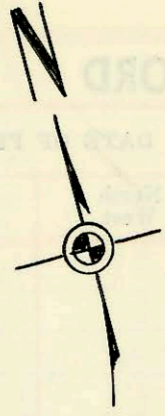

1" = 100'

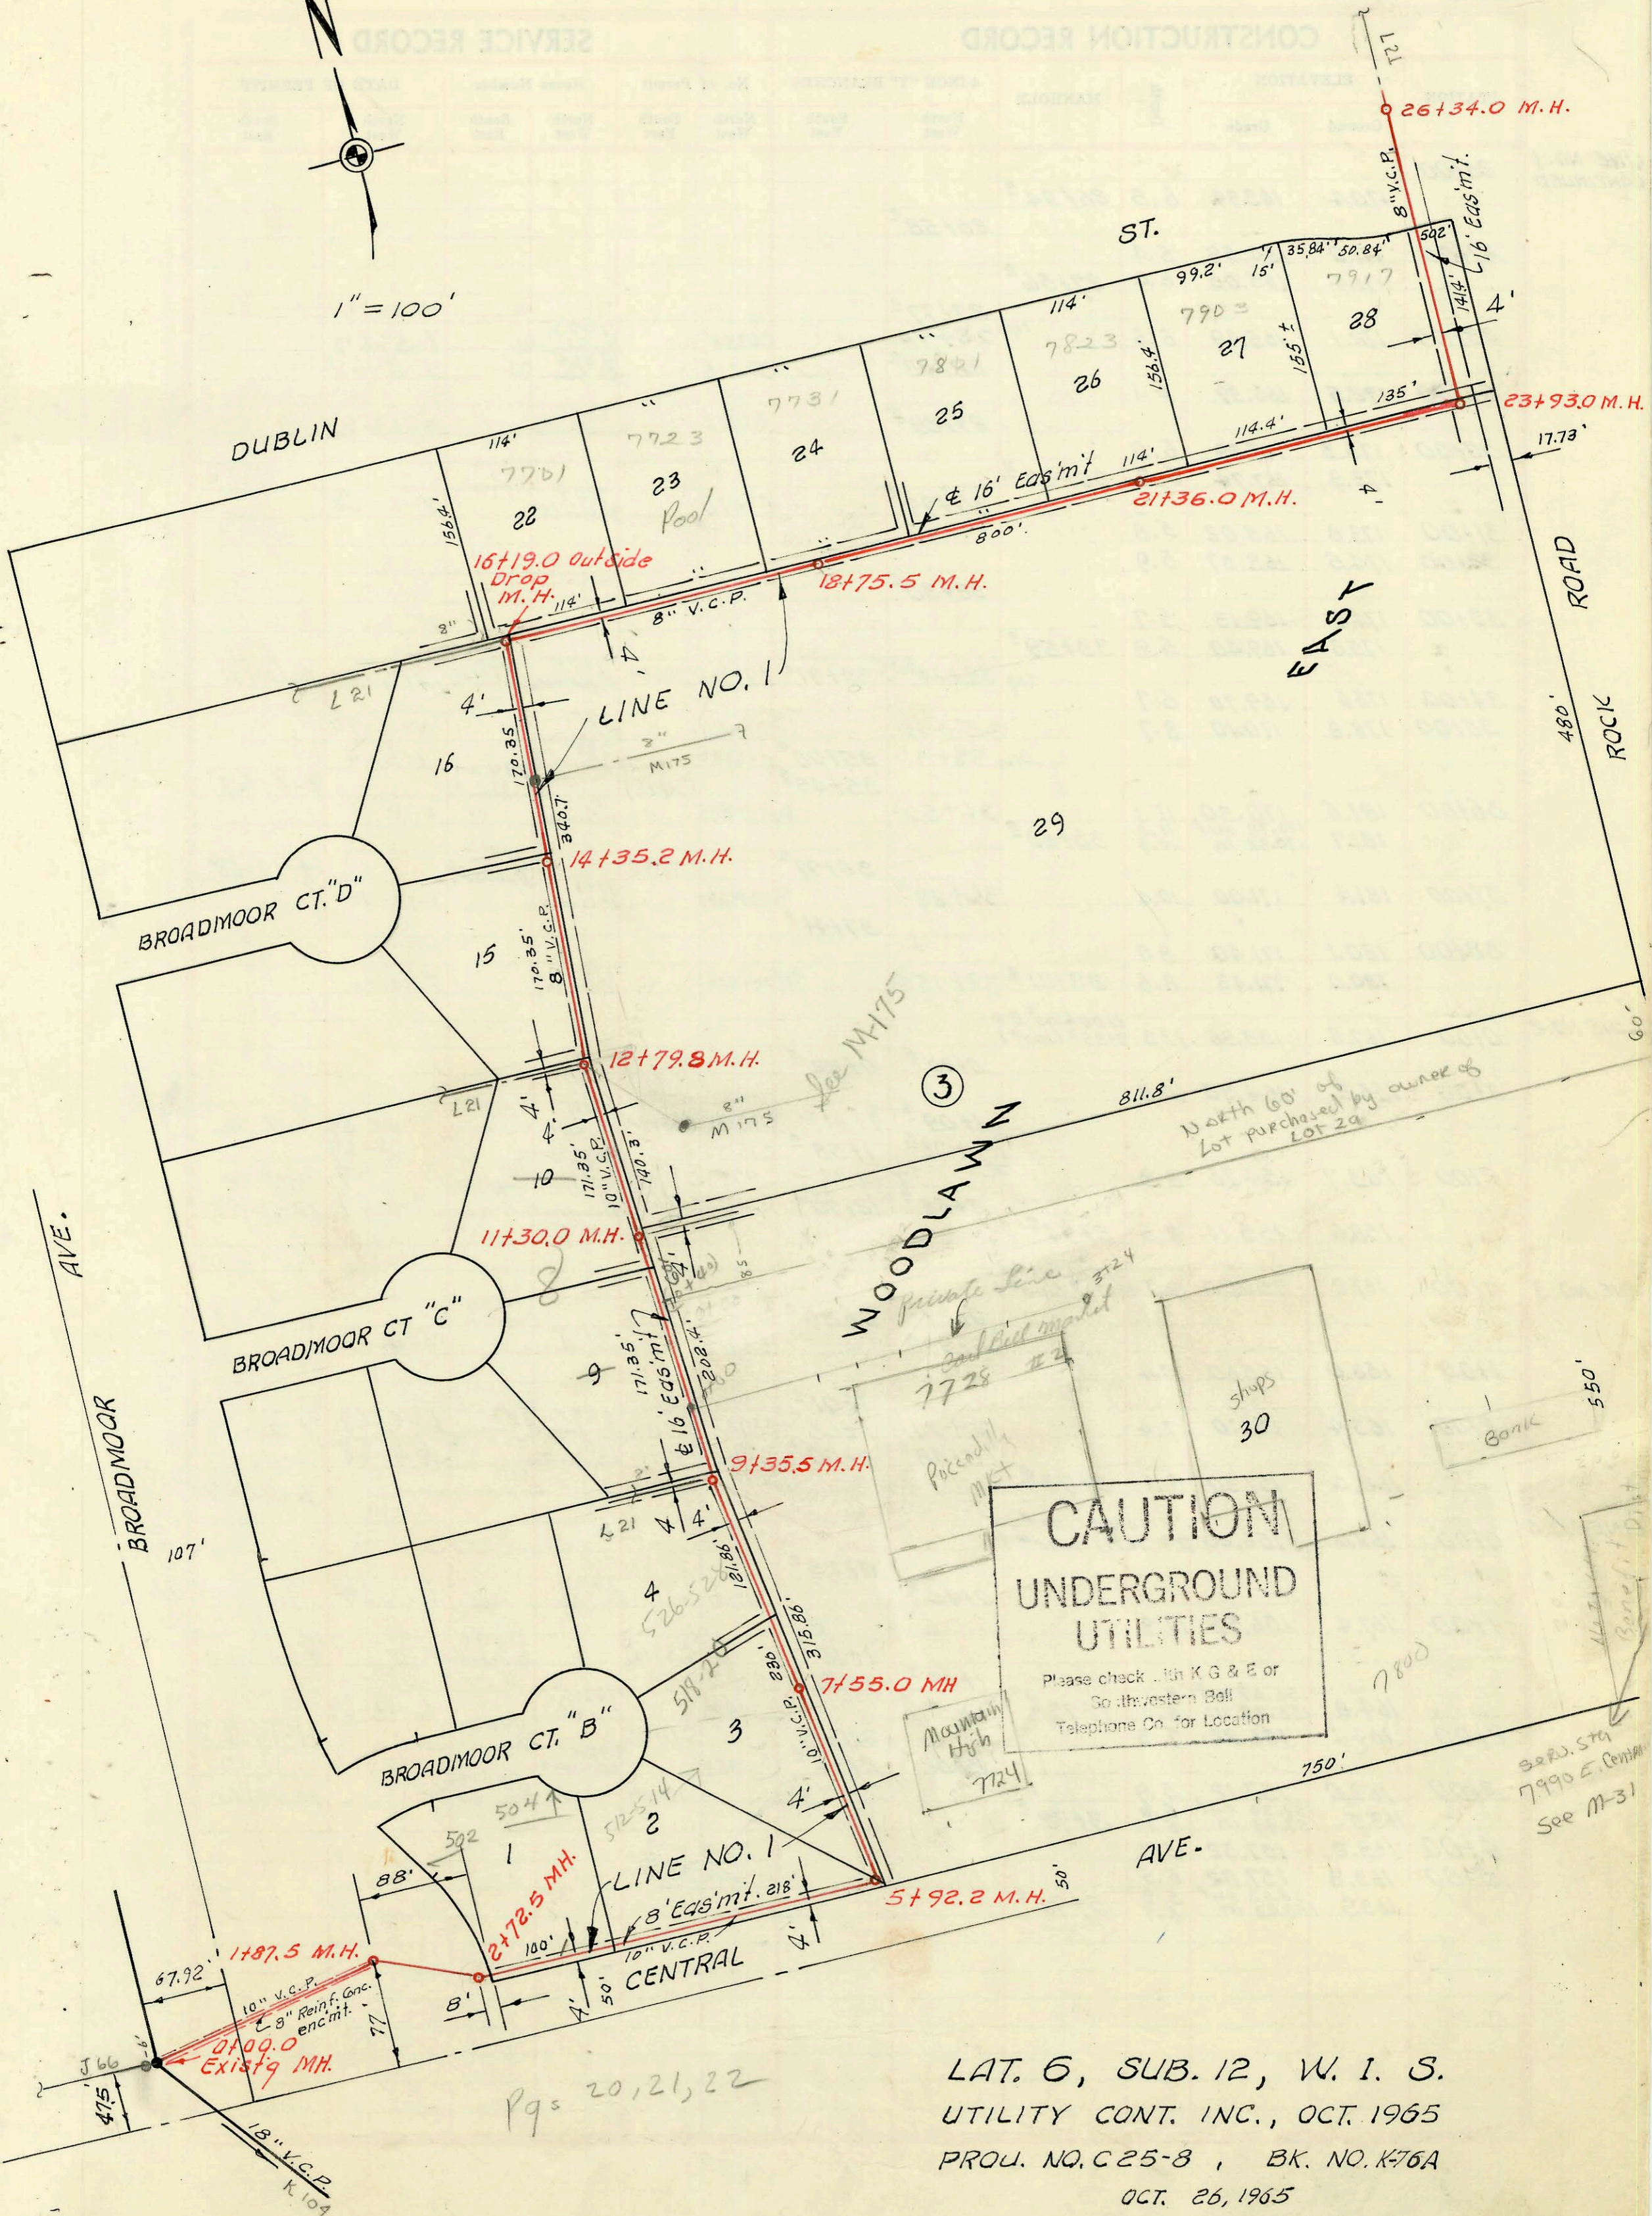

Pgs 20, 21, 22

LAT. 6, SUB. 12, W. I. S.
 UTILITY CONT. INC., OCT. 1965
 PROJ. NO. C25-8, BK. NO. K76A
 OCT. 26, 1965

