


SERVICE RECORD

CONSTRUCTION RECORD

LINE NO. 2
 Part of Lot 119, Main 4, SS #23
 468-76-245-81404-000-000-001
 Built By Stannard Const.
 Booked 12-2-85 from AG 14A

E.E. VIET SAN SEWER
 PROJ. NO. 468-76-245-80660-000-000-008
 BOOKED 2-16-79 FROM 1492

Permit # C5167 - 3050 N. St. Francis Proj. No. 10-6-67 (4' x 6' E) 0445 MH
 Permit # C5168 - 3050 N. St. Francis Proj. No. 10-6-67 (4' x 6' S.E.) 0445 MH

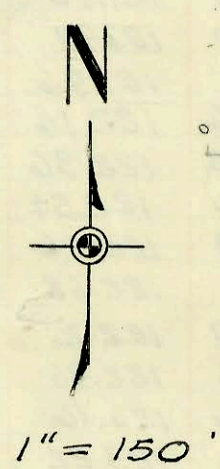

SUB. 4, S. S. NO. 23

0+00.0 LINE # 2 =
 79+48.0 LINE # 1.
 Pg. 28

CONSTRUCTION RECORD

SERVICE RECORD

STATION	ELEVATION		Depth	MANHOLE	4-INCH "Y" BRANCHES		No. of Permit		House Number		DATE OF PERMITS	
	Ground	Grade			North West	South East	North West	South East	North West	South East	North West	South East
0+00	127.9	116.05	11.8	0+00 = 79+48 ² Line No. 1								
1+00	126.7	116.13	10.6									
2+00	127.0	116.21	10.8									
3+00	127.0	116.29	10.7									
	127.1	116.31	10.8	3+30 ²								
4+00	127.4	116.37	11.0									
5+00	127.3	116.45	10.8									
6+00	128.8	116.53	12.3									
	127.6	116.57	11.0	6+58 ⁵								
7+00	127.4	116.61	10.8									
8+00	127.3	116.69	10.6									
9+00	128.3	116.77	11.5									
10+00	128.2	116.85	11.3									
	128.2	116.86	11.3	10+08 ²								
11+00	126.7	116.93	9.8									
	126.7	116.98	9.7	11+66 ²								
12+00	127.0	117.01	10.0									
13+00	127.0	117.09	9.9									
14+00	127.0	117.17	9.8									
	127.3	117.25	10.0	14+97 ⁵								
15+00												
16+00	127.8	117.33	10.5									
17+00	128.6	117.41	11.2									
18+00	129.5	117.49	12.0									
	129.7	117.52	12.2	18+37 ²								
19+00	129.5	117.57	11.9									
20+00	129.4	117.65	11.7									
21+00	133.2	117.73	15.5									
	132.3	117.79	14.5	21+65 ⁵								
22+00	132.3	117.81	14.5									
23+00	132.0	117.86	14.1									
24+00	132.1	117.90	14.2									
25+00	132.0	117.95	14.0									
	132.0	117.96	14.0	25+16 ⁵								
26+00	131.3	117.99	13.3									
27+00	129.7	118.03	11.7									
28+00	129.0	118.09	10.9									
	131.5	118.13	13.4	28+61 ¹								
29+00	131.3	118.16	13.1									
30+00	132.5	118.22	14.3									
31+00	132.9	118.28	14.6									
32+00	132.8	118.34	14.5									
	132.8	118.39	14.4	32+76 ⁵				C64593	504 E. 33rd. 7th		11-29-78	
33+00	132.0	118.40	13.6									
34+00	131.6	118.46	13.1									
35+00	130.0	118.52	11.5									
	130.0	118.58	11.4	35+94 ⁷				4" SCH 40 36+43.7 W	99-1674- 7	101 E 34th ST N		2-11-99
36+00												
37+00	130.2	118.64	11.6									
38+00	130.3	118.70	11.6									
	130.5	118.77	11.7	38+90 ²	8" stub W. 120.28	8" stub E. 120.28						
39+00												
40+00	130.4	118.83	11.6									
41+00	130.6	118.89	11.7									
	130.7	118.94	11.8	41+72 ⁵								
42+00	130.7	118.95	11.8									
43+00	131.0	119.00	12.0									
44+00	131.2	119.06	12.1									
	131.2	119.09	12.1	44+42 ²								
45+00	131.1	119.13	12.0									
46+00	131.1	119.19	11.9									
47+00	131.1	119.25	11.8									
	131.1	119.27	11.8	47+18 ²	8" stub W. 120.78							
48+00	131.2	119.31	11.9									
49+00	131.3	119.37	11.9									
	131.5	119.42	12.1	49+73 ²								
50+00	131.7	119.43	12.3									
51+00	132.2	119.49	12.7									
52+00	132.5	119.55	13.0									
	132.3	119.58	12.7	52+41 ²								
53+00	132.1	119.61	12.5									
54+00	132.3	119.67	12.6									
55+00	132.5	119.73	12.8									
	132.5	119.79	12.7	55+92 ²								
56+00												
57+00	132.7	119.85	12.8									
58+00	132.8	119.90	12.9									
59+00	133.2	119.96	13.0									
	133.2	119.98	13.0	59+22 ⁷								

LINE NO. 2

12-125
10-15.5

L