


No large or
stub set for
lot 16
J.W.

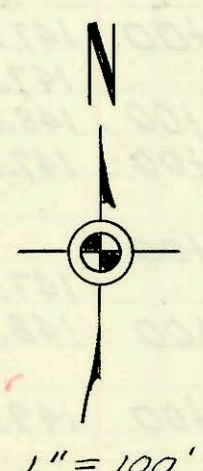

LAT. 2, SUB. 21, S. S. NO. 22
 MID - STATES CONST. CO. INC.
 PROJ. NO. C25-22, BK. NO. K-84
 JUNE 3, 1966

