58A

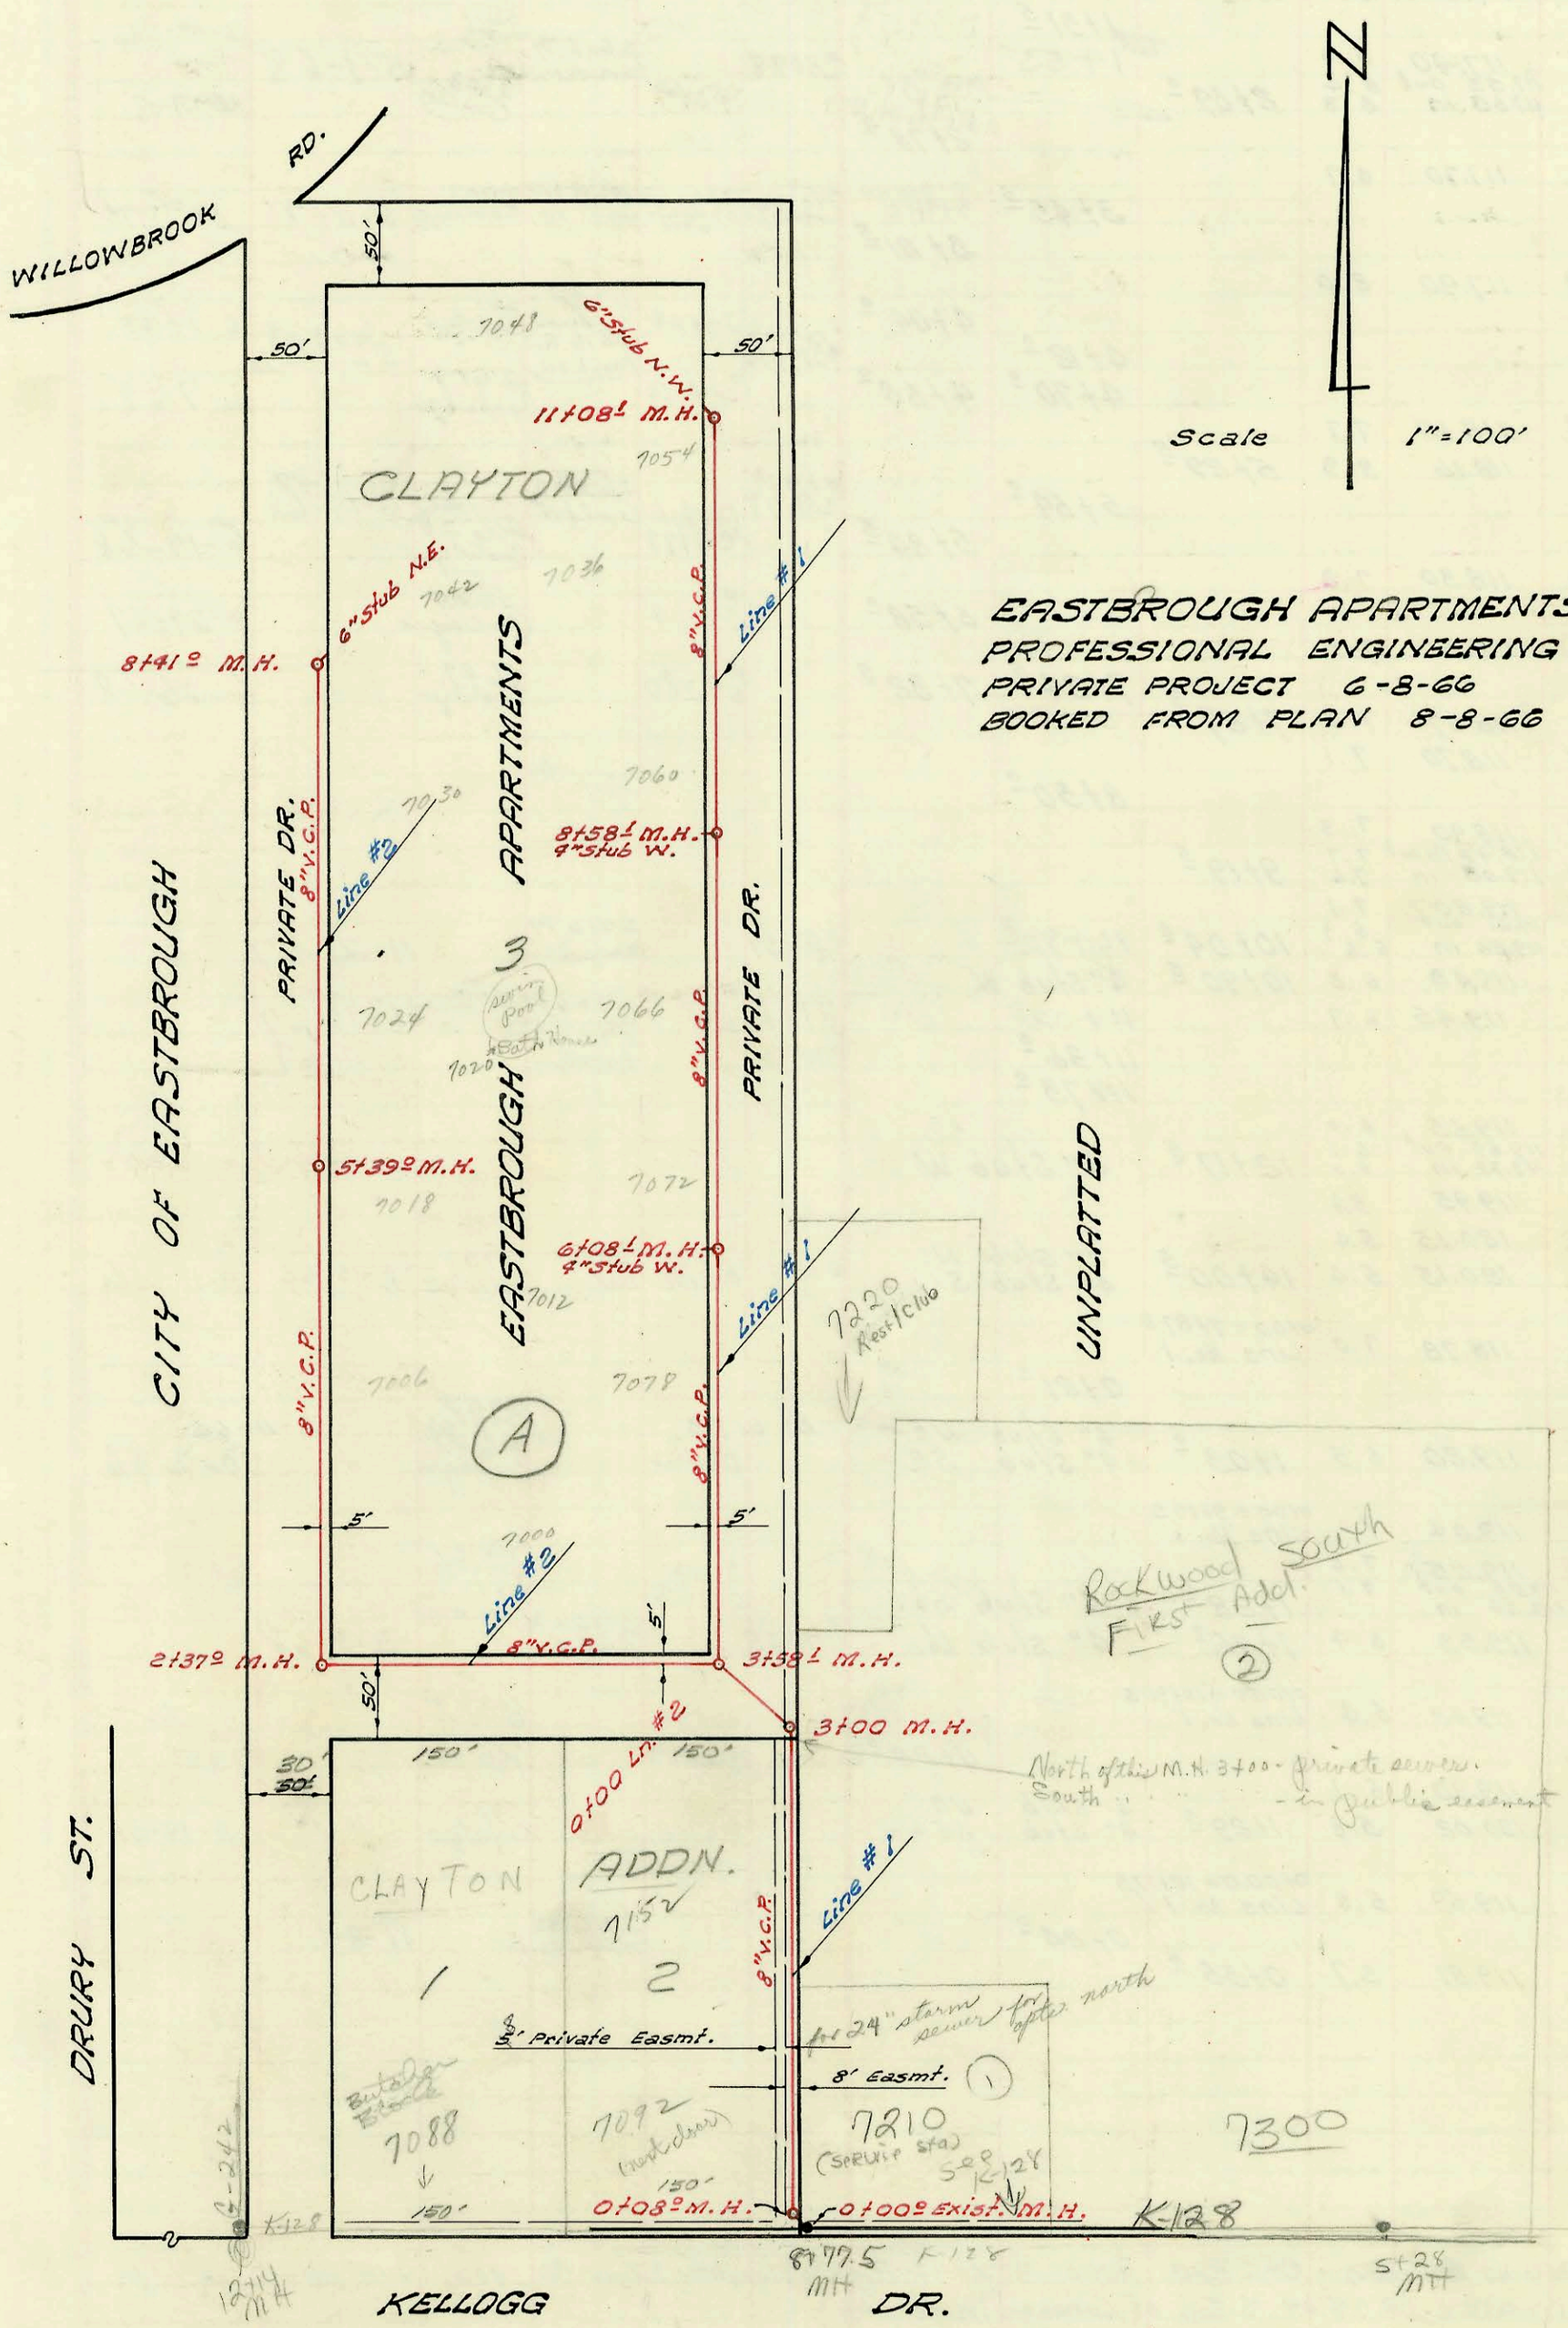
N
Scale 1"=100'
EASTBROUGH APARTMENTS S.S.
PROFESSIONAL ENGINEERING CONSULTANTS
PRIVATE PROJECT 6-8-66
BOOKED FROM PLAN 8-8-66
WILLOWBROOK RD.
CITY OF EASTBROUGH
EASTBROUGH APARTMENTS
PRIVATE DR.
PRIVATE DR.
UNPLATTED
CLAYTON
CLAYTON ADDN.
DRURY ST.
KELLOGG DR.
6"Stub N.W.
11+08± M.H.
6"Stub N.E.
8+41± M.H.
8+58± M.H.
9"Stub W.
5+39± M.H.
6+08± M.H.
4"Stub W.
2+37± M.H.
3+58± M.H.
3+00 M.H.
0+00 Ln. #2
0+08± M.H.
0+00± Exist. M.H.
8"V.C.P.
Line #1
Line #2
50'
150'
5'
8' Easmt.
5' Private Easmt.
Rockwood South First Add.
North of this M.H. 3+00 - private sewer.
South " " - in public easement
for 24" storm sewer later north
7220 Rest/Club
7210 (Sprucup Sta)
7300
7088
7092 (not down)
K-128
A
1
2
3

58

Form 42-020

	CONSTRUCTION RECORD							SERVICE RECORD					
	STATION	ELEVATION		Depth	MANHOLE	4-INCH "Y" BRANCHES		No. of Permit		House Number		DATE OF PERMITS	
		Ground	Grade			North West	South East	North West	South East	North West	South East	North West	South East
Line #1	0+00	162.5	155.24	7.3	Exist. 0+00 0+08°								
	1+00	163.6	155.80	7.8					2003-68870				4-2-03
	2+00	164.5	156.36	8.1			TAP 2+57.4		C60841		7152 E. Kellogg 10		4-25-17
	3+00	165.4	out 156.92 in 156.96	8.5	3+00		2+94.0 TAP		2003-68869 1817 S		7152 E Kellogg 20		4-2-03 7-28-87
		165.4	out 157.20 in 157.24	8.2	3+58¹								
	4+00	166.4	157.40	9.0		5+05.1 W.		B6114		7078 E Kellogg		8-1-66	
	5+00	166.8	157.80	9.0		5+11⁴							
	6+00	167.4	158.20	9.2		5+83°		#B6103		7012 E Kellogg		8-1-66	
		167.4	out 158.24 in 158.28	9.2	6+08¹	4" Stub W.							
	7+00	168.0	158.64	9.4		5+99¹		B6113		7072 E Kellogg		8-1-66	
	8+00	168.5	159.04	9.5		7+74°							
		168.5	out 159.28 in 159.32	9.5	8+58¹	4" Stub W.							
	9+00	168.9	159.44	9.5		9+57⁵		#B6107		7036 E. Kellogg		8-1-66	
	10+00	169.3	159.84	9.5		10+34⁴		#B-6110		7059 E. Kellogg		8-1-66	
	11+00	169.5	160.24	9.3									
		169.5	160.28	9.2	11+08¹	6" Stub N.W.		#B6109		7048 E. Kellogg		8-1-66	
Line #2	= 3+58¹ Ln. #1 0+00	166.6	158.01	8.6	Exist. 0+00								
	1+00	167.0	158.58	8.4		N. 1+12⁵		#B6101		7000 E. Kellogg		8-1-66	
	2+00	167.2	159.15	8.0									
		167.4	out 159.36 in 159.40	8.0	2+37°		E. 3+85		#C14757		7006 E. Kellogg		7-29-69
	3+00	168.0	159.95	8.0			~~3+19⁵~~		#B6102				8-1-66
	4+00	168.5	160.82	7.7			4+74⁵		#B-6104		7018 E. Kellogg		8-1-66
	5+00	169.4	161.69	7.7									
		169.9	out 162.03 in 162.07	7.8	5+39°								
	6+00	170.3	162.31	8.0			6+15⁵						
	7+00	170.8	162.71	8.1			7+50°		#B6106		7030 E. Kellogg		8-1-66
	8+00	171.2	163.11	8.1									
		171.3	163.28	8.0	8+41°		6" Stub N.E.		#B6108		7042 E. Kellogg		8-1-66

B6111 - 7060 E. Kellogg - Robert McElroy 8-1-66 tap (8+69.6)
#B6112 - 7066 E. Kellogg - Robert McElroy 8-1-66 tap (7+69.1)
#B6102 - 7006 E. Kellogg - Robert McElroy 8-1-66 tap (3+85.6)
#B6292 - 7020 E. Kellogg - Ray Robertson, Inc. 9-6-66 tap (7+01.9) Swim Pool Bath house
#B6105 - 7024 E. Kellogg Robt. McElroy 8-1-66 tap ~~(6+44)~~ (6+45 tap C14758 7-29-69) Downing-Brake
#B6106 - 7030 E. Kellogg Robt McElroy 8-1-66 tap (7+27.8)