
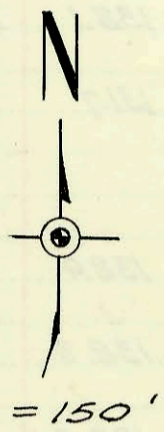
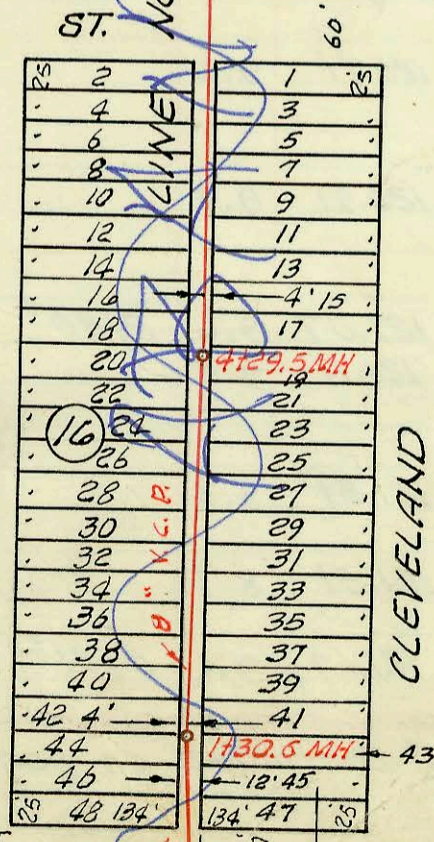
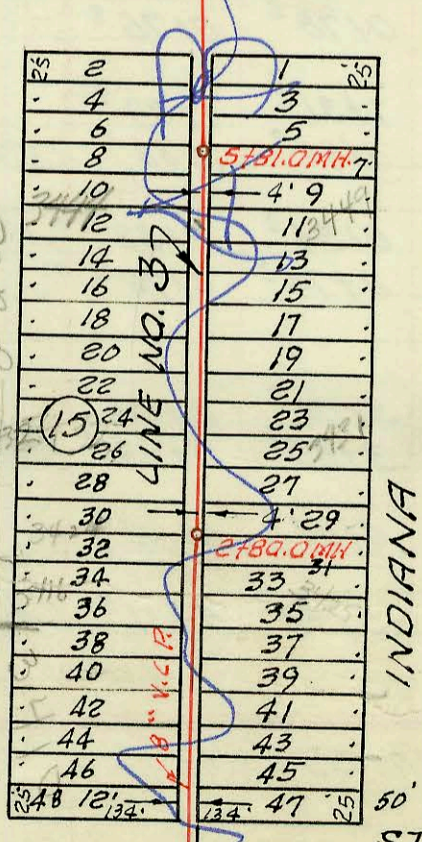
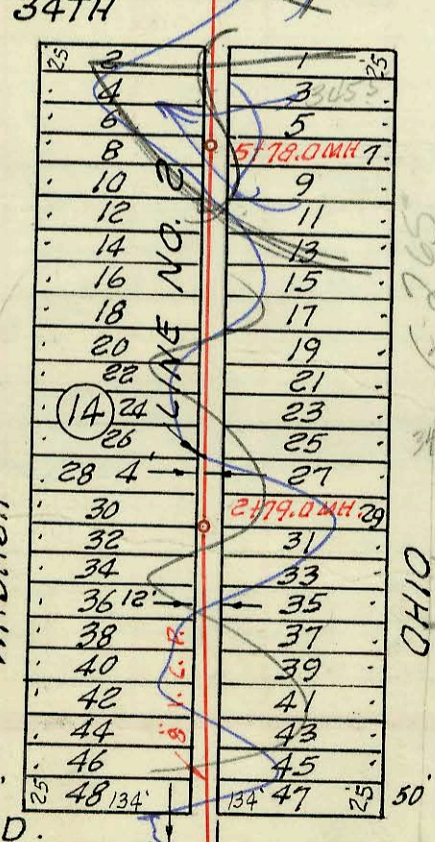
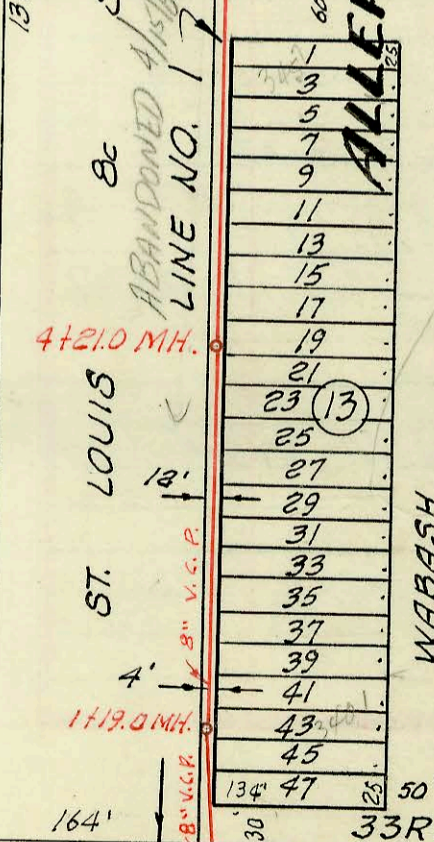
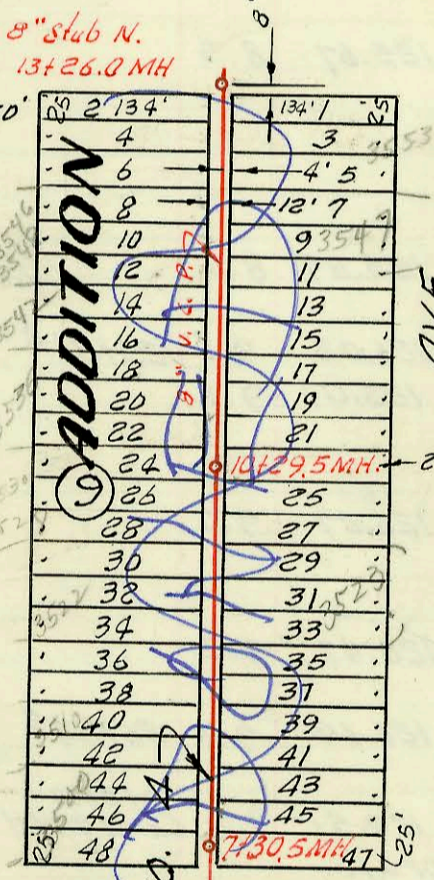
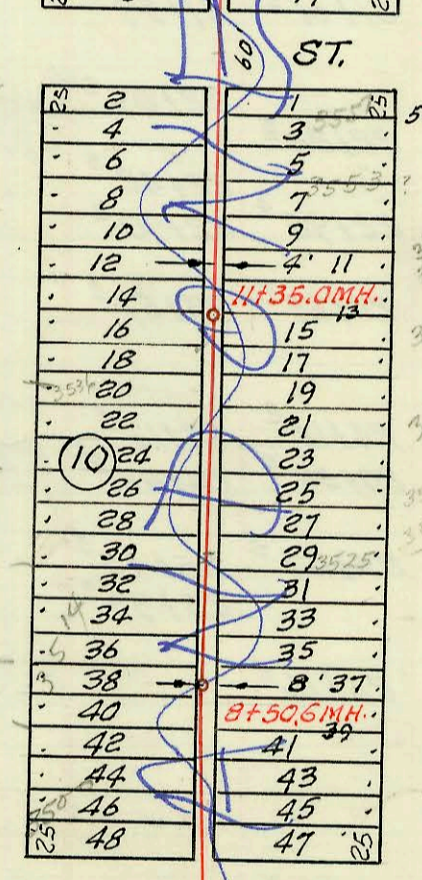
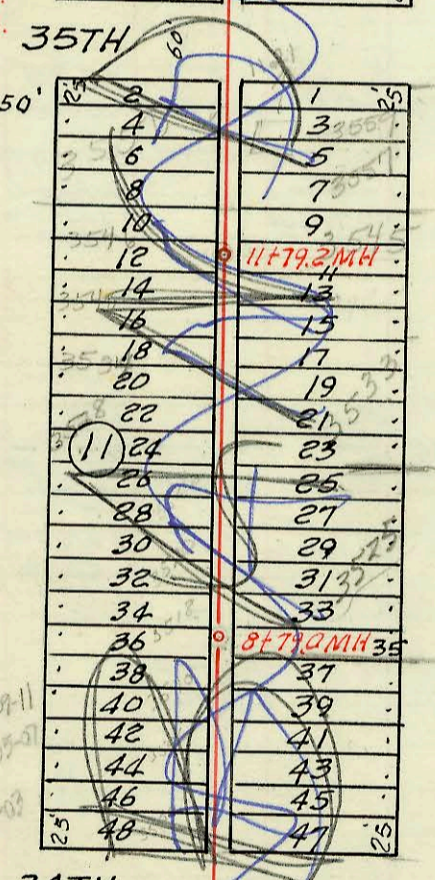
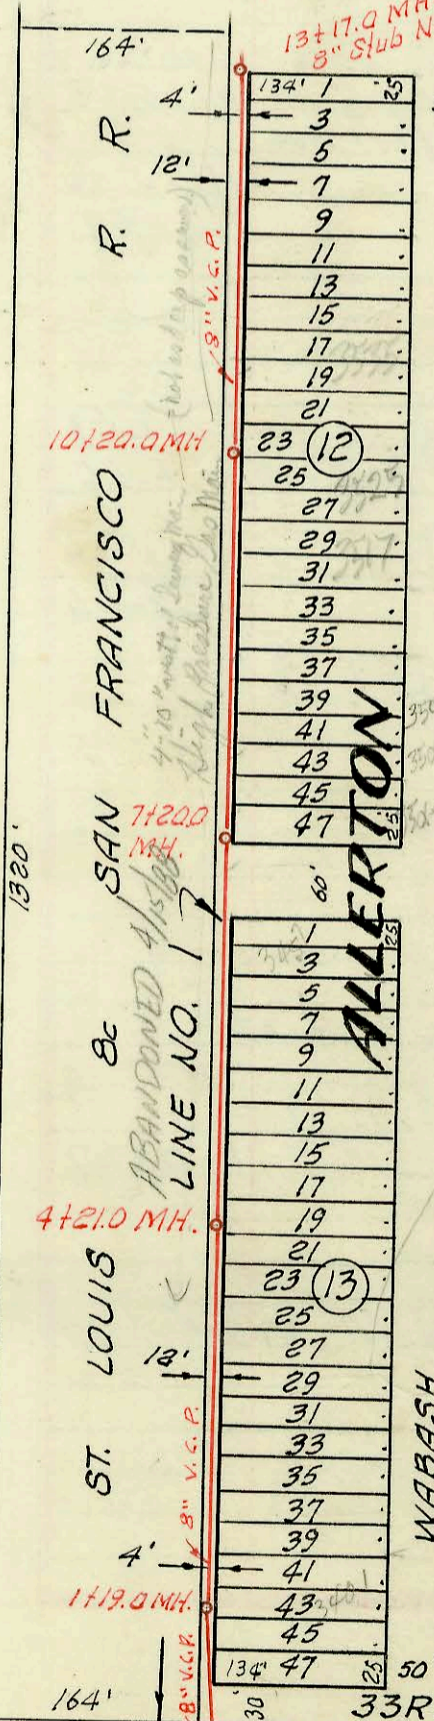
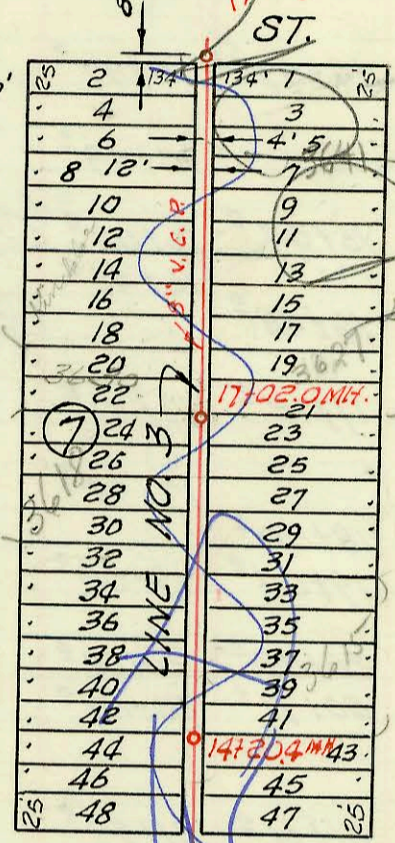
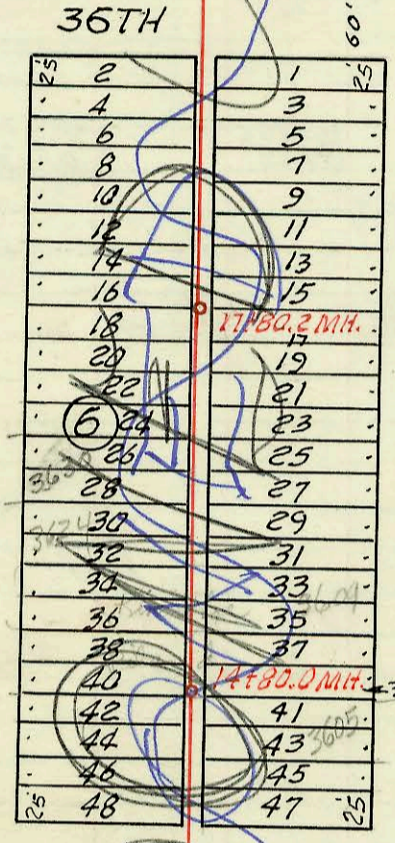


PRIVATE SAN SEWER IMPALA INDUSTRIES  
BUILT BY: W.B. CARTER CONST. CO.  
PROJ. NO. AAKB 502001  
BOOKED 4-24-72 FROM 1HT5  
(See Page 84)  
for connection records

LAT. 56, SUB. 4, S. S. NO. 23  
UTILITY CONTRACTOR INC.  
PROJ. NO. C 26-16 BK. NO. K-83A  
SEPT. 20, 1966  
See G265

NOTE: Construction Record  
booked on pages  
67, 68, 69 & 70.

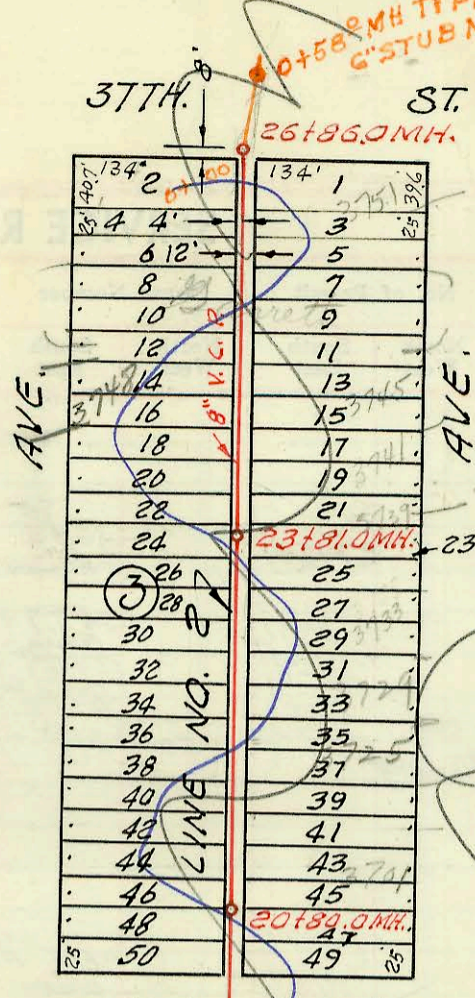

Abandoned line sealed in drawings dtd 4/15/88  
Line to West Sealed 4/15/88  
see L35 G265  
at 05.0 Beg. Proj.  
at 00.0 Existg MH.  
at 05.0 Beg. Proj.  
at 00.0 Existg MH.  
at 05.0 Beg. Proj.  
at 00.0 Existg MH.  
at 05.0 Beg. Proj.  
at 00.0 Existg MH.

CONSTRUCTION RECORD

SERVICE RECORD

STATION	ELEVATION		Depth	MANHOLE	4-INCH "Y" BRANCHES		No. of Permit		House Number		DATE OF PERMITS	
	Ground	Grade			North West	South East	North West	South East	North West	South East	North West	South East
6+00	130.9	122.26	8.6									
7+00	131.0	122.46	8.5		6+26°	6+24°						
8+00	131.3	122.66	8.6		7+60°	7+58°	53421 C41675	53427 C6277	3500 Ohio	3501 Indiana	1-28-76 10-12-73	12-28-67
	131.6	122.76	8.8	8+50°		8+38°						
9+00	131.4	122.86	8.5		8+64°							
					9+06°	9+04°		53430 C17850	3525 Indiana		1-28-76 2-4-70	
					9+87°	9+54°						
10+00	132.5	123.06	9.4		10+45°	10+43°	53422 C21343		3536 Ohio		1-28-76 10-13-70	
11+00	132.6	123.26	9.3		11+08°	11+06°						
	132.9	123.33	9.6	11+35°		11+06°						
12+00	132.6	123.46	9.1		11+63°	11+61°						
					12+86°	12+50°						
13+00	132.8	123.66	9.1			12+84°						
14+00	132.6	123.86	8.7									
	132.7	123.90	8.8	14+20°	14+08°	14+06°	53423 C17796		3604 Ohio		1-28-76 1-29-70	
					14+90°	14+88°			3615 Indiana			10-6-66
15+00	133.0	124.06	8.9		15+51°							
						15+84°		53424 C1964	3617 Indiana		1-28-76 2-20-67	
16+00	132.4	124.26	8.1		16+25°							
17+00	133.1	124.46	8.6									
	133.1	124.46	8.6	17+02°					3618 Ohio		1-28-76 2-4-69	
18+00	134.0	124.66	9.3		17+24°	17+22°	53425 C14396	53427 C2712	3630 Indiana		9-16-76 6-9-69	1-28-76 4-17-67
					18+42°	18+00°	53426 C1157		3631 Indiana		1-28-76 5-9-76	
					18+52°	18+50°	53427 C727	53428 C14051	3632 Indiana		1-28-76 11-7-66	5-12-67
						18+91°		53428 C51805	3641 Indiana		1-28-76 10-4-66 10-9-75	
19+00	133.9	124.86	9.0		19+02°							
						19+28°		C728	3640 Ohio		1-28-76 11/7/66	10-4-66
	134.1	125.03	9.1	19+87°	8" stub	N.			3645 Indiana			
0+00	130.6	120.78	9.8	0+00.0 EXIST'G MH								
0+05°	Beg. proj.											
1+00	130.6	120.98	9.6		0+78°	0+76°						
	130.5	121.04	9.5	1+30°								
2+00	130.5	121.18	9.3		1+51°	1+49°						
					2+29°	2+27°						
3+00	130.7	121.38	9.3		3+04°	3+02°						
					3+82°	3+80°						
4+00	131.0	121.58	9.4		4+51°	4+49°						
	131.0	121.64	9.4	4+29°								
5+00	131.1	121.78	9.3		5+29°	5+27°						
6+00	131.4	121.98	9.4		6+04°	6+02°						
7+00	131.6	122.18	9.4									
	131.2	122.24	9.0	7+30°	7+43°	7+41°	53433 C31275	53455 C19617	3519 Indiana	3501 Indiana	1-28-76 3-30-72	1-28-76 6-9-70
8+00	131.2	122.38	8.8		8+10°	8+08°						
					8+61°	8+59°						
9+00	131.4	122.58	8.8		9+19°	9+17°	53434 C14601		3522 Indiana		1-28-76 6-20-69	
					9+79°	9+77°	53435 C3912		3525 Indiana		1-28-76 7-13-67	
10+00	132.0	122.78	9.2		10+22°	10+20°	53436 C3913		3530 Indiana		1-28-76 7-13-67	
	131.9	122.84	9.1	10+29°								

LINE NO. 3  
Continued

LINE NO. 4

NOTE: Line No. 4 Continues on page No. 70.

SERVICE RECORD				CONSTRUCTION RECORD			
