

This MH. should be
95.8' N. of MH 4+57
Appears to be drawn
wrong. 2-14-71
B.K.

See plate
26

16+06.0 MH.
8" stub E.

WOODROW AVE.

32ND ST.


RIVERDALE

PORTER

33RD

ST.

Arkansas

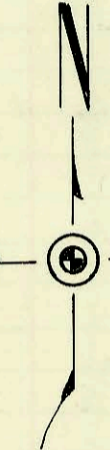

1" = 150'

LAT. 8, SUB. 17, S. S. NO. 22
W. B. CARTER CONST. CO. INC.
PROJ. NO. C 23-15, BK. NO. K-85
DEC. 1, 1966

STATION	ELEVATION			Depth	MANHOLE	4-INCH "Y" BRANCHES		No. of Permit		House Number		DATE OF PERMITS	
	Ground	Grade	MANHOLE			North West	South East	North West	South East	North West	South East	North West	South East
0+00					0+00.0 Exist'g MH								
1+00													
2+00					2+00.0 Exist'g MH								
3+00													
3+37 ^o	128.5	122.00	6.5				3+54.3 ^o		422	3310	Riversdale		6-2-80
4+00	128.5	122.09	6.4										
	128.6	122.11	6.5		4+11 ^o								
	128.0	122.25	5.7		4+87 ^o					3314	Riversdale Rd.		8-18-72
							4+92 ^o		C2252	3316	Riversdale Rd.		3-16-67
5+00	128.3	122.29	6.0										
	129.3	122.32	7.0		5+71 ^o								
							5+79 ^o		C1144	3322	Riversdale Rd.		12-8-66
6+00	129.3	122.35	6.9										
							6+72 ^o		C2911	3330	Riversdale Rd.		5-1-67
7+00	129.4	122.54	6.9										
	129.0	122.67	6.3		7+67 ^o								
							7+79 ^o		C1067	3342	Riversdale Rd.		12-5-66
8+00	129.0	122.74	6.3										
							8+71 ^o		6861	3352	Riversdale		10-28-82
9+00	128.6	122.94	5.7										
							9+67 ^o		C16601	3362	Riversdale Rd.		11-4-69
10+00													
	128.8	123.15	5.6		10+06 ^o								
							10+69 ^o		C2629	3372	Riversdale		8-23-71
11+00	128.2	123.34	4.9										
	128.5	123.50	5.0		11+84 ^o								
							11+98 ^o		C2646	3382	Riversdale Rd.		4-11-67
12+00	128.5	123.54	5.0										
13+00	128.3	123.74	4.6										
	128.3	123.71 out	4.5										
		123.86 in	4.4		13+19 ^o								
14+00	129.4	124.04	5.4										
15+00	129.3	124.34	5.0										
							15+87 ^o		C1091	1125 W 33rd			12-6-66
16+00	129.5	124.54	5.0										
	129.5	124.54	5.0		16+06 ^o		8" stub E						
LINE NO. 2													
0+00	128.6	122.11	6.5		0+00.0 = 4+11.5 Line No. 1				C-22359	3304	Parter		12-28-70
1+00	130.1	122.31	7.8				0+74 ^o						
							1+61 ^o		C1132	3315	Riversdale Rd.		12-8-66
							1+74 ^o						
							1+98 ^o		C47015	3314	Parter		10-15-74
2+00	130.3	122.51	7.8										
	130.5	122.56	7.9		2+25.0								
					4" stub W								
					2+69 ^o				72 5738 ^o	3324	Parter		4-23-72
3+00	130.4	122.71	7.7						942.2	3324	Parter		10-12-83
									5738	3324	Parter		4-23-72
									C50322	3324	Parter		7-14-75
4+00	130.2	122.91	7.3										
	130.0	123.02	7.0		4+57 ^o								
							4+65 ^o		C7721	3344	Parter		4-4-68
5+00	130.6	123.19	7.6										
	130.8	123.39	7.4		5+52 ^o		4" stub W		1065	3362	Parter		12-5-66
					4" stub E				C7680	1309 W 33rd			4-1-68
LINE NO. 3													
0+00	129.0	122.77	6.2		0+00.0 = 7+67 ^o Line No. 1								
	129.0	123.95	5.0		0+35 ^o								
					4" stub N								
					4" stub W				C67921	3339	Riversdale		8-12-78
									C2574	3331	Riversdale Rd.		4-3-67
LINE NO. 4													
0+00	130.7	123.04	7.7		0+00.0 = 4+57 ^o Line No. 2								
1+00	130.7	123.42	7.3										
	129.9	123.79	6.1		1+92 ^o								
					4" stub N				C31613	1301 W 33rd			4-14-72
					4" stub NE				C-1158	1229 W			7-22-75
					4" stub SE				C50455	3353	No. Riversdale		12-9-66
LINE NO. 5													
0+00	128.5	123.60	4.9		0+00.0 = 11+84 ^o Line No. 1								
	129.0	124.03	5.0		0+42 ^o								
					4" stub N				C1066	3379	Riversdale Rd.		12-5-66
					4" stub W				12646	3371	Riversdale		11-26-84

LINE NO. 1

LINE NO. 2

LINE NO. 3

LINE NO. 4

LINE NO. 5