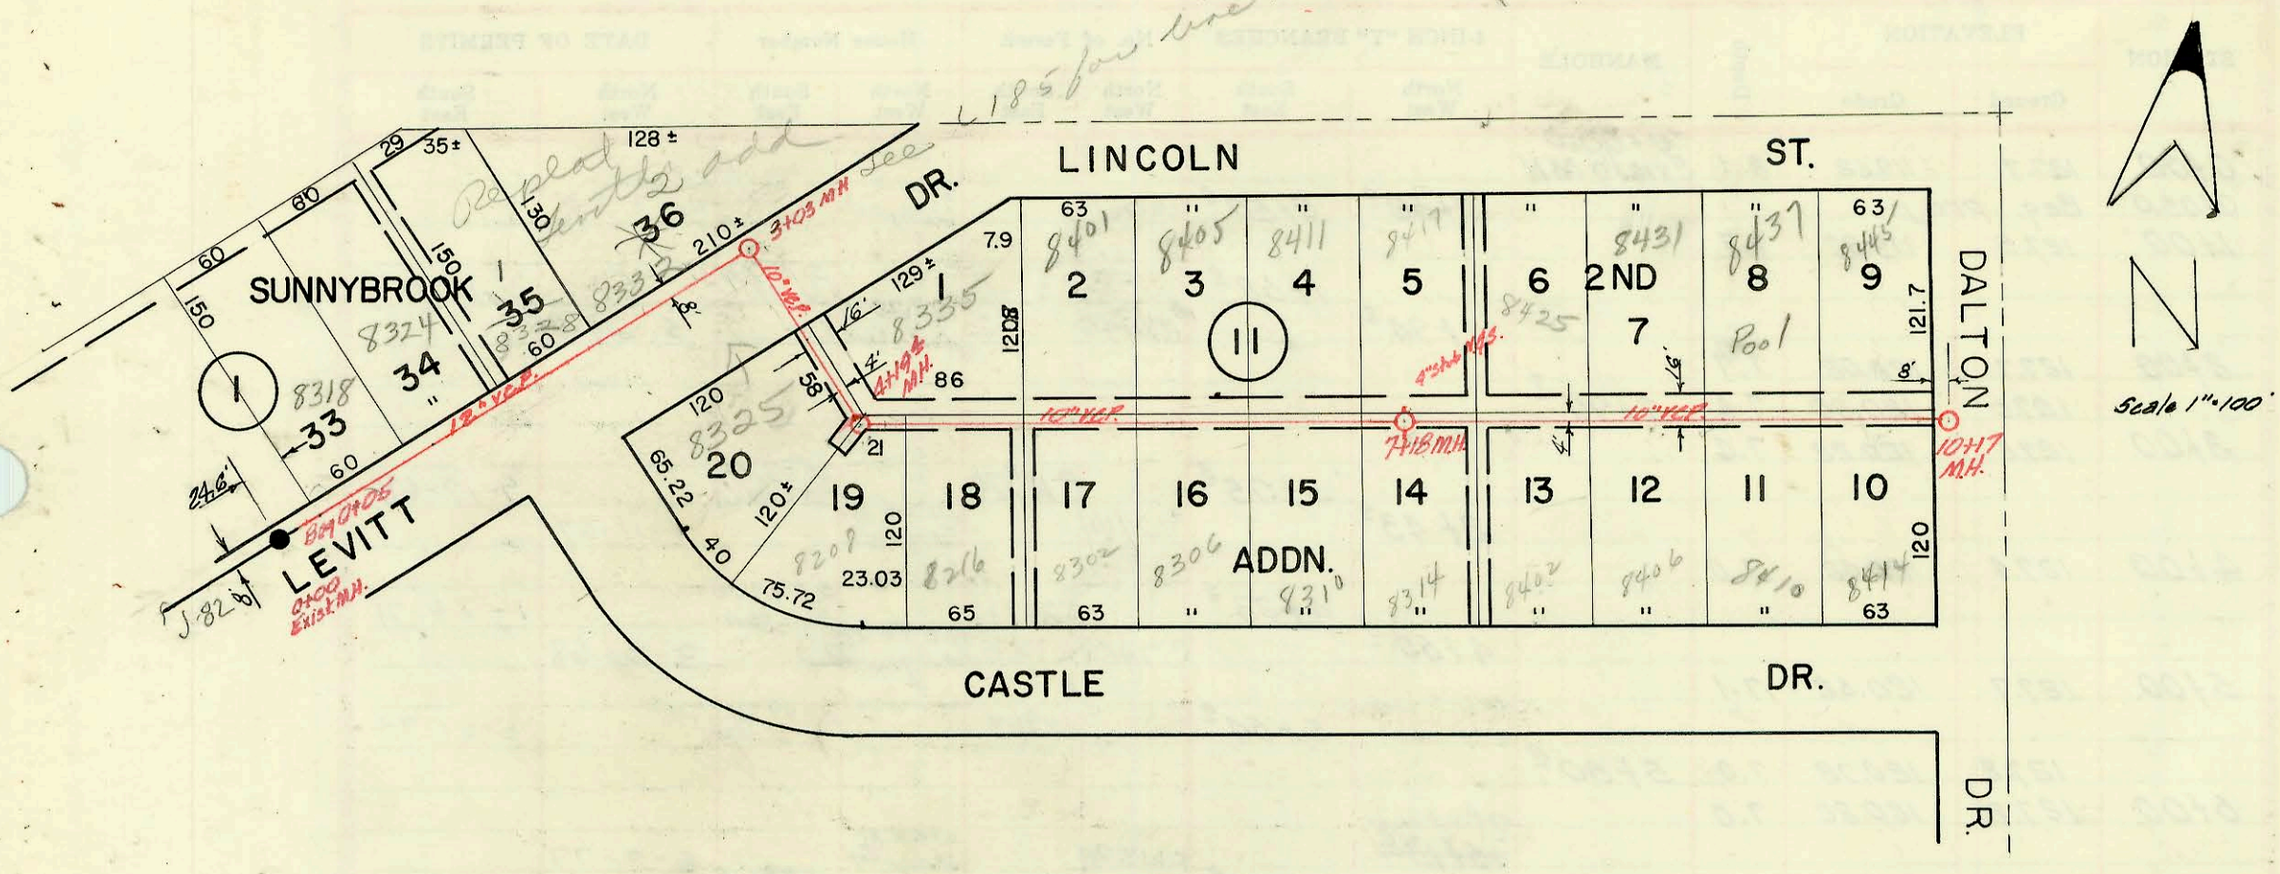

LAT. 6 SUB. 8 W.I.S.
UTILITY CONTRS. INC. 3 - 21 - 67
PROJ. C27 - 103 I.H. 3
3 - 30 - 67

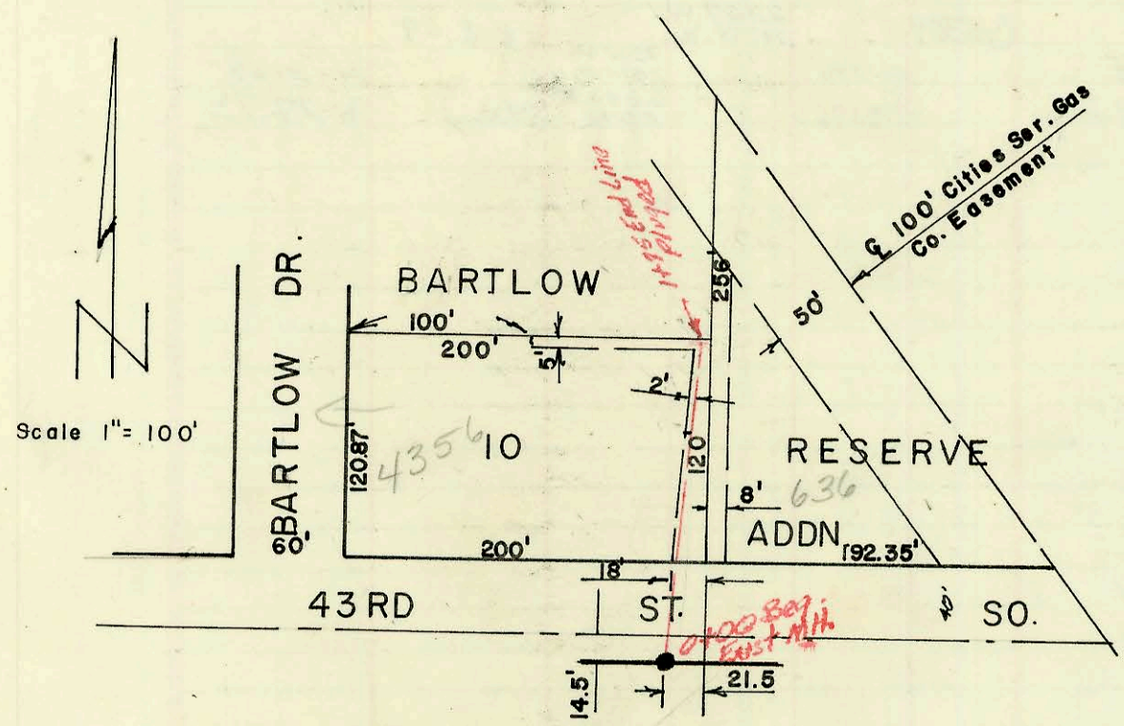

LAT. 5 GLENVILLE SEWER
MID STATES CONSTR. CO. INC. 3 - 7 - 67
PROJ. C26 - 64 BK J.A.K. 2, S.S., 4 - 3 - 67

Form 42-020

CONSTRUCTION RECORD							SERVICE RECORD					
STATION	ELEVATION		Depth	MANHOLE	4-INCH "Y" BRANCHES		No. of Permit		House Number		DATE OF PERMITS	
	Ground	Grade			North West	South East	North West	South East	North West	South East	North West	South East
				0+00 M.H.								
0+00	149.6	140.90	8.7	0+05 Beg	12" V.C.P.							
					+40							
1+00	147.9	141.30	6.6									
					+02.5		C7133		8324 Levitt Dr		3-4-68	
					+70.0		C34053		8328 Levitt Dr		8-3-72	
2+00	147.0	141.70	5.3									
					+28.0							
3+00					TAP 2+36.5		C29283		8332 Levitt		12-6-71	
	147.3	142.11 142.30	5.2	3+02.0	End 12" Beg 10" V.C.P.							
					+72.0							
4+00	148.4	142.90	5.5		TAP 4+09.4		C5953		8335 Levitt Dr		12-1-67	
	148.8	143.02 143.13	5.8	4+19.4								
					+33.0	+30.0		#C6435		8208 Castle Dr.		1-17-68
						+60.0		C8229		8216 Castle Dr		5-9-68
5+00	150.2	143.58	6.6		TAP 5+36.4		C6835		8401 E. Lincoln		2-12-68	
					+21.0	+24.0		C5710		8302 Castle Dr		11-10-67
					+87.0	+90.0		C4990		8306 Castle Dr		9-25-67
6+00	152.7	144.18	8.5		TAP 6+03.4		C6836		8405 E Lincoln		2-12-68	
					+47.5	+50.5	C11378	C3400	8411 E. Lincoln	8310 Castle Dr	11-12-68	6-5-67
7+00	155.1	144.78	10.3									
	155.8	144.90	10.9	7+18	4" Stub N	4" Stub S	#C16124	C12617	8417 E. Lincoln	8314 Castle Dr	10-1-69	2-4-69
					+81.0	+84.0	C13919	C7888	8425 E. Lincoln	8402 Castle Dr.	5-2-69	4-16-68
8+00	157.5	146.10	11.4									
					+36.0	+39.0	C13069	C6536	8431 E. Lincoln	8406 Castle Dr.	3-7-69	1-23-68
9+00	159.7	147.60	12.1									
					+01.5	+04.5	#C11931	C21395 C2681	8437 E. Lincoln	8410 Castle Dr.	12-11-68	8-29-88 4-13-67
					+63.5	+66.5		2545 C10178		8414 R Castle Dr		6-4-90 8-23-68
10+00	162.5	149.10	13.4									
	162.5	149.40	13.1	10+17.0	End 10" V.C.P.							
LAT. 5 GLENVILLE SEWER												
0+00	87.7	82.15	5.5	Exist. M.H. Beg								
1+00	88.5	82.35	6.2									
					1+08.0		#C5144		4356 Bartlow Dr	636 W. 43rd St. So.	10-5-67	
						1+14.5		#C5145				10-5-67
1+75	88.0	82.50	5.5	Line Plugged								

C11614 - 8445 E. Lincoln - Dave Covington 11-19-68 - tap (9+58.4)
C6783 - 8318 Levitt - al Henning - 2-7-68 - tap (0+32.8)