


CONSTRUCTION RECORD

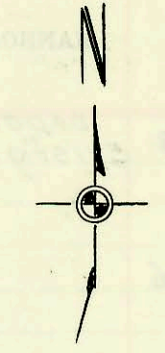

LAT. 14, SUB. 17, S. S. NO. 22  
 MID-STATES CONST. CO. INC.  
 PROJ. NO. C23-31; BK. NO. K-85  
 APRIL 14, 1967

SEDGWICK

ST. CLAIR

AVE

29TH ST. NO.

27TH ST. NO.

2327  
 2301  
 2947  
 2933  
 2900  
 2917  
 2901  
 2862  
 2859  
 2848  
 2847  
 2834  
 2833  
 2820  
 2817  
 2800  
 2801

153.6'  
 140.797'  
 140.797'  
 140.797'  
 140.797'  
 140.797'  
 140.797'  
 140.797'  
 136.70'  
 153.6'

126.717'  
 126.717'  
 126.717'  
 126.717'  
 126.717'  
 126.717'  
 126.717'  
 126.717'  
 126.717'  
 138.36'

156'  
 16'  
 302.14'  
 8'  
 10'  
 8'  
 10'  
 6'  
 8'  
 10'  
 5'  
 8'  
 8'  
 4'  
 10.5'

8" V.S.P.  
 4" Stub NE  
 8181.0 M.H.  
 5180.8 M.H.  
 2190.7 M.H.  
 0105.0 Beg. Proj.  
 0100.0 Existg M.H.

CONSTRUCTION RECORD						SERVICE RECORD						
STATION	ELEVATION		Depth	MANHOLE	4-INCH "Y" BRANCHES		No. of Permit		House Number		DATE OF PERMITS	
	Ground	Grade			North West	South East	North West	South East	North West	South East	North West	South East
0+00	127.7	119.62	8.1	0+00.0 Existg MH								
0+05.0	Beg. Proj.				0+52°	0+50°	C61567		2800 W. Sedgwick		11-28-78	
1+00	127.5	119.82	7.7									
					1+94°	1+68°	#08490	C2326	2820 N. Sedgwick	2817 N. St. Clair		3-15-71
2+00	127.7	120.02	7.7									
	127.6	120.20	7.4	2+90 <sup>1</sup>								
3+00	127.6	120.22	7.4									
					3+43°	3+05°	#2744	C10524	2834 N. Sedgwick	2833 N. St. Clair		9-19-68
4+00	127.4	120.42	7.0									
					4+60°	4+23°	#22712		2848 N. Sedgwick	2847 N. St. Clair		1-26-71
5+00	127.7	120.62	7.1									
					5+64°		039110			2859 N. St. Clair		5-21-73
	127.8	120.78	7.0	5+80°								
6+00	127.8	120.82	7.0		6+13°							
					6+84°		C61374		2862 N. Sedgwick		6-2-77	
7+00	128.1	121.02	7.1									
					7+55°		#2801			2901 N. St. Clair		12-8-83
8+00	127.7	121.22	6.5									
	127.6	121.38	6.2	8+81°								
					8+97°		#2802			2912 N. St. Clair		5-8-67
9+00	127.7	121.46	6.2									
					9+43°		#1466			2920 N. St. Clair		4-25-67
10+00	127.4	121.86	5.5									
					10+35°	10+37°						
					10+89°							
11+00	127.7	122.26	5.4									
	127.8	122.54	5.3	11+69°	11+50 <sup>1</sup>		C15309		2327 W. 21 <sup>st</sup> St. No.		8-8-69	
					4" stub NE		C13390			2301 W. 29 <sup>th</sup> St. N.		4-3-69
							C39760			2301 W. 29 <sup>th</sup> St. (addr)		6-27-73