



SERVICE RECORD CONSTRUCTION RECORD

DATE OF PERMIT	PERMIT NO.	APPLICANT	ENGINEER	CITY	STATION

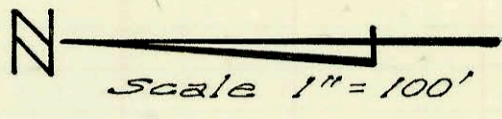

EXTENDING SUPPLEMENTAL SEWER TO
S.S. #12 (EXT. OF S.S. #23 IN 29TH ST.
FROM OLIVER ST. TO 1/4 MI. E. OF OLIVER
UTILITY CONTRACTORS INC. 3-6-67
PROJ. NO. C26-17 K-88 BOOKED 5-15-66
S.S. NO. 23

5228
5227

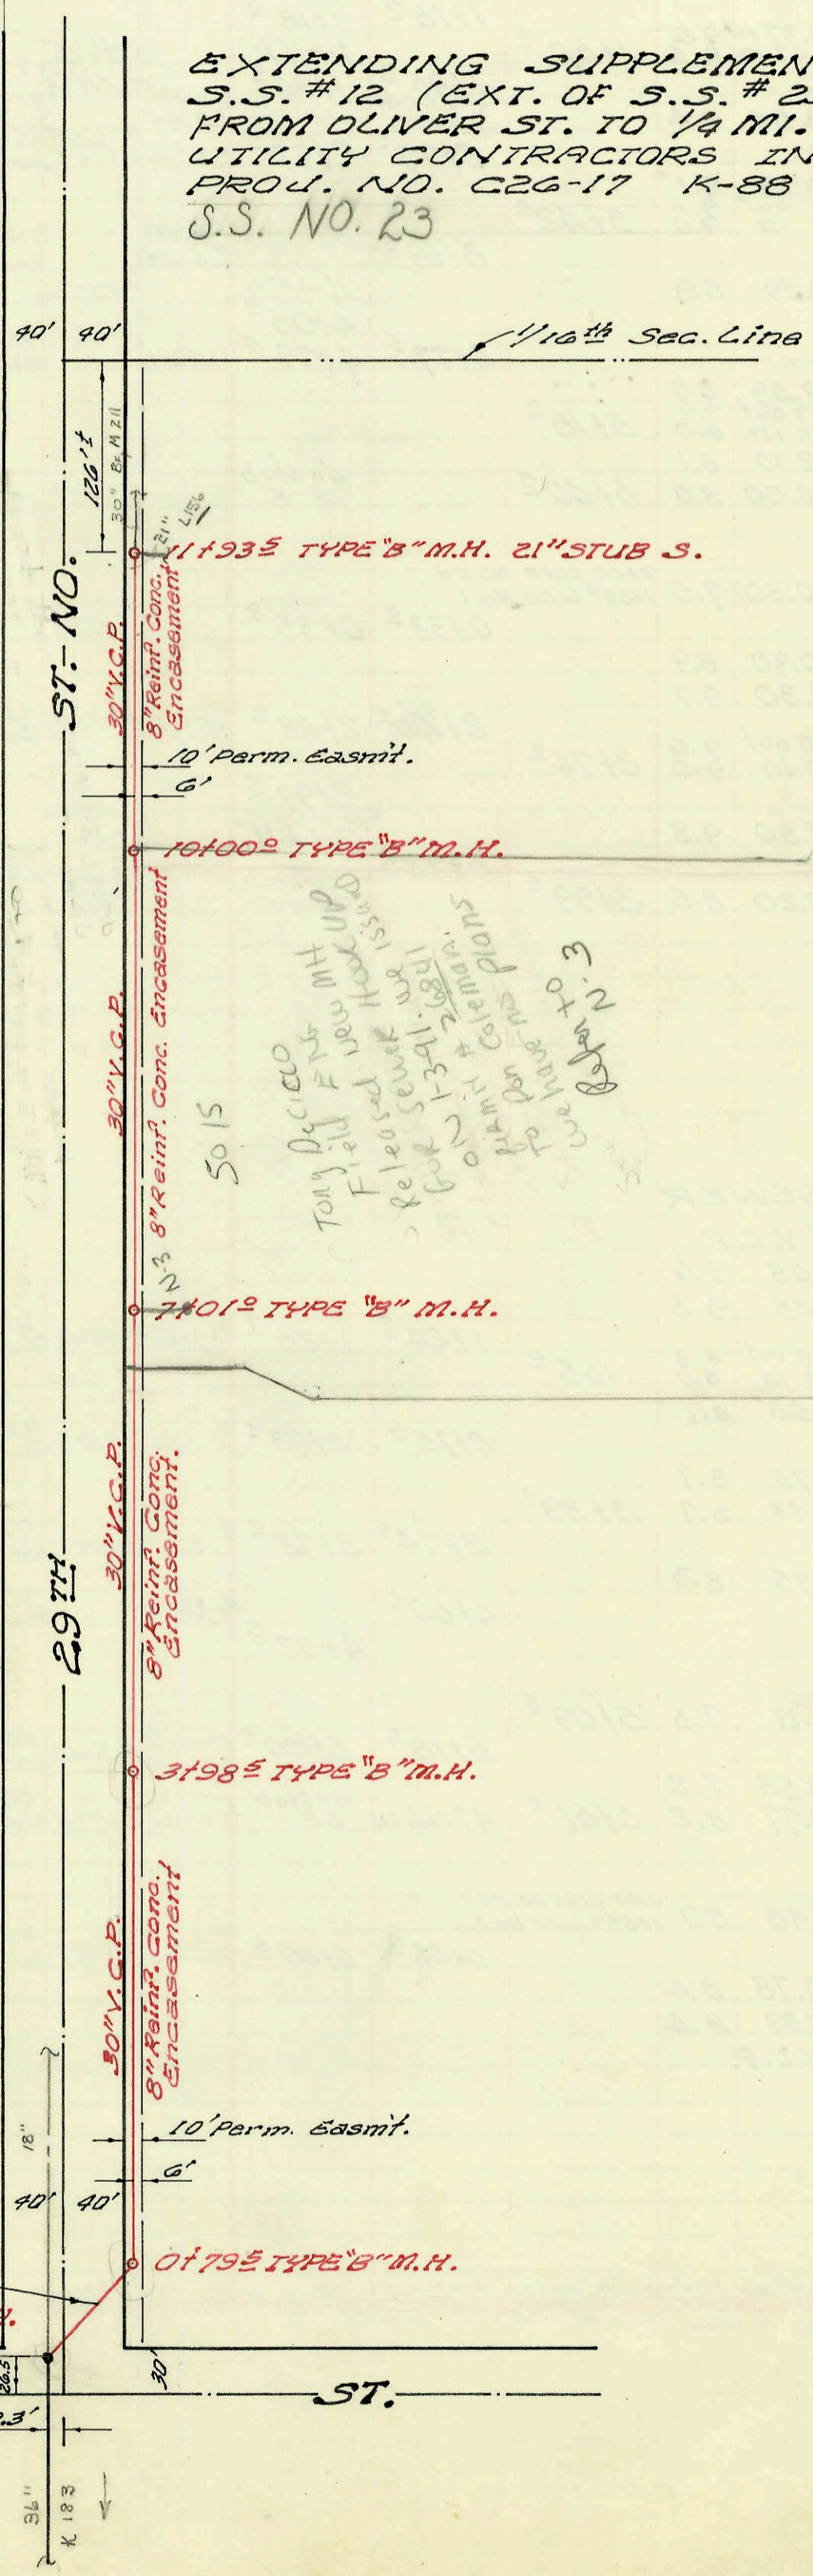

5050
Blower Ballon

Plat Book
29

new
side

CONSTRUCTION RECORD					SERVICE RECORD							
STATION	ELEVATION		Depth	MANHOLE	4-INCH "Y" BRANCHES		No. of Permit		House Number		DATE OF PERMITS	
	Ground	Grade			North West	South East	North West	South East	North West	South East	North West	South East
0+00	160.0	140.78	19.2	Exist. 0+00								
	160.0	140.94	19.1	0+79 ⁵								
1+00	160.0	140.98	19.0									
2+00	160.8	141.18	19.6									
3+00	162.8	141.38	21.4									
	163.1	141.38	21.7	3+98 ⁵								
4+00	163.1	141.58	21.5									
5+00	163.0	141.78	21.2									
6+00	164.5	141.98	22.5									
7+00	165.6	142.18	23.4	7+01 ²								
8+00	165.0	142.38	22.6									
9+00	163.0	142.58	20.4									
10+00	162.0	142.78	19.2	10+00 ²								
11+00	152.0	142.98	9.0									
	156.0	143.17	12.8	11+93 ⁵								
21" stub	S.	145.68			21" stub S.							