87.A

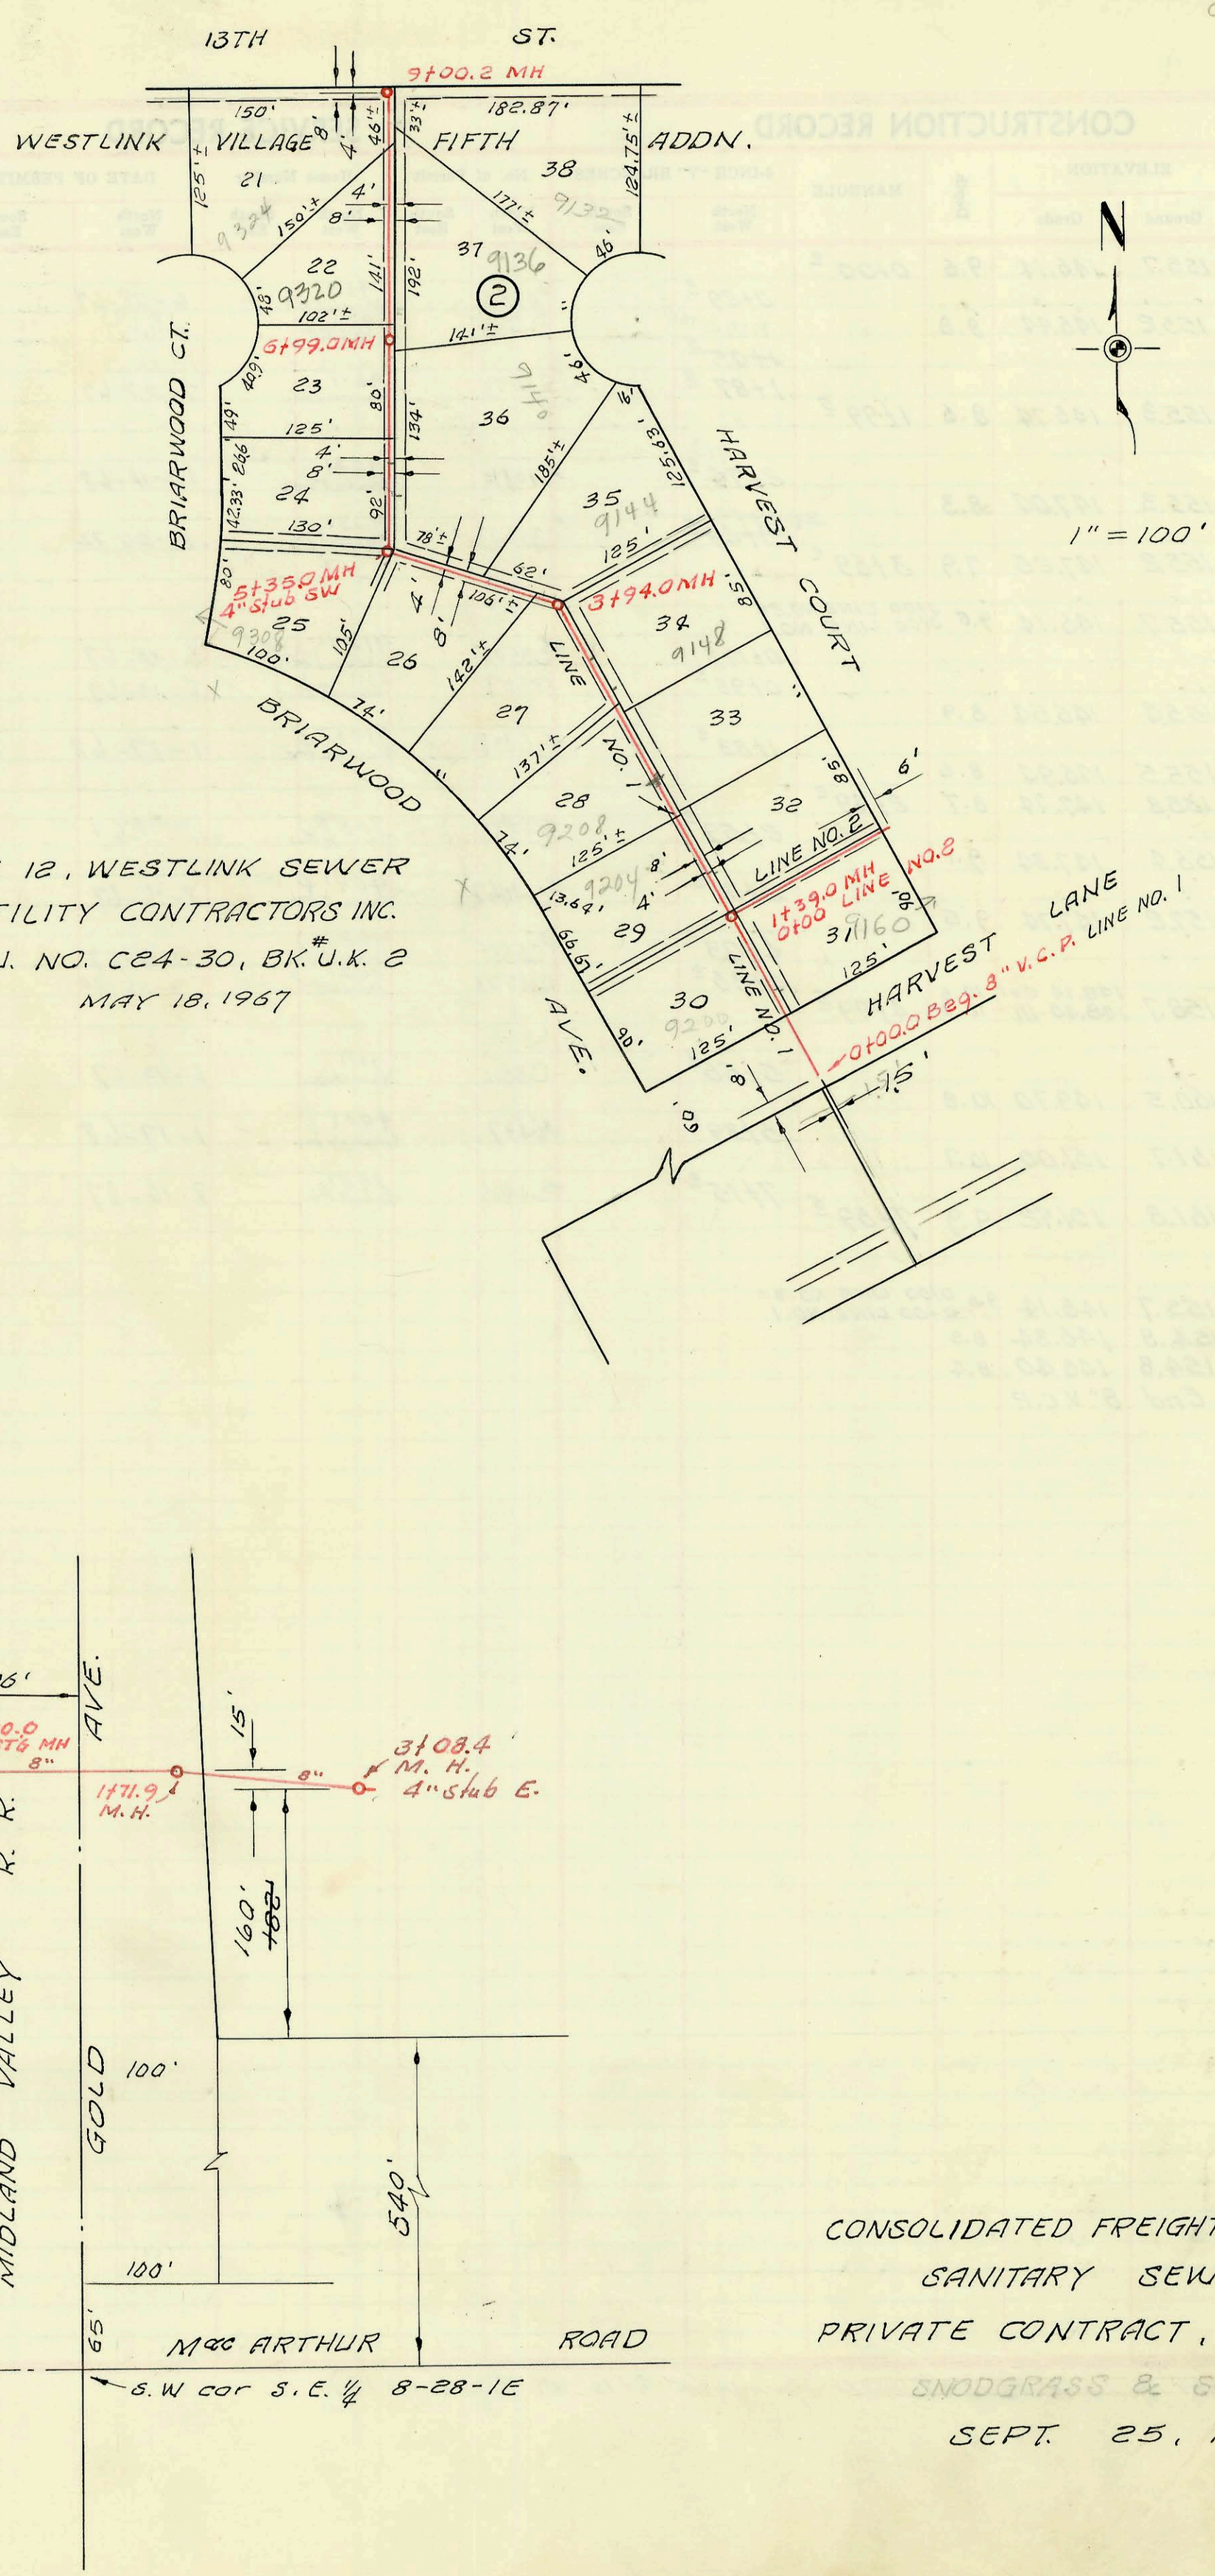
13TH ST.
9+00.2 MH
WESTLINK VILLAGE FIFTH ADDN.
BRIARWOOD CT.
6+99.0MH
5+35.0MH
4" Stub SW
BRIARWOOD AVE.
HARVEST COURT
3+94.0MH
LINE NO. 1
LINE NO. 2
1+39.0 MH
0+00 LINE NO.2
HARVEST LANE
0+00.0 Beg. 8" V.C.P. LINE NO. 1
N
1" = 100'
LAT. 12, WESTLINK SEWER
UTILITY CONTRACTORS INC.
PROJ. NO. C24-30, BK.# U.K. 2
MAY 18, 1967
96'
AVE.
0+00.0
EXISTG MH
8"
1+71.9
M.H.
15'
3+08.4
M. H.
4" Stub E.
R.
R.
MIDLAND VALLEY
737'
160'
100'
GOLD
540'
100'
65'
Mac ARTHUR ROAD
S.W cor S.E. 1/4 8-28-1E
CONSOLIDATED FREIGHTWAYS INC.
SANITARY SEWER
PRIVATE CONTRACT, BK. J.K.# 8
SNODGRASS & SONS
SEPT. 25, 1967

87

Form 42-020

	CONSTRUCTION RECORD							SERVICE RECORD					
	STATION	ELEVATION		Depth	MANHOLE	4-INCH "Y" BRANCHES		No. of Permit		House Number		DATE OF PERMITS	
		Ground	Grade			North West	South East	North West	South East	North West	South East	North West	South East
LINE NO. 1	0+00	Beg.	8" V.C.P.										
	0+00	155.2	146.40	8.8									
							0+69°						
						0+71°							
	1+00	155.2	146.60	8.6									
		155.1	146.68	8.4	1+39°			C3145	#C3119	9200 Harwood	9156 Harvest Ct.	5-25-67	
							1+68°						5-17-67
						1+70°		C4052		9204 Briarwood		7-21-67	
	2+00	155.2	146.80	8.4									
							2+51°		C3121		9152 Harvest Ct		5-17-67
						2+53°		C3509		9208 Briarwood	9200 Bee (W)	6-13-67	
	3+00	155.1	147.00	8.1									
							3+25°		#C3720		9148 Harvest Ct		6-26-67
						3+52°		#C3144		9300 Briarwood		5-18-67	
		155.7	147.19 out 147.29 in	8.5 8.4	3+94°								
	4+00												
							4+08°		#C3721		9144 Harvest Ct.		6-26-67
						4+50°		#C3132		9304 Briarwood Ave.		5-17-67	
	5+00	156.0	147.50	8.5									
		156.1	147.58 out 147.68 in	8.5 8.4	5+35°	4" Stub SW			C3133		9308 Briarwood Ct.		5-17-67
							5+76°						
	6+00	155.8	147.80	8.0		6+00	5+78°	C3134	C5615	9312 Briarwood Ct	9140 Harvest Ct	5-17-67	11-6-67
						6+77°		C3143		9316 Briarwood Ct		5-18-67	
		155.9	148.00	7.9	6+99°								
	7+00												
							7+16°		#C5427		9136 Harvest Ct.		10-24-67
						7+58°		C3135		9320 Briarwood Ct		5-17-67	
	8+00	155.7	148.30	7.4									
						8+58°							
						8+60°	8+69°	C3159	C12776	9324 Briarwood Ct	9132 Harvest Ct	5-18-67	2-13-69
		156.2	148.59	8.6	9+00°								
LINE NO. 2	0+00	155.1	146.78	8.3	0+00 LINE NO. 2 = 1+39° LINE NO. 1								
							0+40°		C3988		9160 Harvest Ct		7-18-67
	1+00	156.5	146.98	9.5									
	1+35.0	157.3	147.05	10.2									
	1+35.0	End	8" V.C.P.										
	0+00	88.8	84.00	4.8	0+00.0 Existg MH								
	0+02°	Beg.	Cast Iron										
	0+24°	Beg.	14" Steel Sleeve										
	0+60°	End	" " "										
	0+82°	End	Cast Iron										
	0+82°	Beg.	8" V.C.P.										
	0+82° 0+96°	Conc.	enc'm't.										
	1+00	88.8	84.20	4.6									
		89.5	84.34	5.2	1+71°								
	2+00	89.2	84.40	4.8									
	3+00	88.6	84.60	4.0									
		88.6	84.63	4.0	3+08°	(4" Stub E)							

95-16089 R 10-10-95 - 9208 W Briarwood - Arrowhead -