



31st. ST.

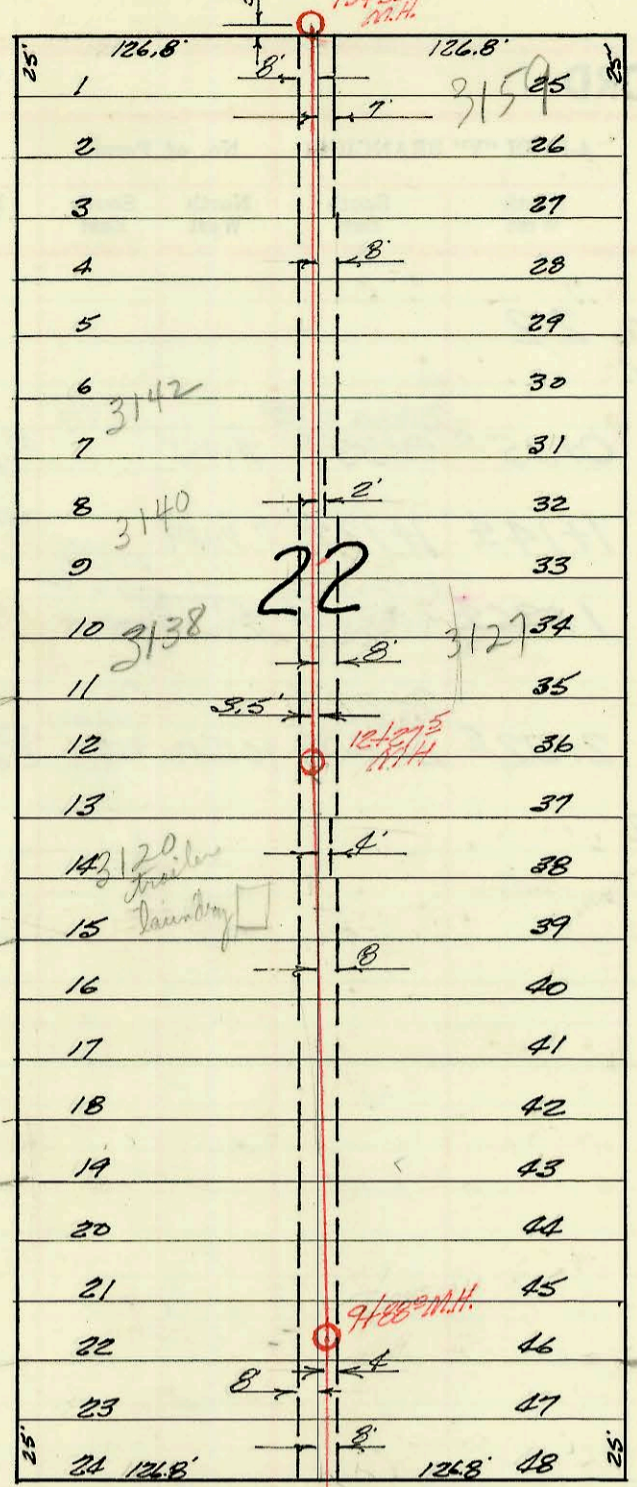


3120 Park Pl.
Group Sept. file # 279

30th. ST.

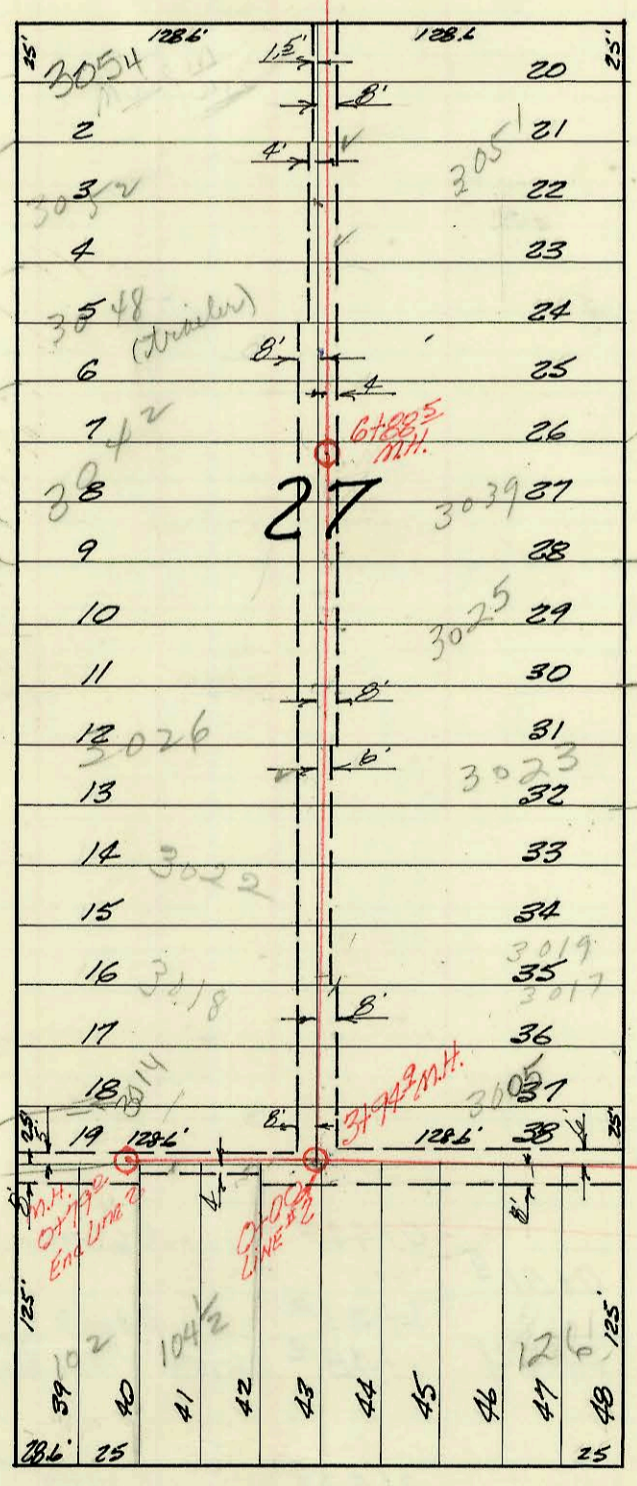

3014 N Park Pl
PAPA...
address...
has a septic system
21846

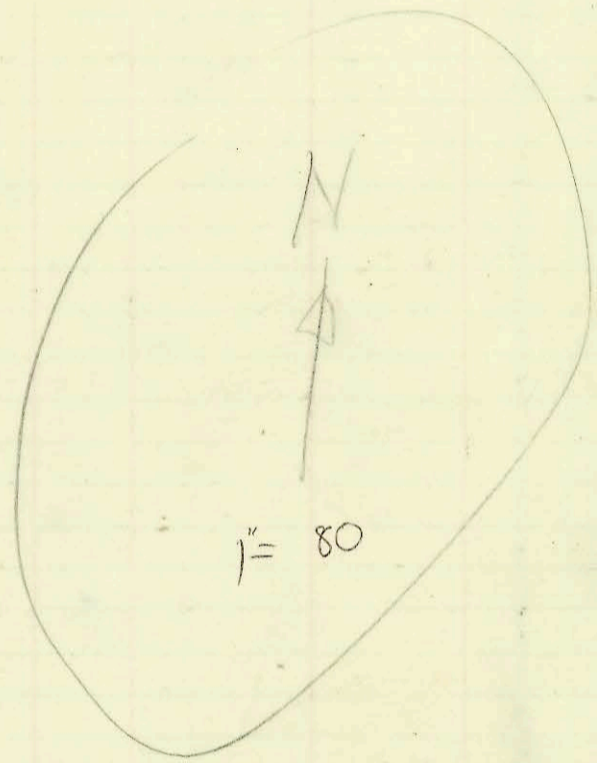

MARKET

LAT. 28, DIST. "T", S.S.# 20
MID-STATES CONSTR. CO., INC.
Prod. C 22-31, 5-2-67, 7-11-67
K-82

29th. ST.

97-21684-2 12-11-91 3120 N PARK PL #6
19456- 4/2/91 - 3017 N. Market N/C
C72196-3005 N. Market - 6-5-79.

2+66
Exist. M.H.
2+96
Prot.
Bay

