L 101 A

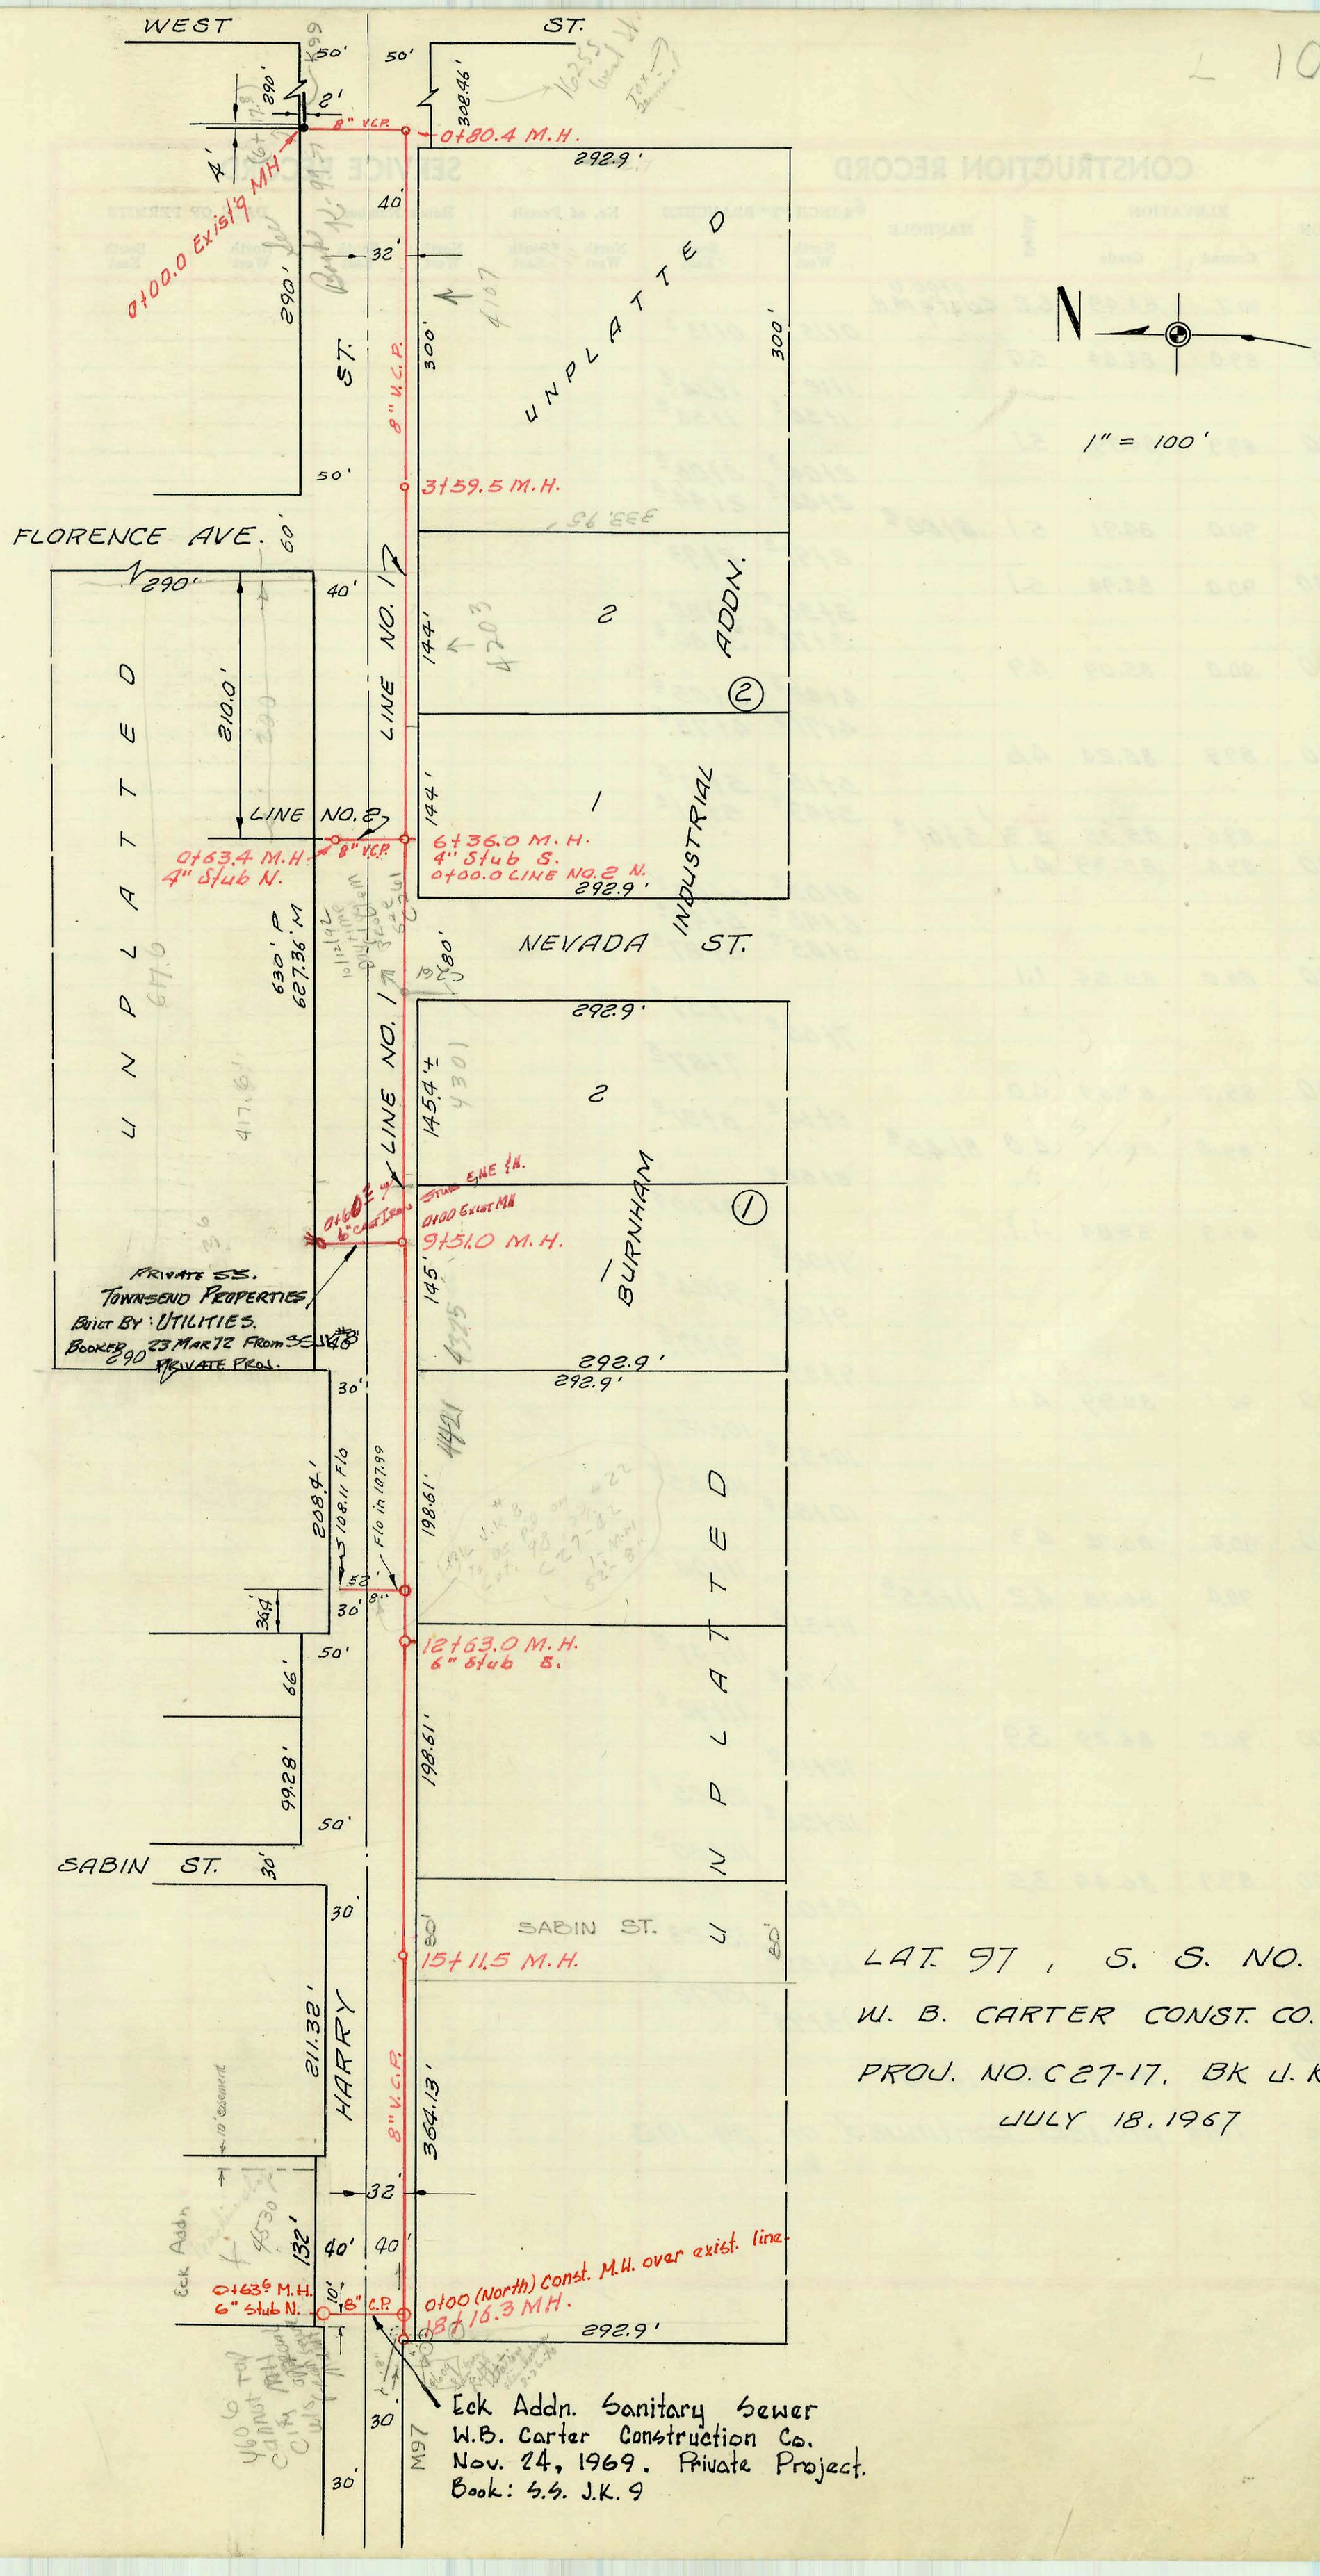

LAT. 97, S. S. NO. 22
W. B. CARTER CONST. CO. INC.
PROJ. NO. C27-17, BK J.K. #3
JULY 18. 1967

Eck Addn. Sanitary Sewer
W.B. Carter Construction Co.
Nov. 24, 1969. Private Project.
Book: S.S. J.K. 9

101

Form 42-020

	CONSTRUCTION RECORD							SERVICE RECORD					
	STATION	ELEVATION		Depth	MANHOLE	4-INCH "Y" BRANCHES		No. of Permit		House Number		DATE OF PERMITS	
		Ground	Grade			North West	South East	North West	South East	North West	South East	North West-	South East
LINE NO. 1	0+00	112.9	105.49	7.4	0+00.0 Existg MH.								
		110.8	105.65 out 105.75 in	5.1 5.0	0+80 4								
	1+00	112.6	105.79	6.8									
							6" on 8" 1+28 4						
	2+00	112.2	105.99	6.2		TAP	1+60 4		C13352		4107 W. Harry		4-1-69
							6" on 8" 2+39 1		C50166		4107 W. Harry		7-3-75
	3+00	112.0	106.19	5.8									
							6" on 8" 3+16.0						
		112.2	106.31	5.9	3+59 5								
	4+00	112.7	106.39	6.3									
	5+00	112.8	106.59	6.2			5+48.5 ~~6~~ 6" on 8" 8 5+33.3		13966		4203 W. Harry		6-10-85
	6+00	112.7	106.79	5.9									
		112.6	106.86	5.7	6+36 0		4" stub S.						
	7+00	112.5	106.99	5.5									
							7+82 8						
	8+00	113.4	107.19	6.2									
							8+50 5		C48938		4301 W. Harry		4-9-75
	9+00	112.5	107.39	5.1									
		113.2	107.49	5.7	9+51 0								
	10+00	113.1	107.59	5.5									
							6" on 8" 10+32 0		C5414		4325 W. Harry		10-23-67
							6" on 8" 10+58 7		C5225		4421 W. Harry		10-11-67
	11+00	114.4	107.79	6.6									
	12+00	114.3	107.99	6.3									
		114.4	108.12	6.3	12+63 0		6" stub S.		C6771		4425 W. Harry		2-6-68
	13+00	113.8	108.19	5.6									
							13+08 4						
	14+00	114.5	108.39	6.1									
	15+00												
		112.6	108.61	4.0	15+11 5								
							15+25 5						
	16+00	112.4	108.79	3.6		TAP	15+93 7		C22912		~~4546~~ 4509 W. Harry		2-12-71
							16+02 5						
	17+00	112.5	108.99	3.5									
							17+93 8						
	18+00	113.8	109.19	4.6									
		114.0	109.22	4.8	18+16 3								
LINE NO. 2	0+00	112.6	106.96	5.6	0+00.0 LINE NO. 2 = 6+36.0 LINE NO. 1								
		111.9	107.22	4.7	0+63 4		4" stub N.		C7031 (6" tap)		4200 W Harry		2-26-68
	Eck Addition Sanitary Sewer												
		113.4	109.37	4.0	0+00		Tap 6+60.1		C71300		4530 W. Harry		4-18-79
		112.3	109.69	2.6	0+63 6		6" Stub North		C17735		4530 W. Harry		1-26-70
	TOWNSEND PROPERTIES S.S. (FOR TOWNSEND 2ND ADDN.)												
		113.3	107.59	5.7	0+00 EXIST MH								
					0+60 2 w/6" CAST IRON STUB		East stub E, NE & N.		C33618		4200 W Harry		7-17-72
									C31123		4200 W. HARRY		3-21-72
							6" stub (extended NE 20' under 12,000 voltage line) 7-17-72 OK per Walton						

Record #12660 - 4421 W. Harry - Jadtman 11-28-84 (1061' W of MH 12+63.0) (10+57.1)

C5544 - 4421 W Harry - George Bldg 11-1-67 Tap (10+54.0)

C5545 - 4325 W Harry George's Bldg 11-1-67 Tap (10+36.6)