111A

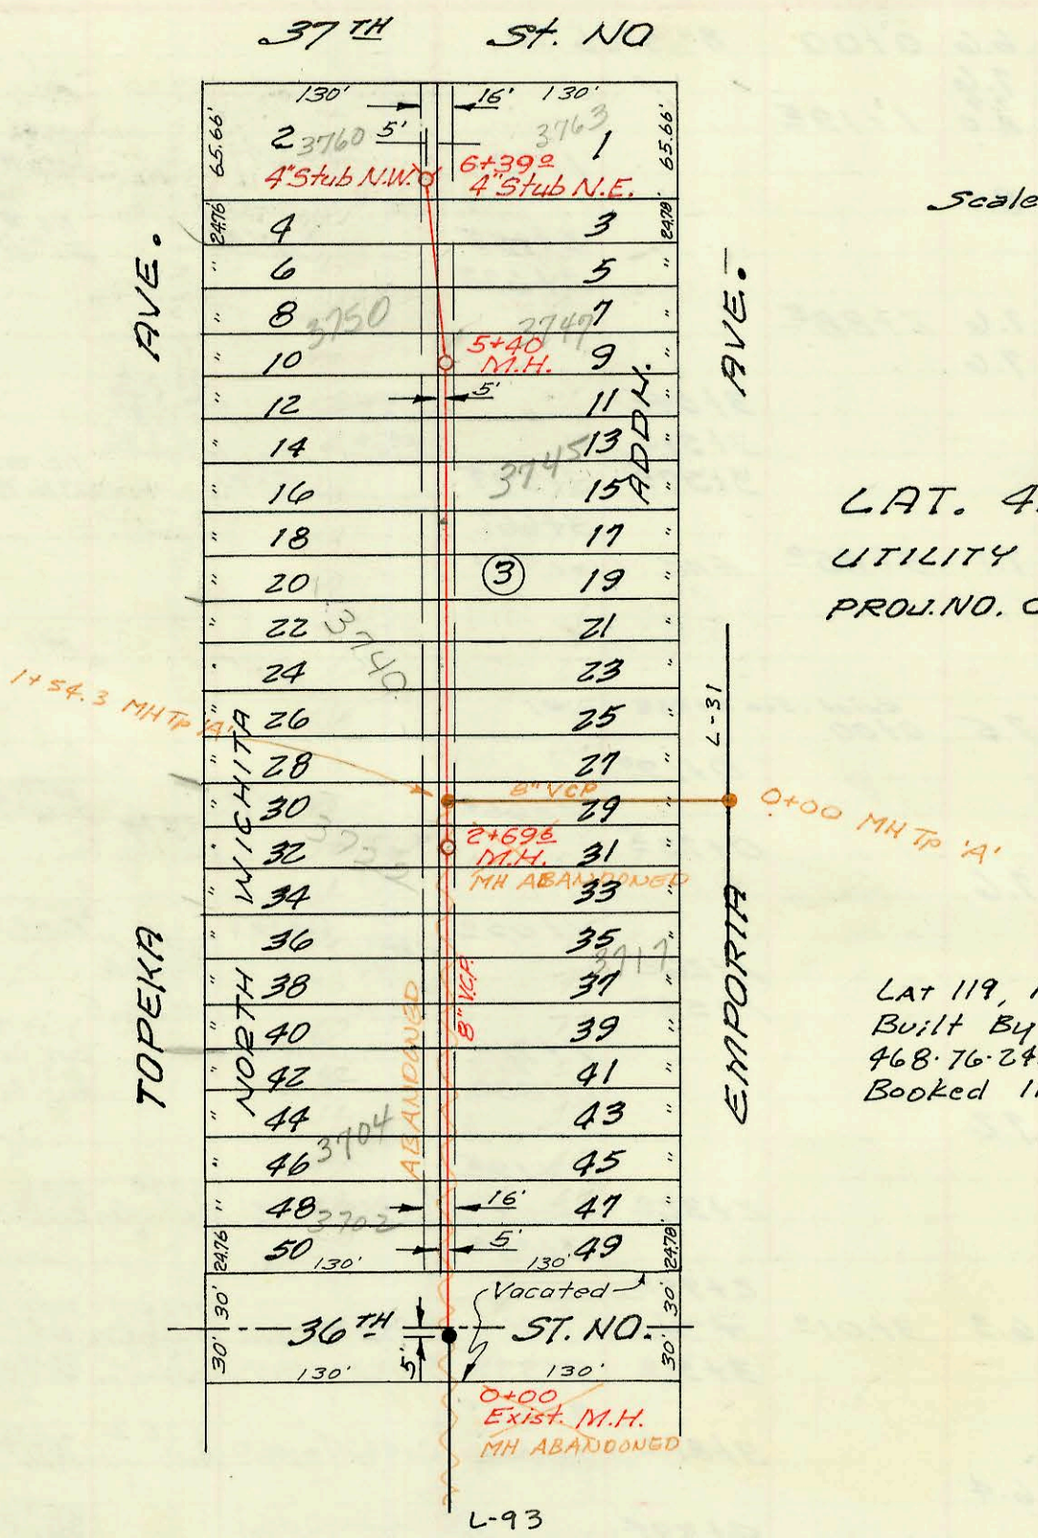

Scale 1" = 100'

LAT. 43, SUB. 4, S.S. 23
UTILITY CONTRACTORS INC.
PROJ. NO. C24-50 BOOKED 8-18-67 K-82

LAT 119, MAIN 4, S.S # 23
Built By Stannard Const. Co.
468-76-245-81404-000-000-001
Booked 11-21-85 From AG 14A

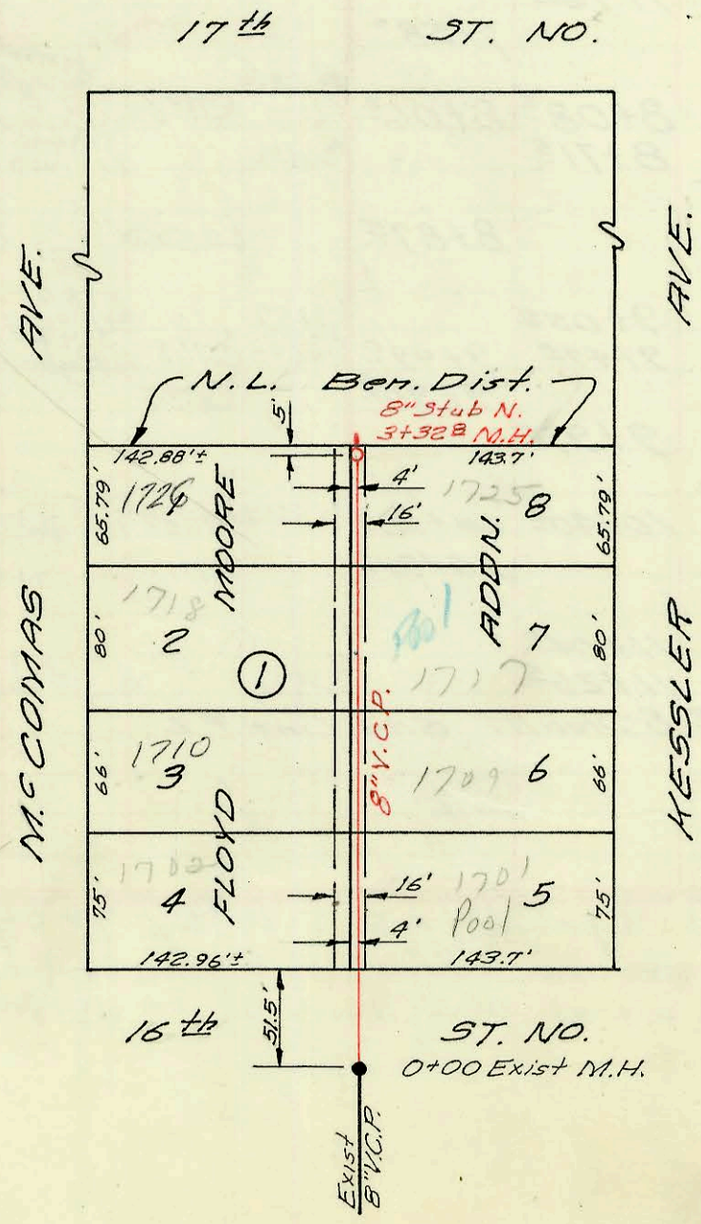

Scale 1" = 100'

LAT. 195, SUB. 5, S.S. 22
UTILITY CONTRACTORS INC.
PROJ. NO. C27-1 (J.K #6) Booked 8-21-67

111

Form 42-020

CONSTRUCTION RECORD							SERVICE RECORD					
STATION	ELEVATION		Depth	MANHOLE	4-INCH "Y" BRANCHES		No. of Permit		House Number		DATE OF PERMITS	
	Ground	Grade			North West	South East	North West	South East	North West	South East	North West	South East
Lat. 43, Sub. 4, S.S. 23												
0+00	131.7	124.90	6.8	Exist. 0+00	Beg. Proj.		C51768 C20179	C51791 C30825	3702 N. Topeka	S.D. 3701 N. Emporia	10-9-75 7-20-70	10-9-75 3772
0+ 1+00	132.0	125.40	6.6		0+68	0+70	C57188 #C4707		3704 N. Topeka	S.D. 3717 N. Emporia	8-12-76 9-5-67	
					1+01	1+03		#C51792 C21844				10-9-75 11-19-70
					1+88	1+86						
2+00	131.8	125.90	5.9		Exist. wye 2+56	2+58	C51758 C4554		S.D. 3722 N. Topeka		10-9-75 8-22-67	
	132.1	126.25	5.8	2+69		2+98						
3+00	131.9	126.40	5.5		3+20							
					3+76		543202 C4632		3740 N. Topeka		3-16-76 8-28-67	
						3+99						
4+00	132.2	126.90	5.3									
					4+57.8	4+40	9683	C51795 C9187	3740 N. Topeka	S.D. 3745 N. Emporia	11-16-83	10-9-75 6-19-68
					4+77	4+79						
5+00	132.3	127.40	4.9									
	132.3	127.60	4.7	5+40								
						5+49		C3568 C9503		3747 N. Emporia	3-1-83	7-9-68
					5+85		C59922		3750 N. Topeka		2-15-77	
						5+92						
6+00	132.4	127.90	4.5			6+07		C20666		3763 N. Emporia	(add.)	8-24-70
	132.3	128.10	4.2	6+39	4" Stub N.W.	4" Stub N.E.	C11651	C11344	3760 N. Topeka	3763 N. Emporia	11-22-68	11-7-68
Lat. 195, Sub. 5, S.S. 22												
0+00	127.0	120.57	6.4	Exist. 0+00								
					0+72	0+70	#C17881	C13246	1702 N. McComas	1701 N. Kessler	2-5-70	3-24-69
1+00	128.4	120.77	7.6									
					1+60	1+62		#C11171		1709 N. Kessler		10-30-68
2+00	128.9	120.97	7.9									
					2+25	2+27		C9854		1717 N. Kessler		7-30-68
					2+83	2+85	C7393		1726 N. McComas		3-20-68	
3+00	128.2	121.17	7.0			2+96		C22816		1725 N. Kessler		2-2-71
	128.9	121.24	7.7	3+32	8" Stub N.							
Lat 119, Main 4, S.S. #23												
0+00	133.03	125.93	7.1	0+00								
1+00	132.5	126.28	6.2									
	132.67	126.47	6.2	1+54.3								